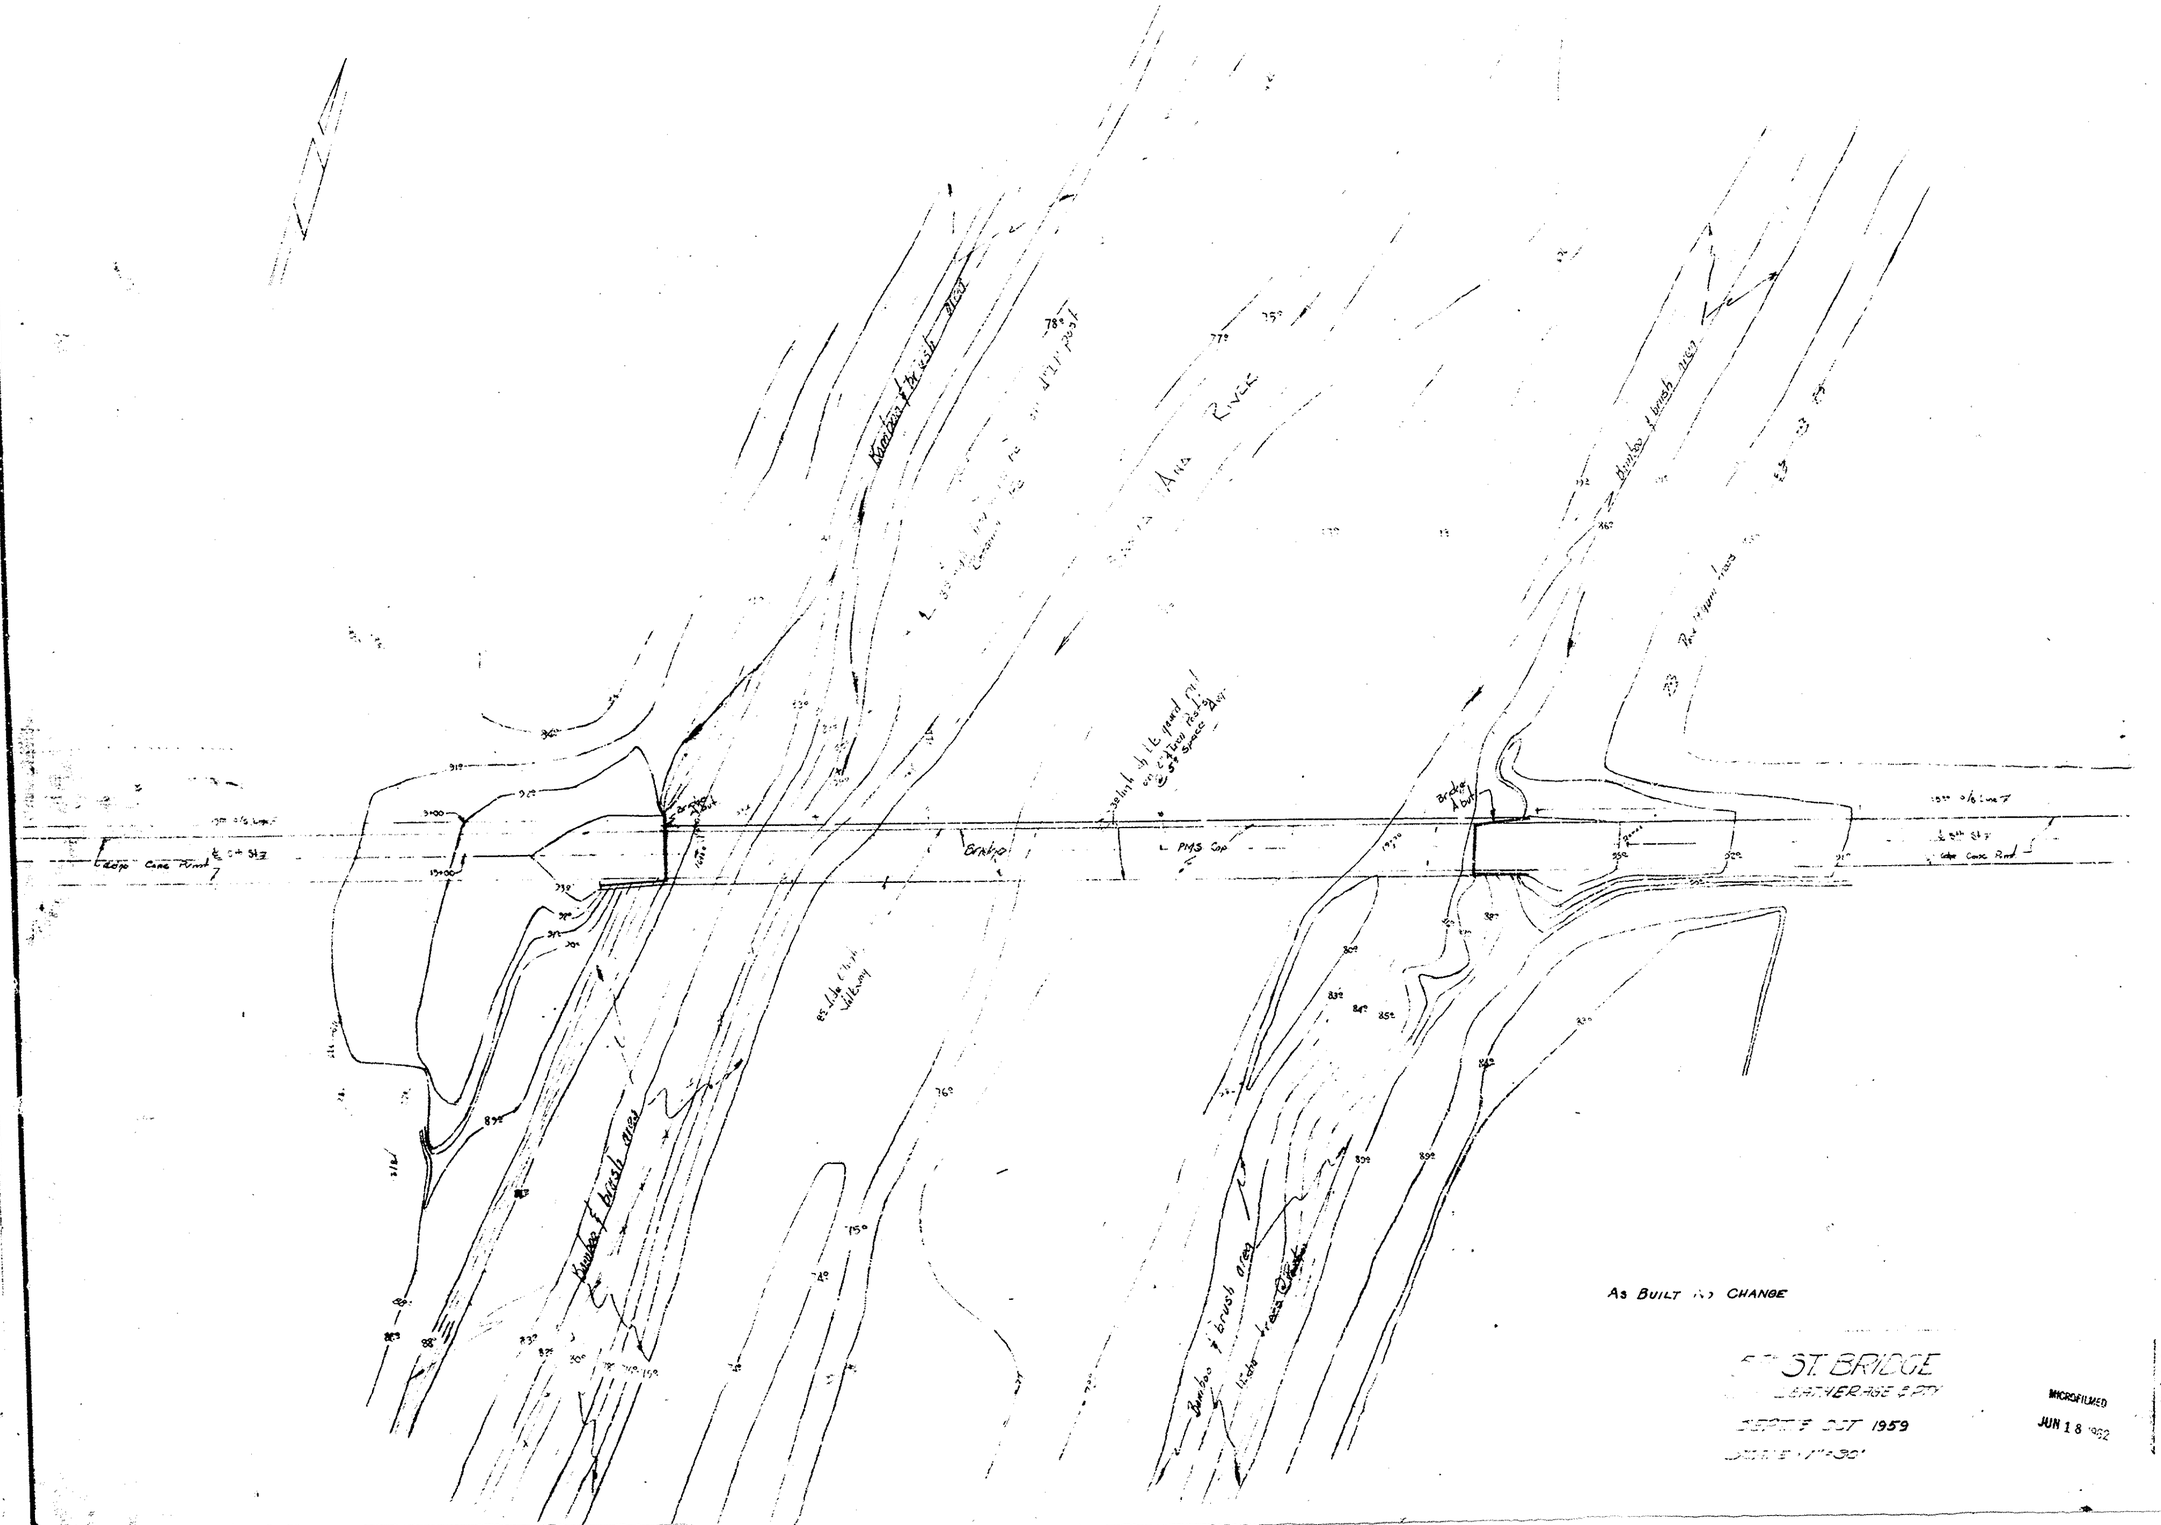

5TH ST. BRIDGE
GATHERAGE & PTY
SEPT 5 OCT 1959
SCALE 1" = 30'

MICROFILMED
JUN 18 1992

BRIDGE SA 25
FIFTH STREET BRIDGE
ACROSS SANTA ANA RIVER
SHEET 19A
RED 22.5:1 SCALE 1"=30'
