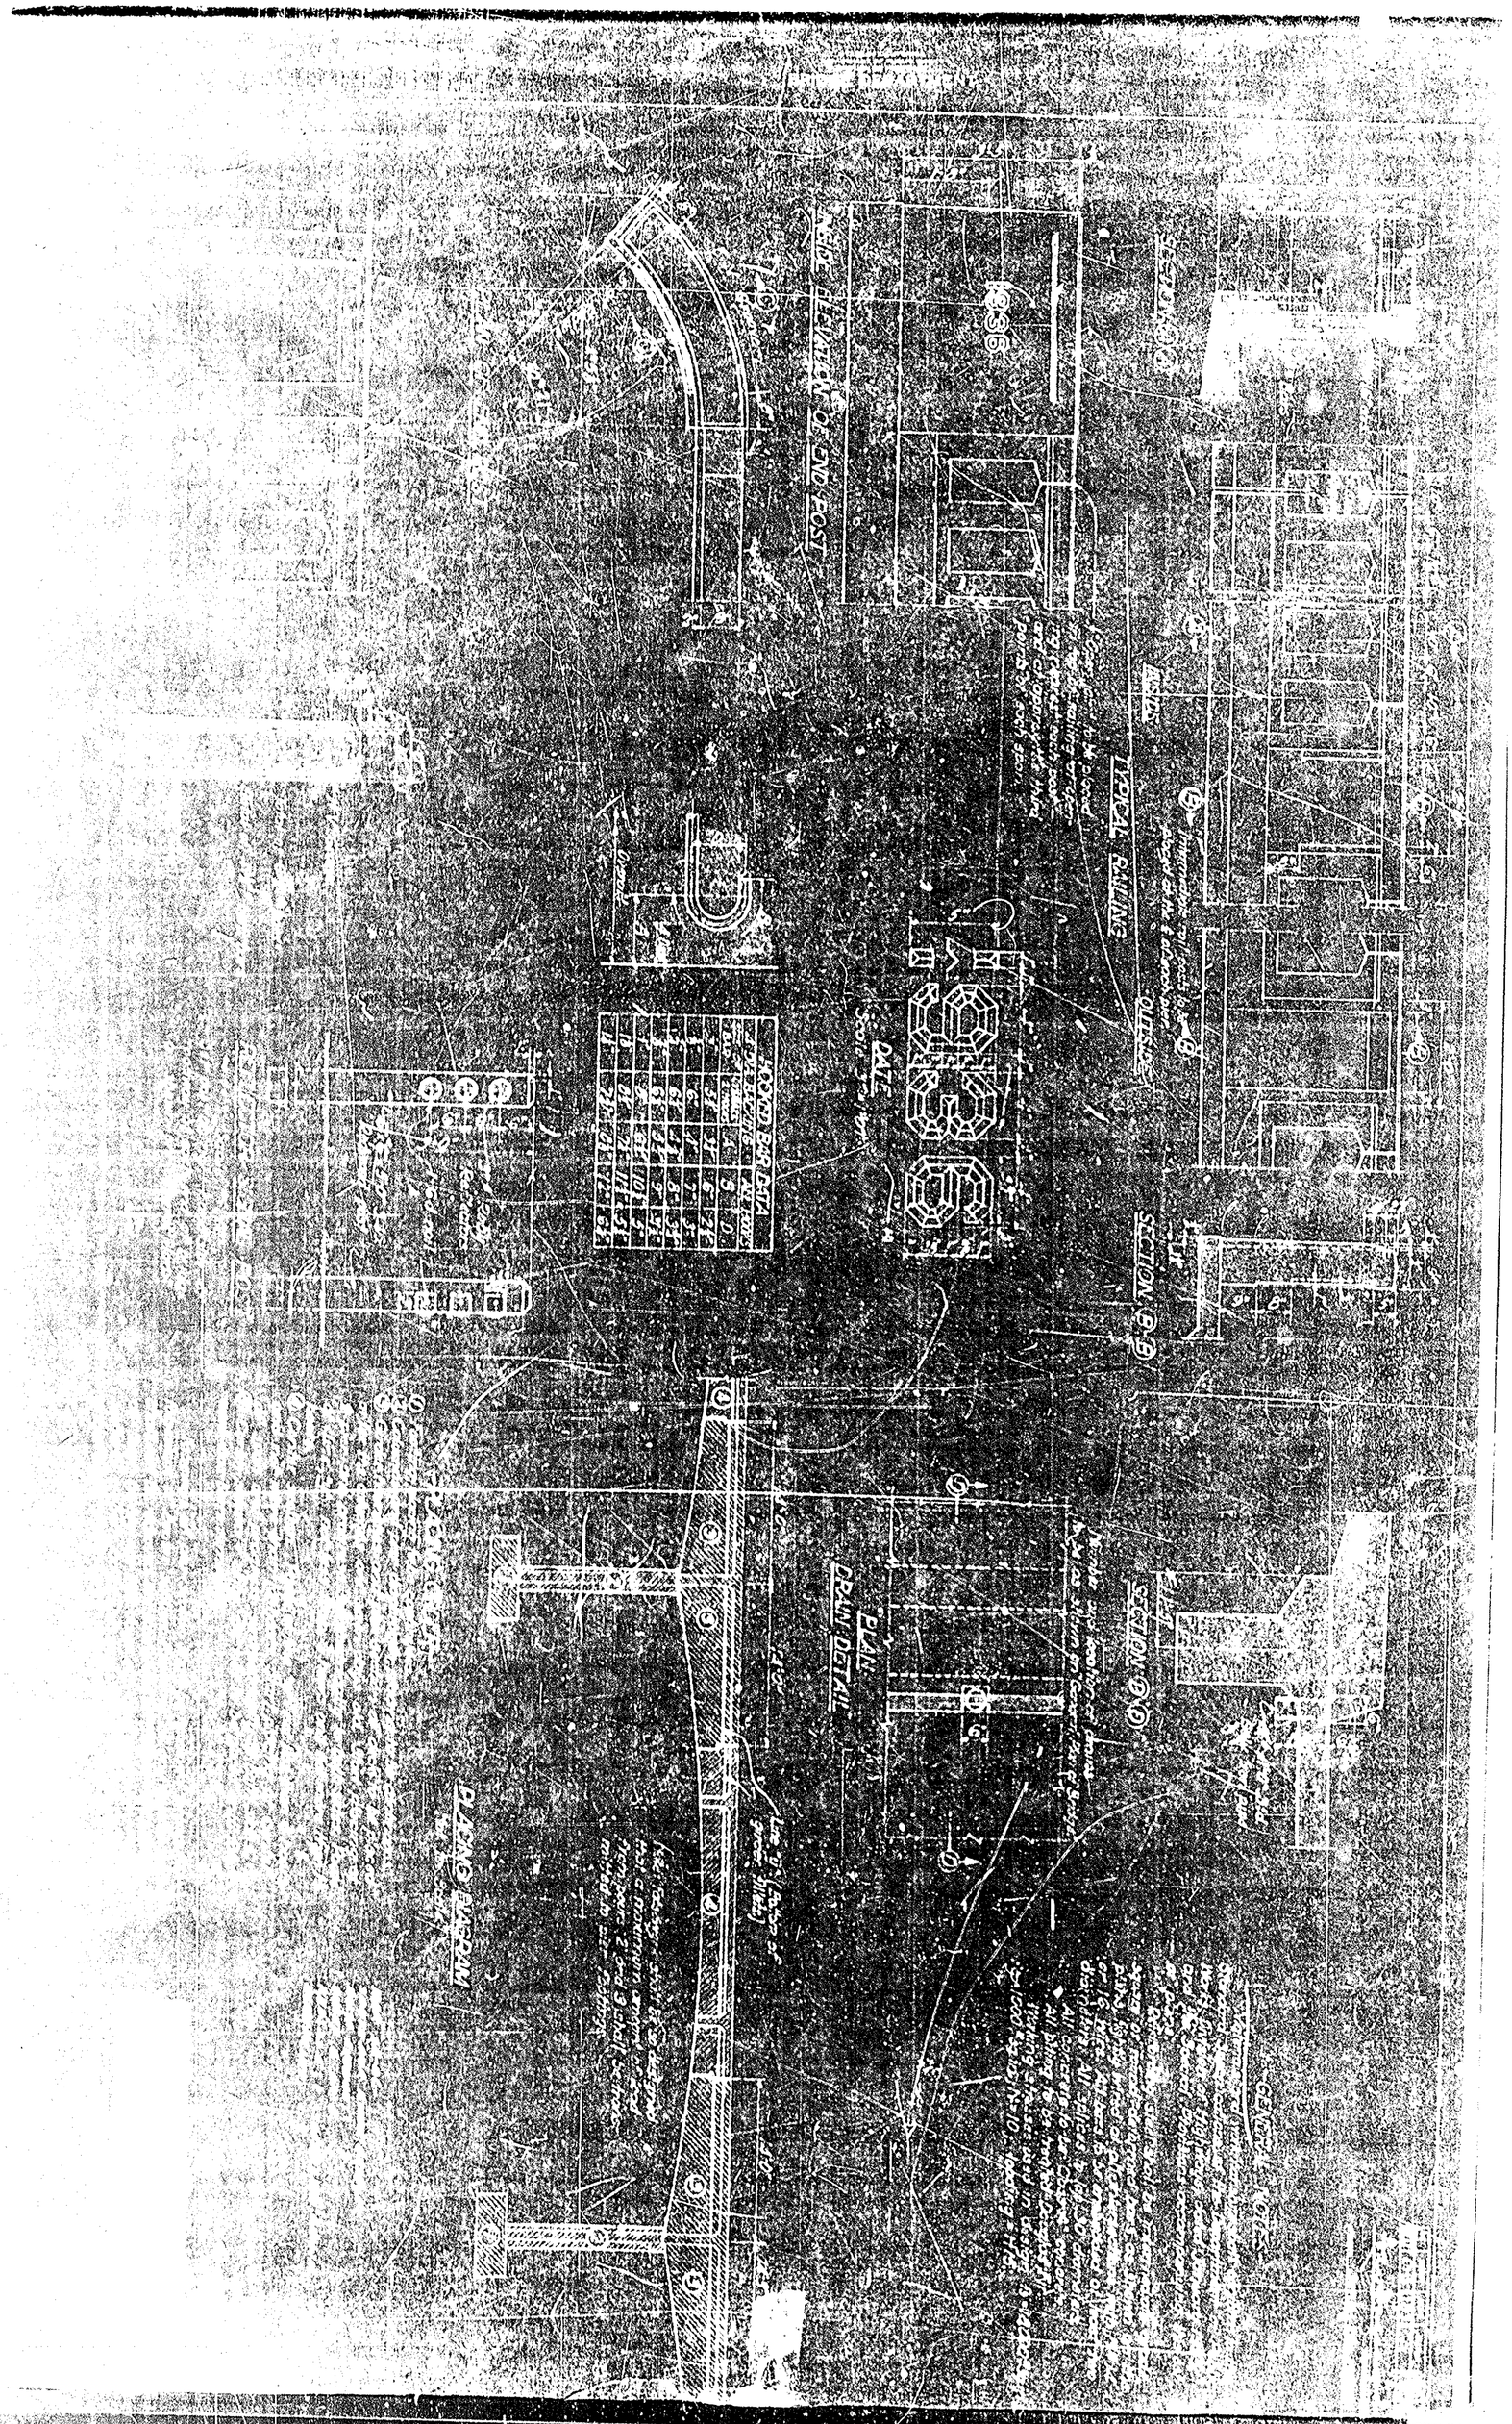
PLAN
SECTION
SECTION
TYPICAL BAILING
NEW ELEVATION OF CNO POST
PLAN
PLAN
PLAN
SECTION
SECTION
SECTION