


SECTION A-A

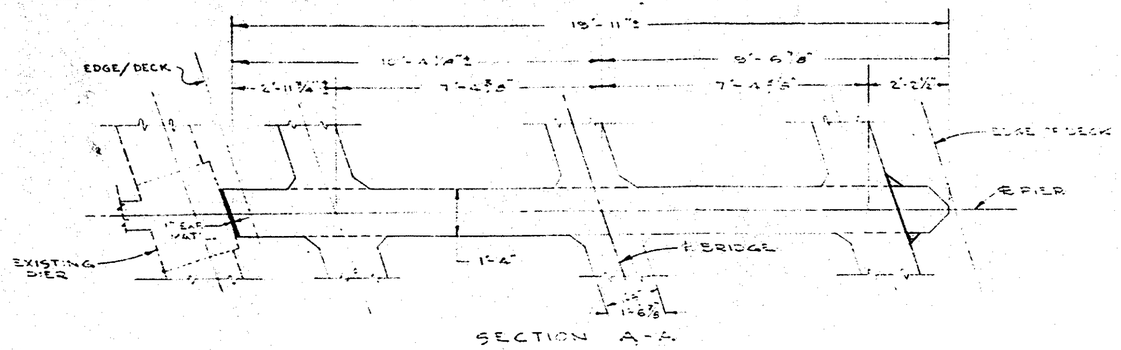


TYPICAL PIER DETAIL

SECTION B-B




SECTION C-C

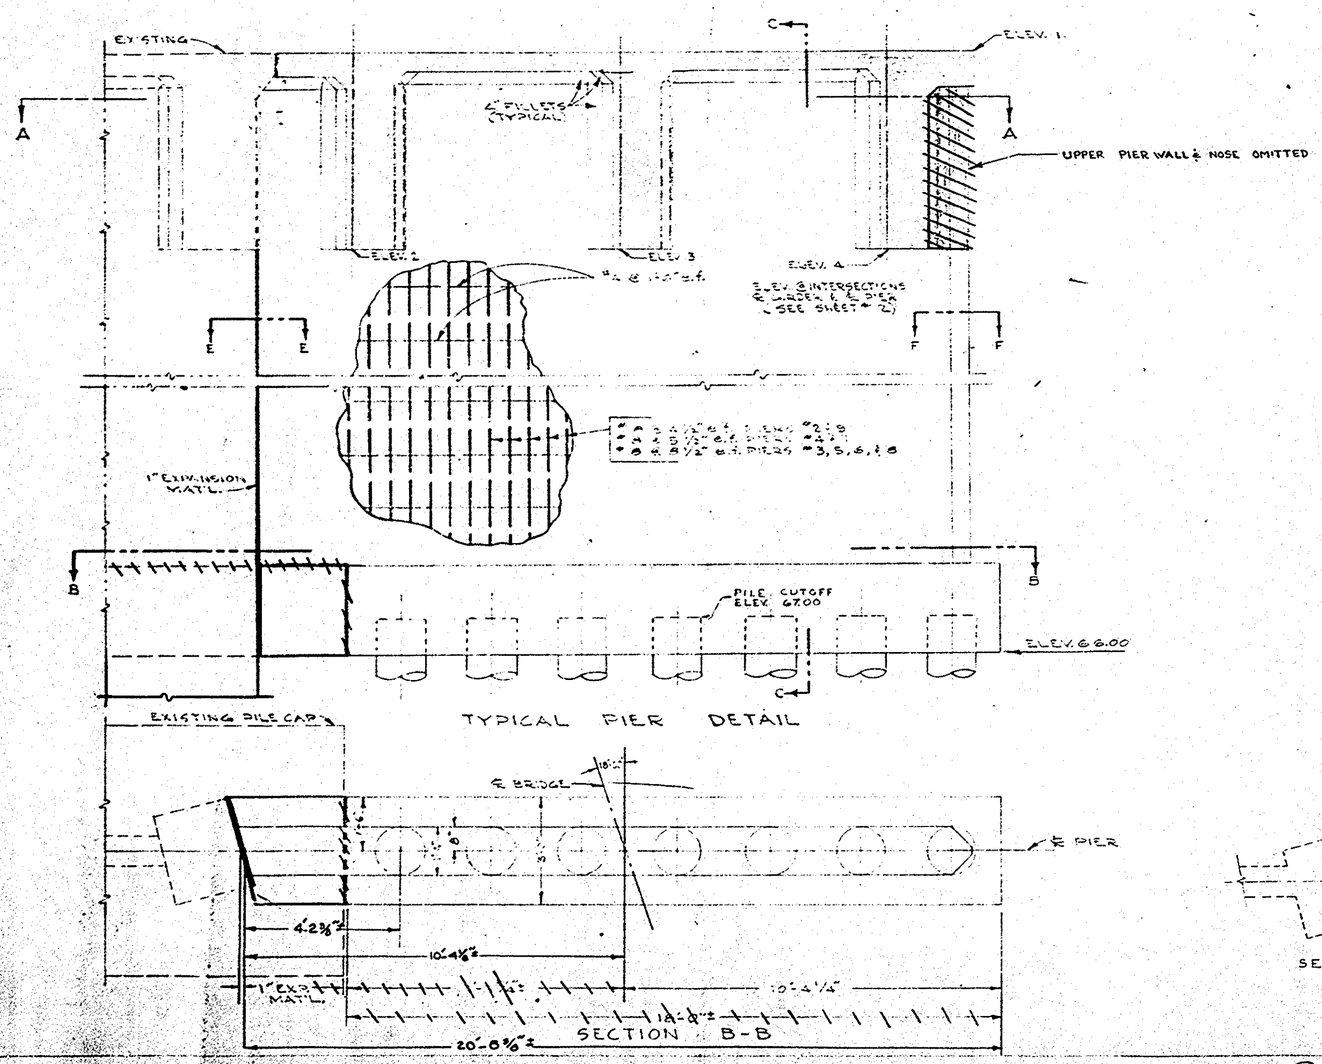


SECTION E-E

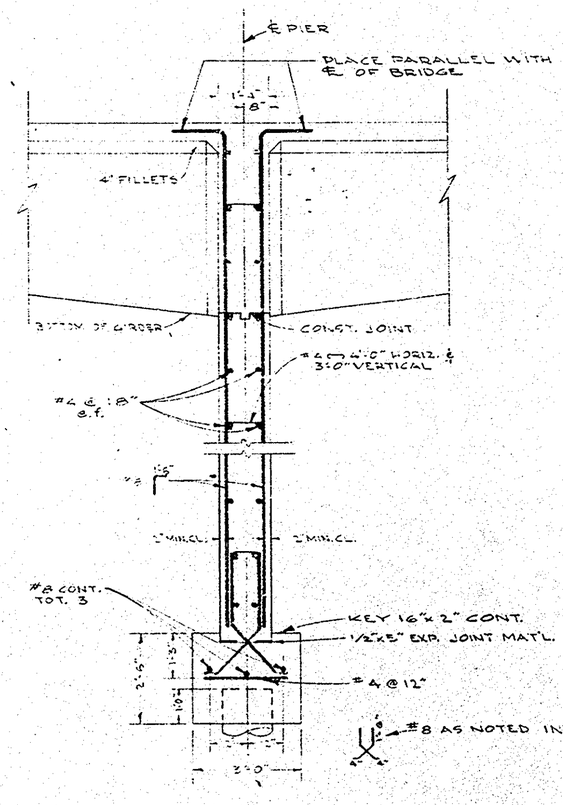


SECTION F-F

SA-26
Bolsa Ave Bridge-As Built
over Santa Ana River
Sheet 4 of 11
Red 22.5:1 Scale As Shown
Blackline Print

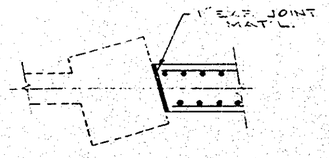MICROFILMED
JUN 18 1962

ORANGE COUNTY HIGHWAY DEPARTMENT

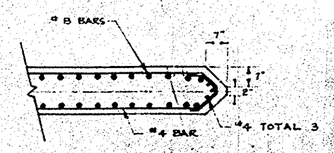BOLSA AVE. BRIDGE
ACROSS SANTA ANA RIVER

PIER DETAIL

DRAWN BY:
CHECKED BY:
APPROVED:
DATE:

SCALE: 1/4" = 1'-0"

SHEET 4 OF 11

SA-26