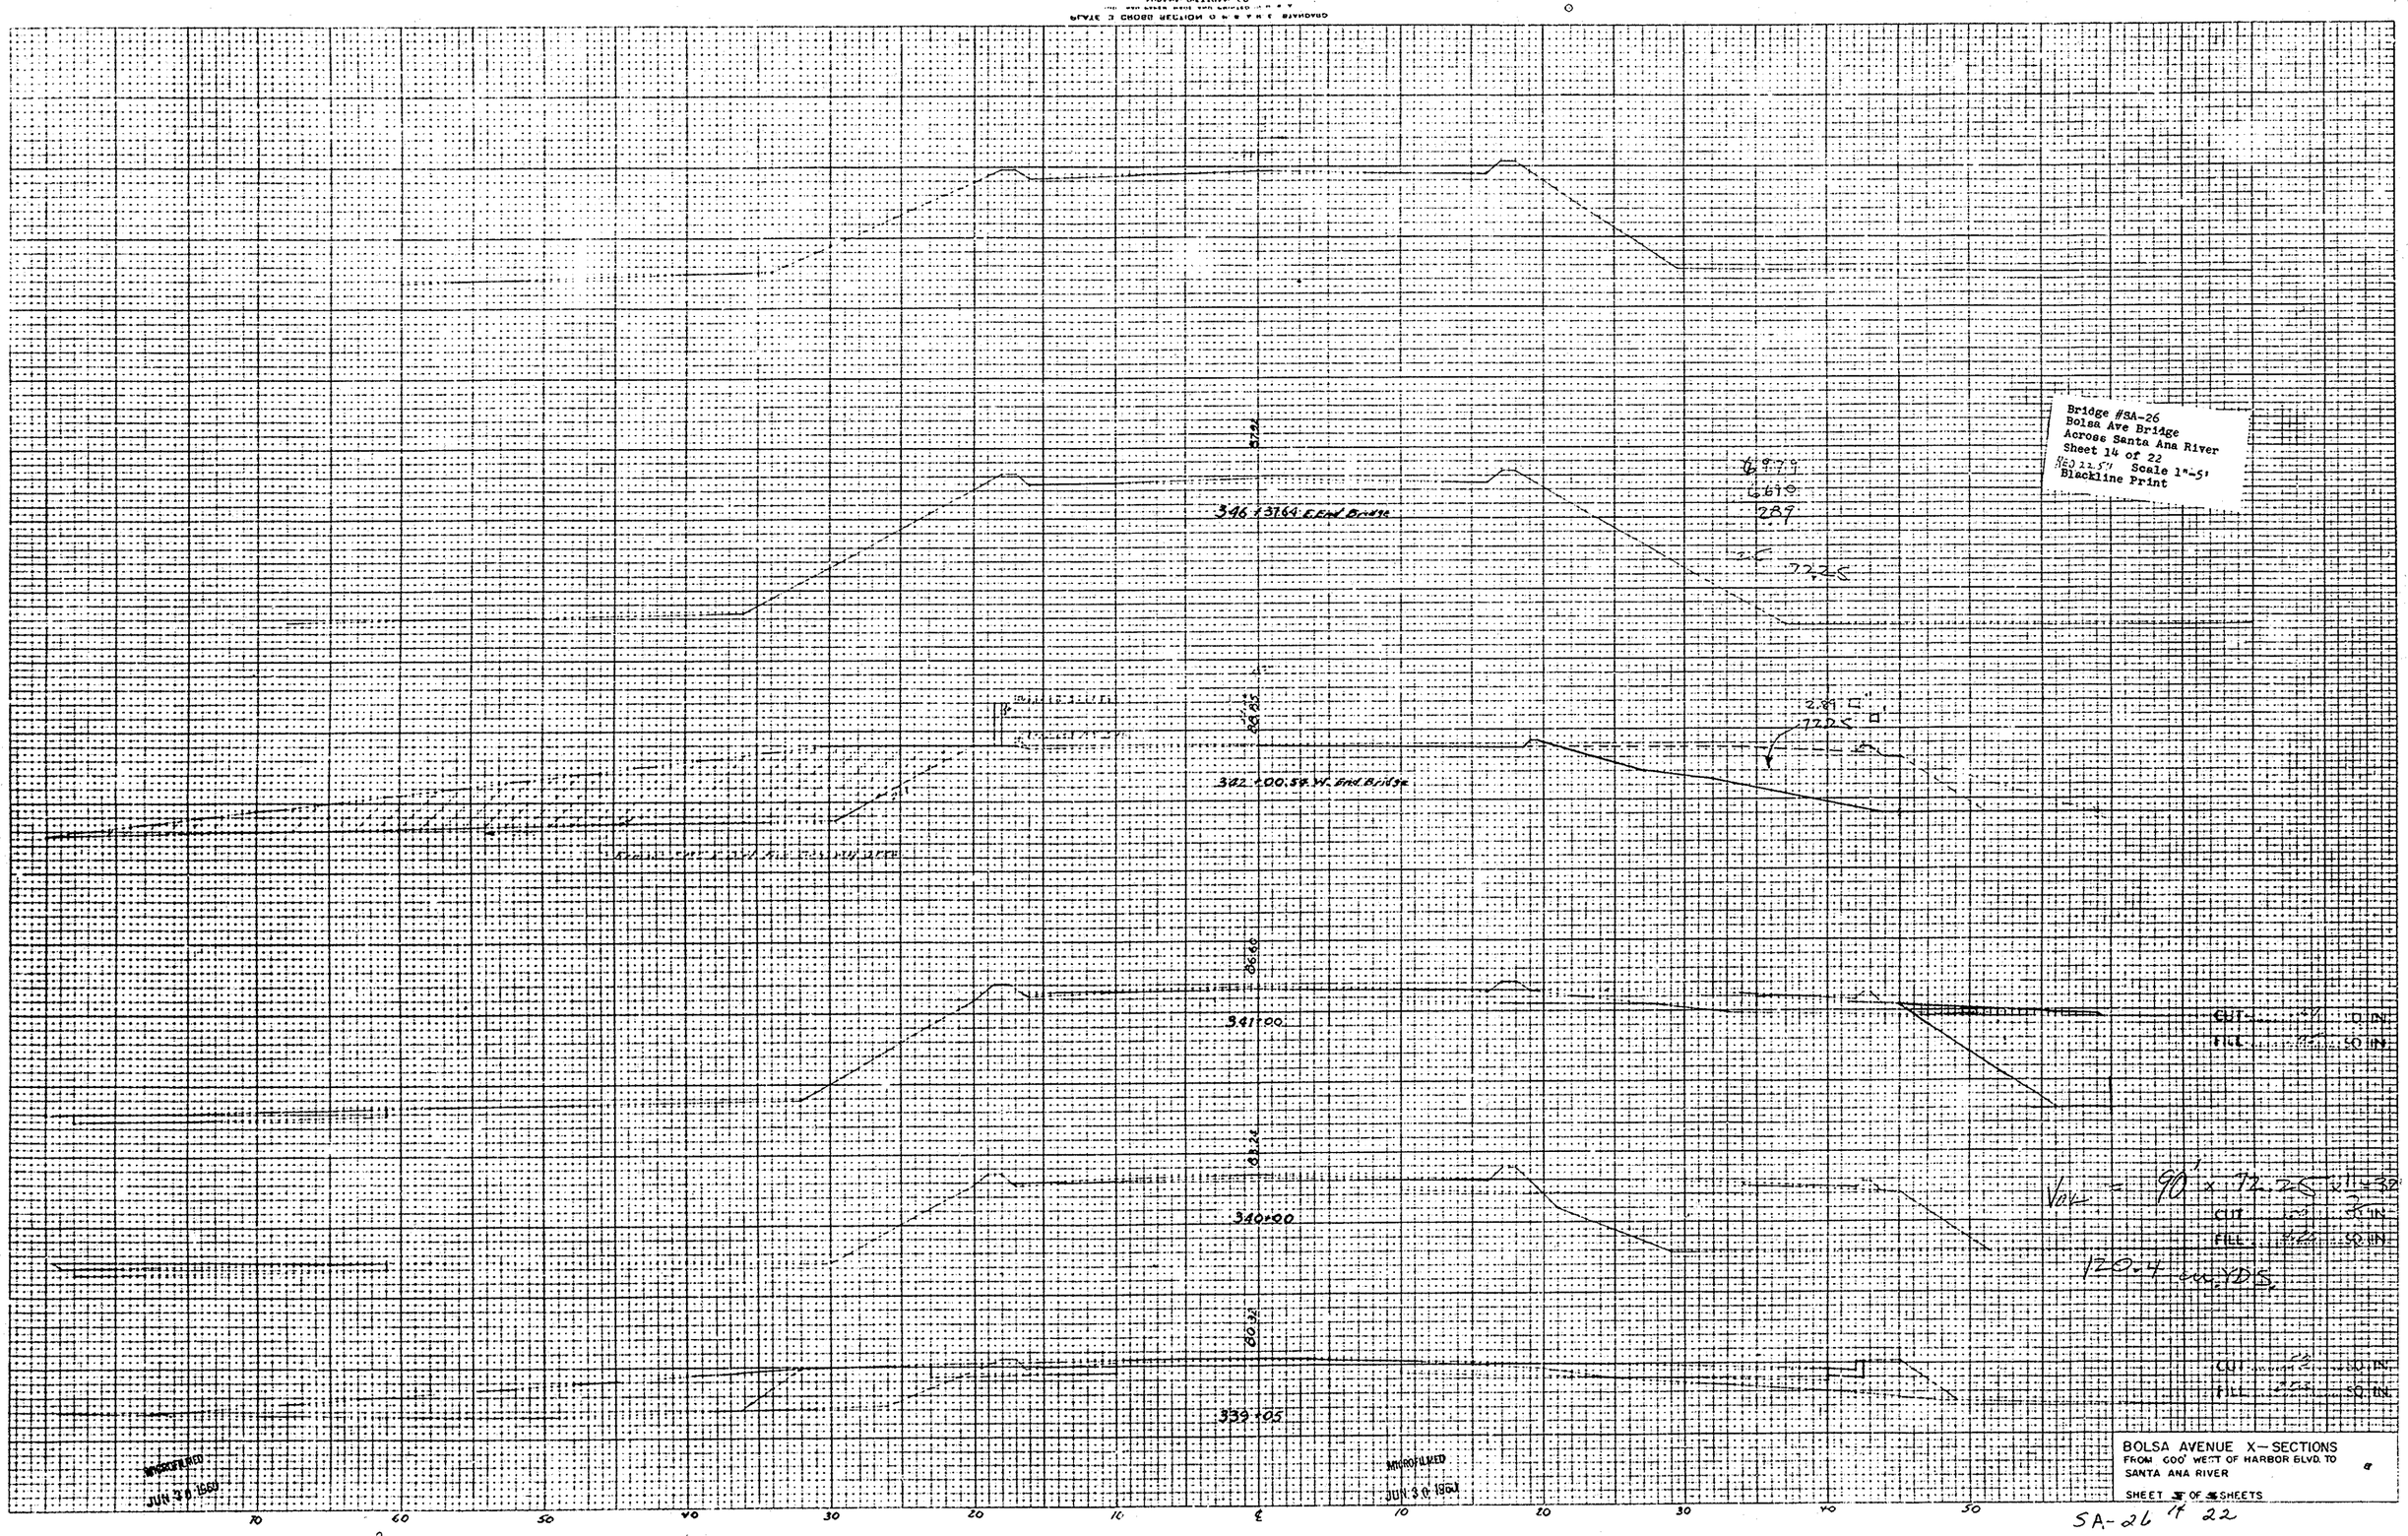
Bridge #SA-26
Bolsa Ave Bridge
Across Santa Ana River
Sheet 14 of 22
Scale 1"=5'
Blackline Print
346+37.64 E End Bridge
342+00.59 W. End Bridge
341+00
340+00
339+05
CUT 0 IN
FILL 50 IN
CUT 0 IN
FILL 50 IN
CUT 0 IN
FILL 50 IN
BOLSA AVENUE X-SECTIONS
FROM 600' WEST OF HARBOR BLVD. TO
SANTA ANA RIVER
SHEET OF SHEETS
MICROFILMED
JUN 30 1960
MICROFILMED
JUN 30 1960

SA-26 14 22