EXACT®
EXACT LEVEL & TOOL MFG. CO., INC. HIGH BRIDGE, N. J., U. S. A.
STRAIGHT EDGE RULE SE-48

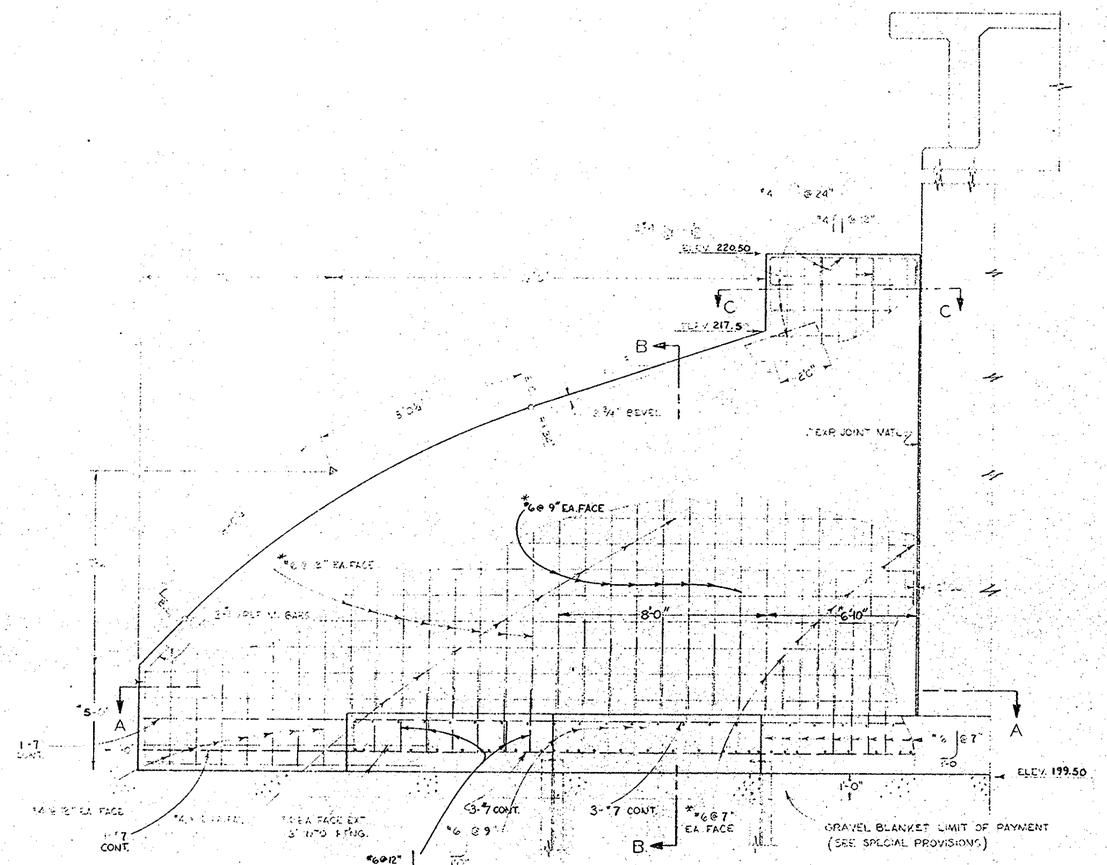

TYPICAL PIER EXTENSION DETAILS
*NO SCALE

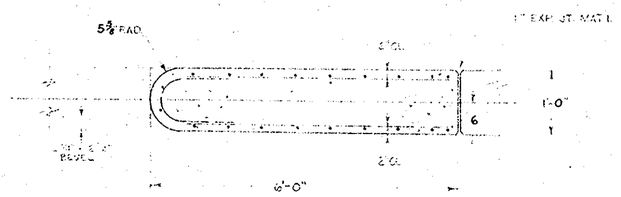

SECTION C-C
SCALE 3/4"=1'-0"

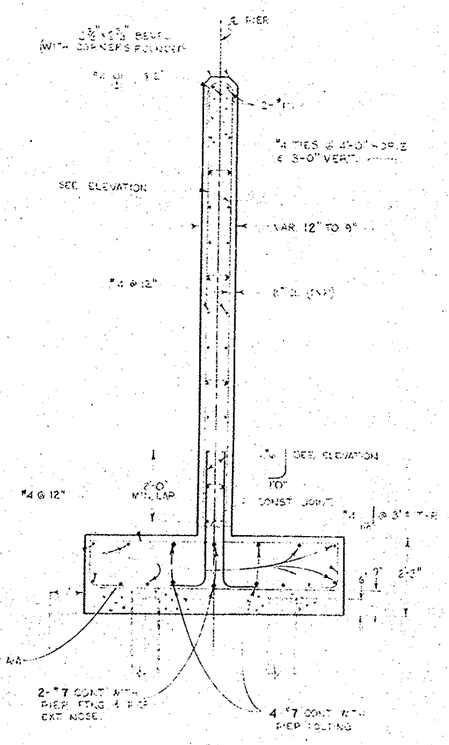

SECTION B-B
SCALE—1/2"=1'-0"

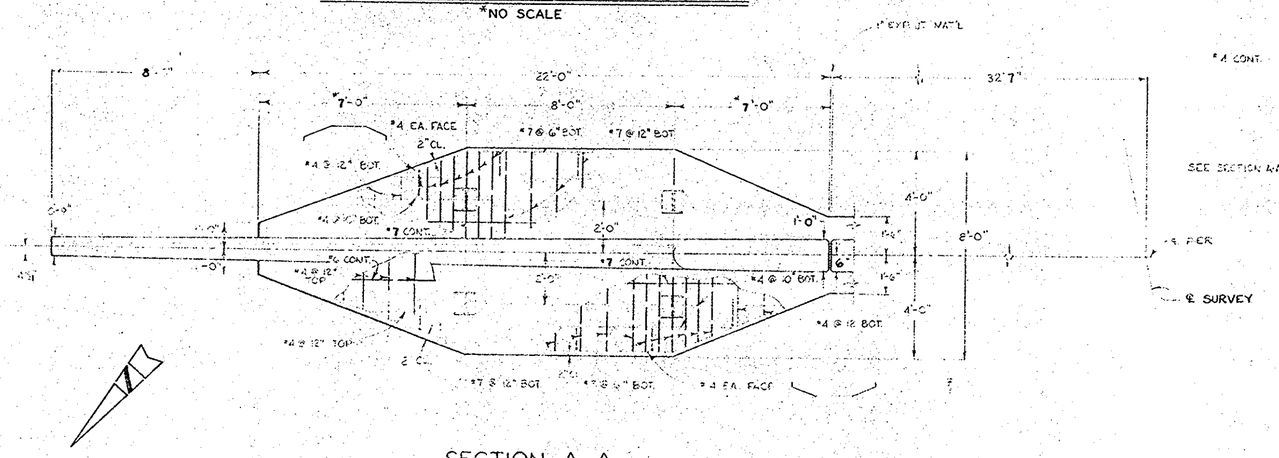

SECTION A-A
*NO SCALE

AS BUILT

ORANGE COUNTY ROAD DEPARTMENT
GLASSELL STREET
BRIDGE SA-8A
ACROSS
SANTA ANA RIVER
PIER EXTENSION DETAILS
(PIERS #3-#8)
AS NOTED
Sheet 7 of 15