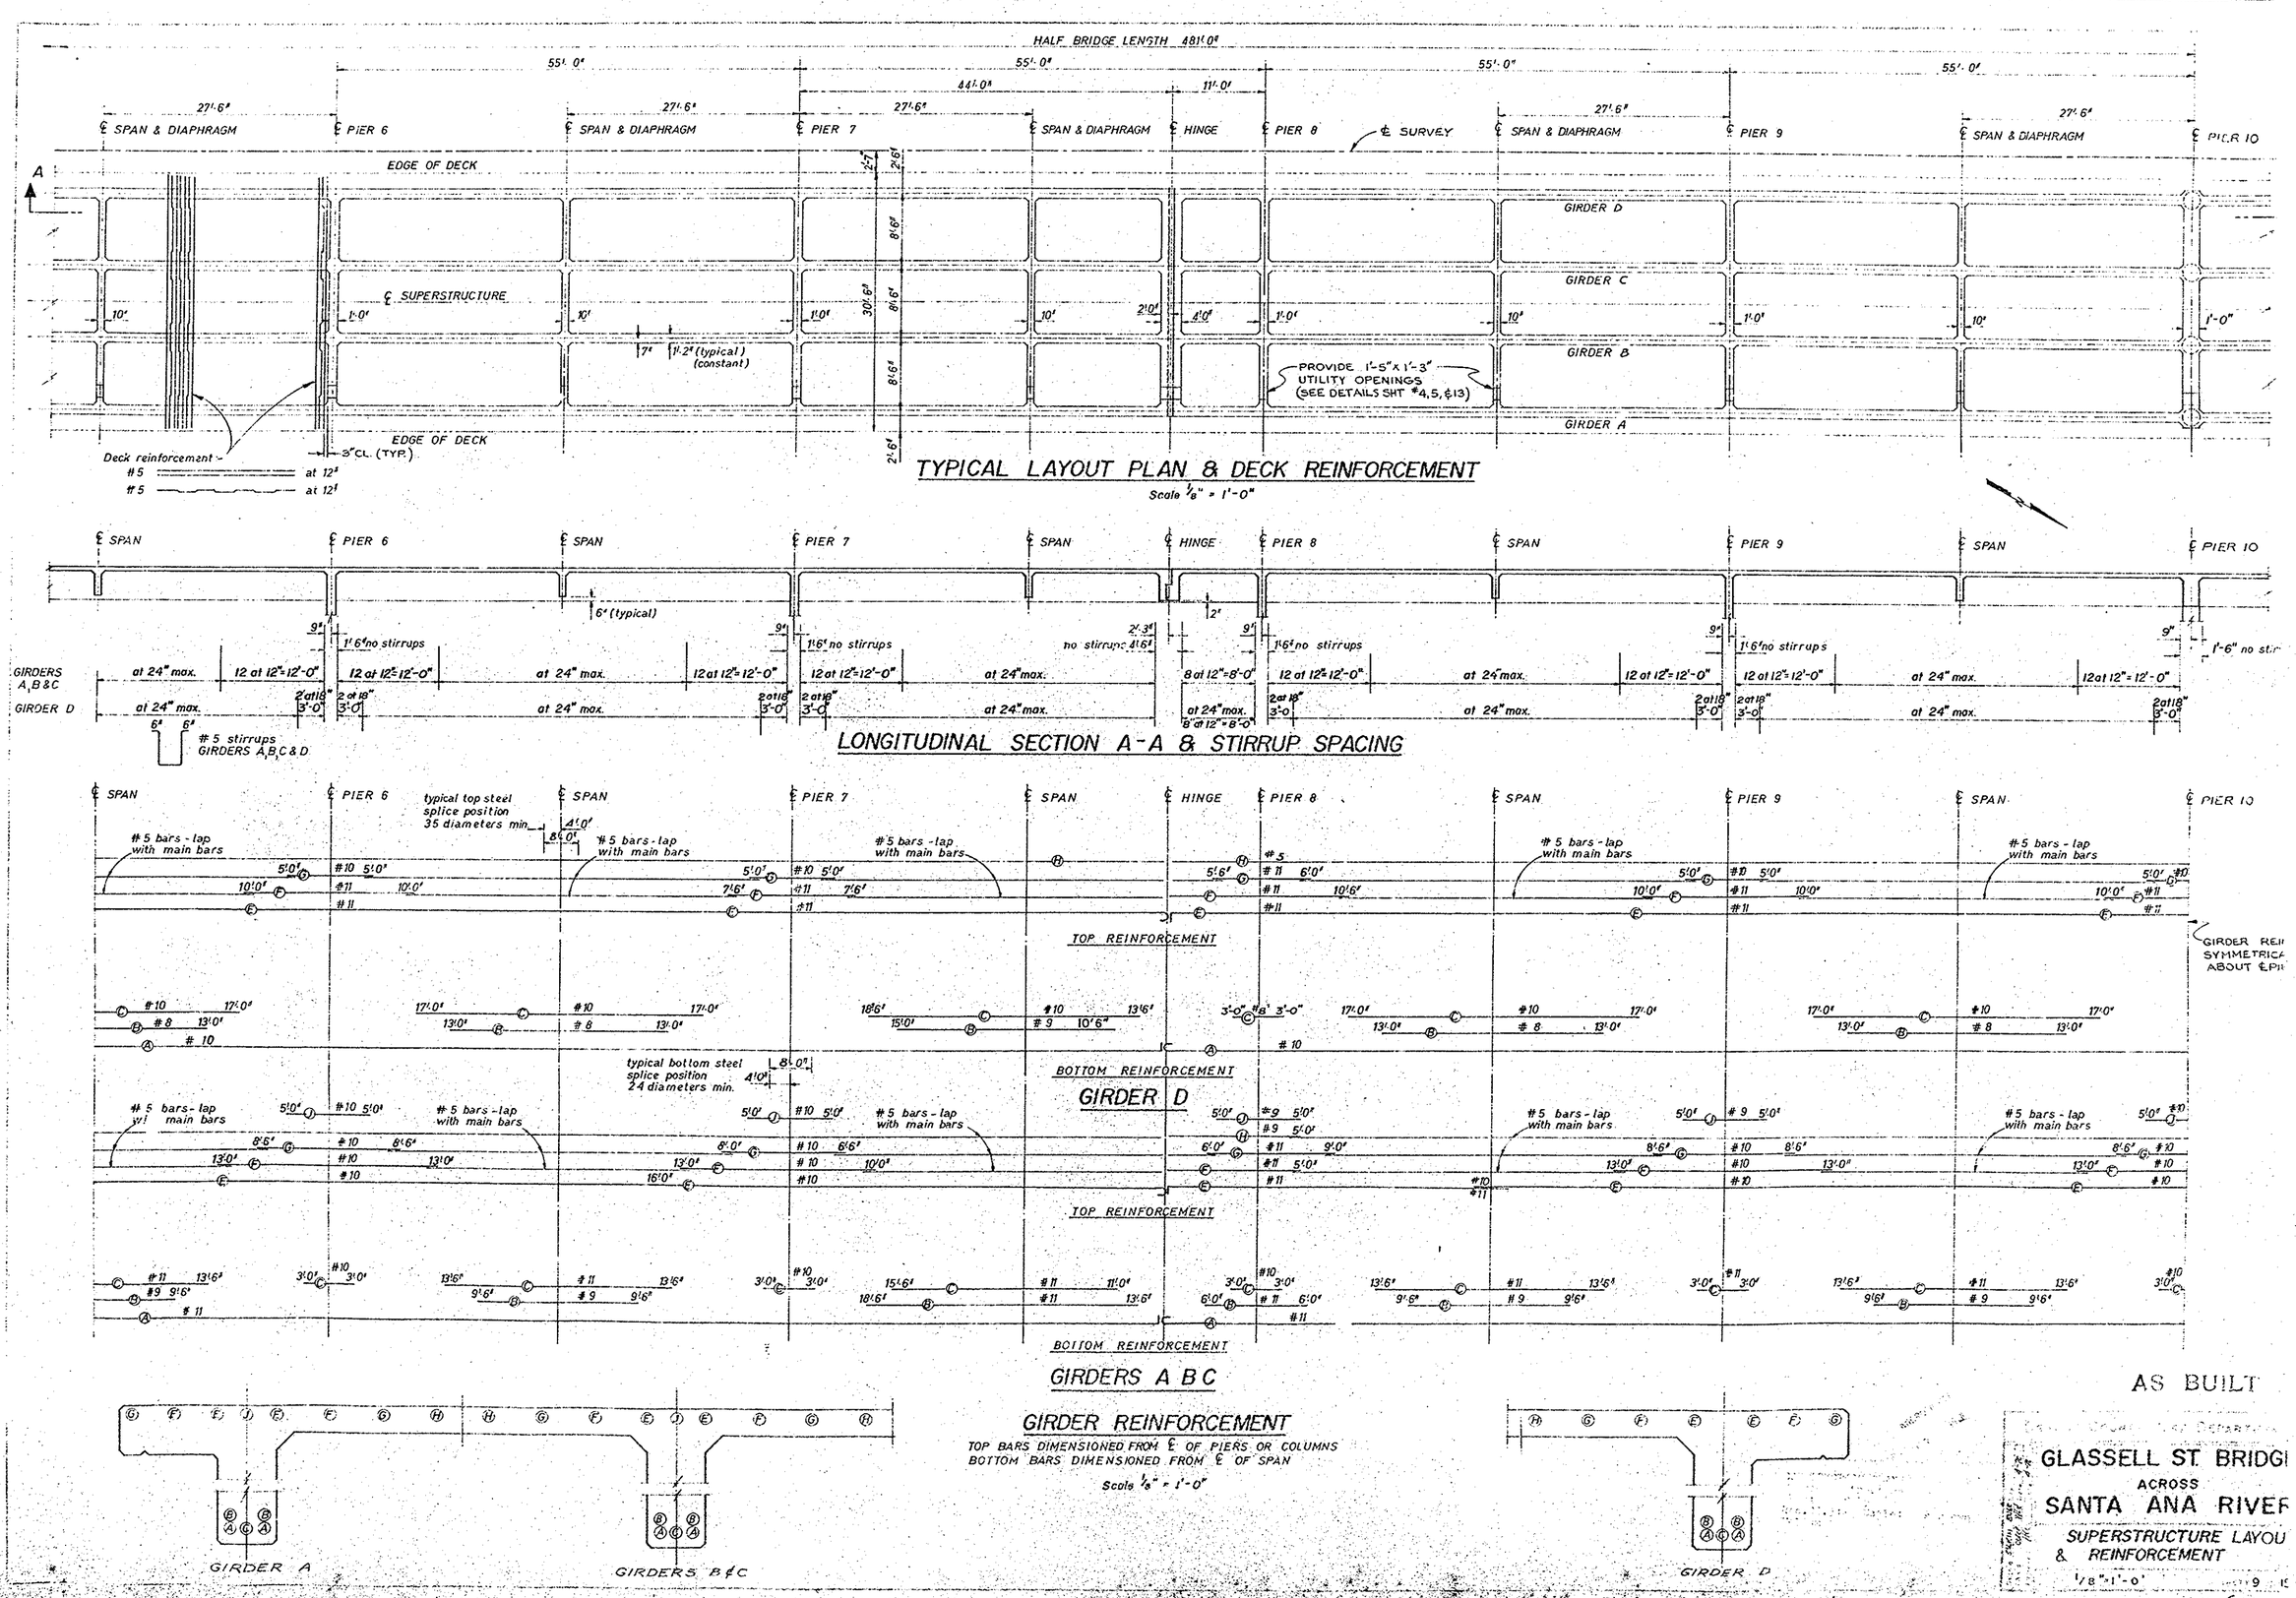

AS BUILT

GLASSELL ST. BRIDGE
ACROSS
SANTA ANA RIVER
SUPERSTRUCTURE LAYOUT & REINFORCEMENT
1/8"=1'-0"

DR 7(1034