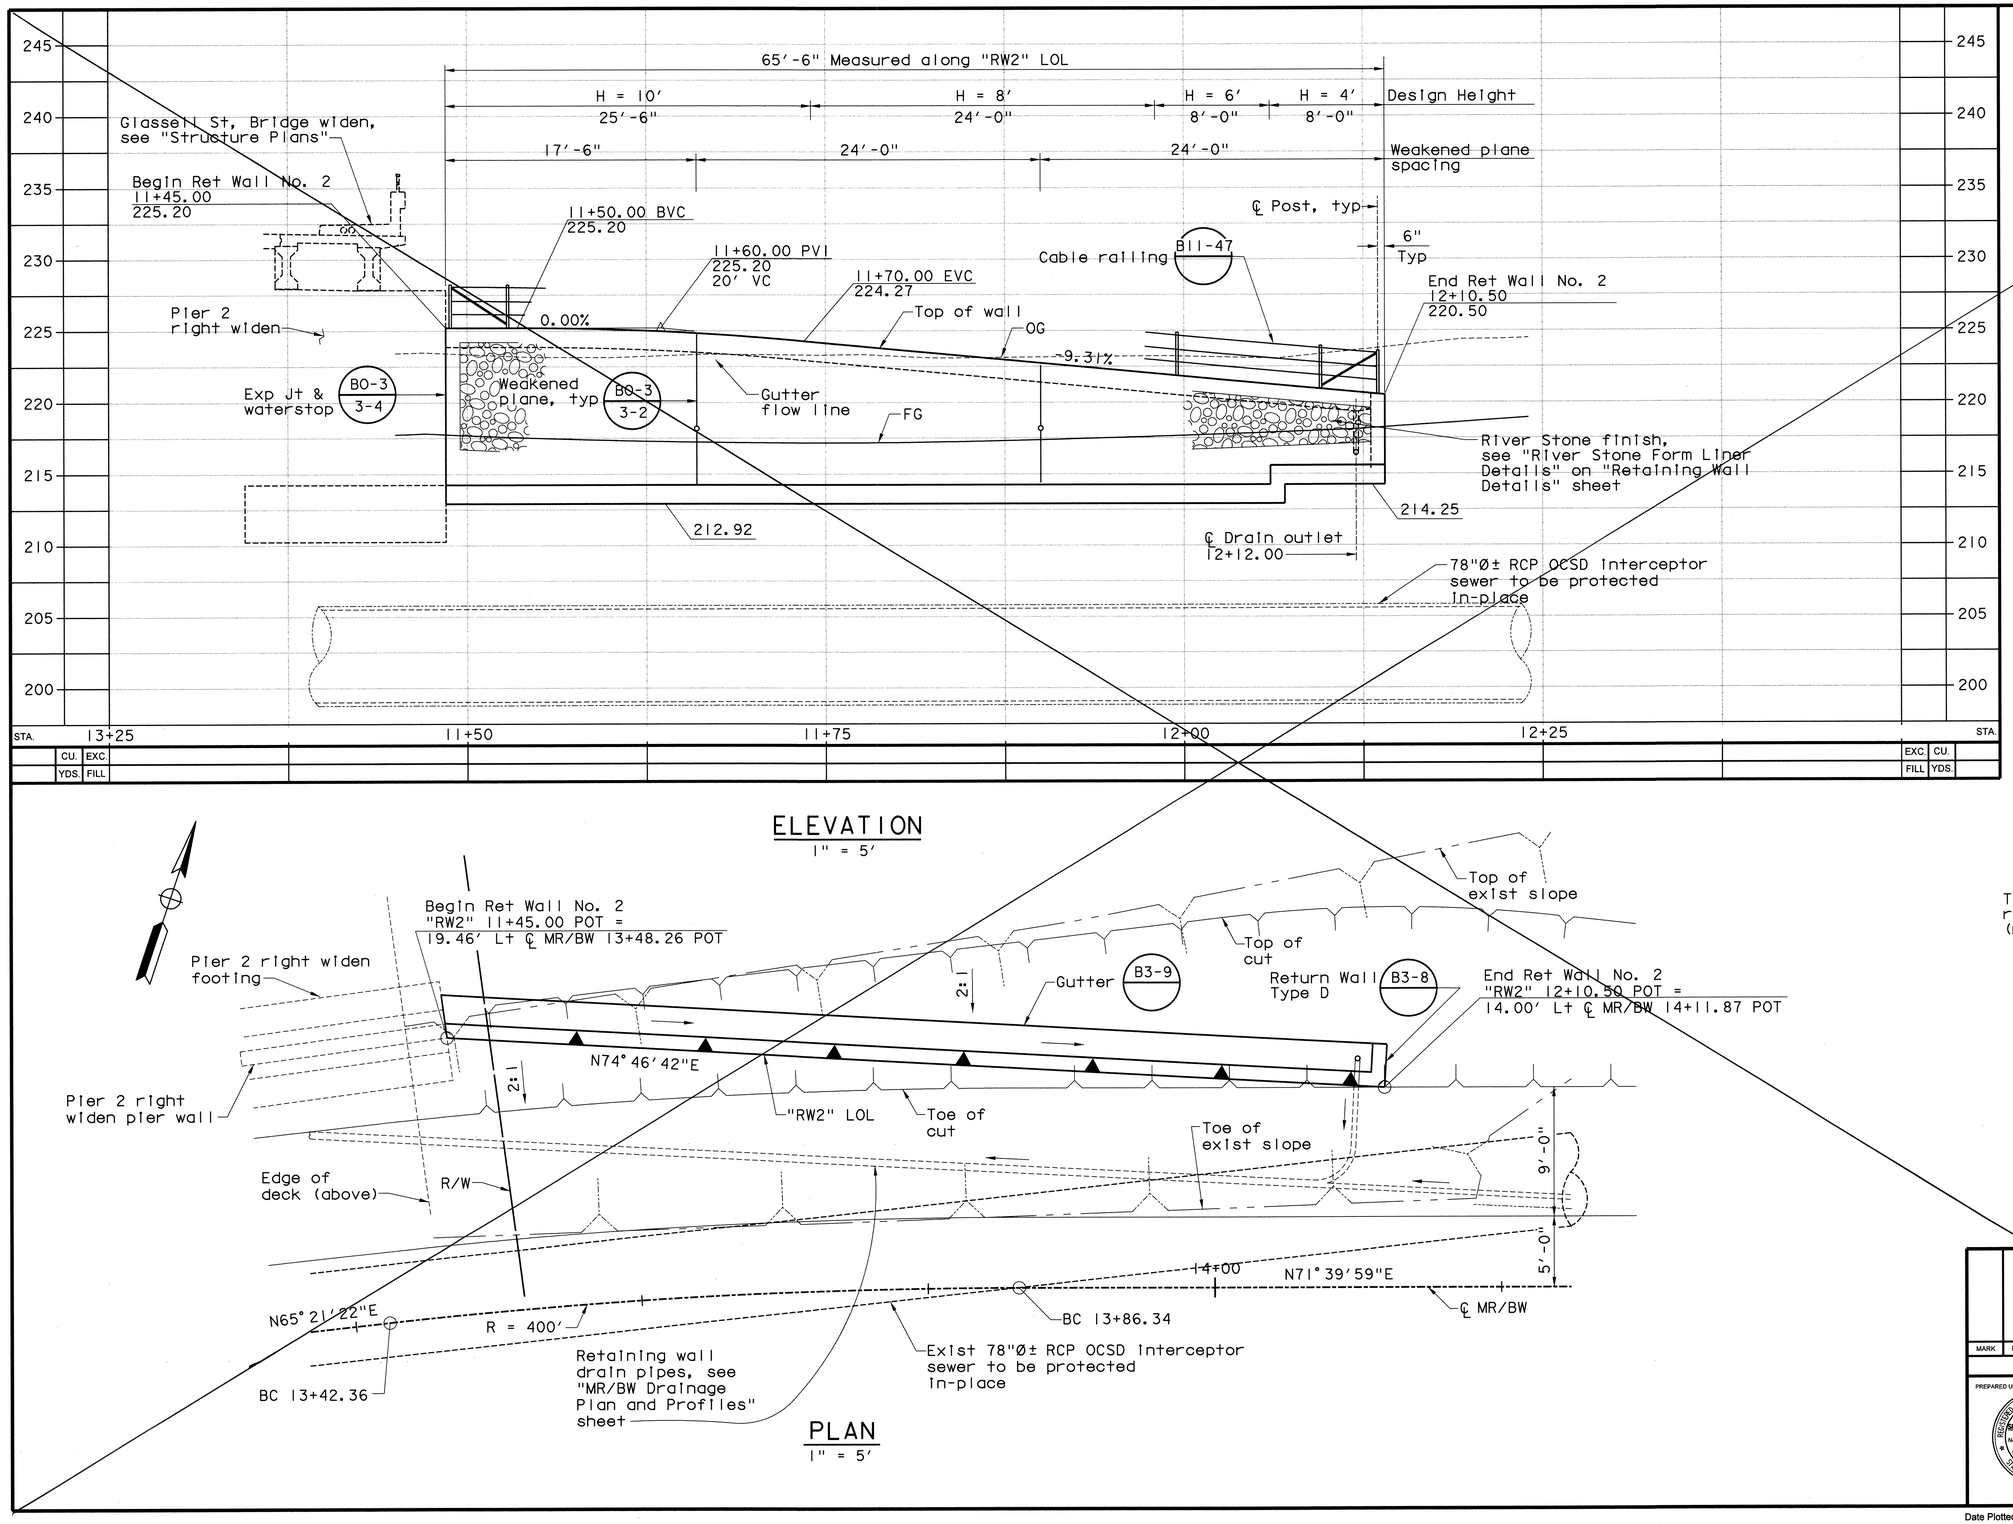

ELEVATION
1" = 5'

SUPERSEDED AND REPLACED BY SHEET 15R.

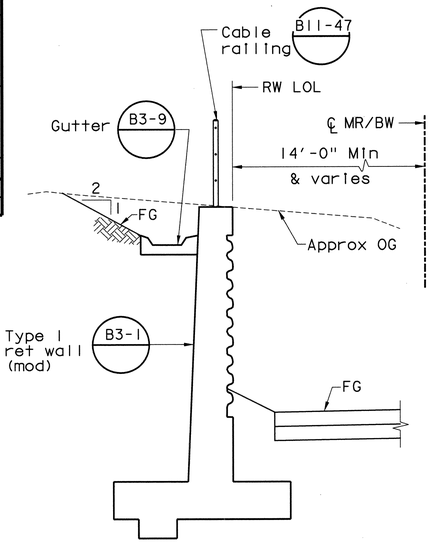

TYPICAL SECTION
No Scale

PLAN
1" = 5'

W. Koo & Associates, Inc.
600 The City Parkway West, Suite 310
Orange CA. 92868
PH: (714) 456-0280
FAX: (714) 456-0295

MARK	DATE	DESCRIPTION

REVISIONS

PREPARED UNDER RESPONSIBLE CHARGE OF:

REGISTERED PROFESSIONAL ENGINEER
SHAFI M. SHARIFIAN
No. CE 49697
EXP. 9-30-04
CIVIL
STATE OF CALIFORNIA

7/19/02
DATE

ORANGE COUNTY
PUBLIC FACILITIES AND RESOURCES DEPARTMENT

GLASSELL STREET BRIDGE WIDENING
OVER SANTA ANA RIVER

RETAINING WALL NO. 2
STRUCTURE PLAN

DESIGNED G. BUELOW
DRAWN G. BUELOW
CHECKED S. SHARIFIAN
SCALE AS SHOWN
DATE 7/19/02
DRAWING NO.
SHEET 15 OF 70

Date Plotted: 07/17/02

File Name: i:\010-14\glassell\rw2_pp.dgn