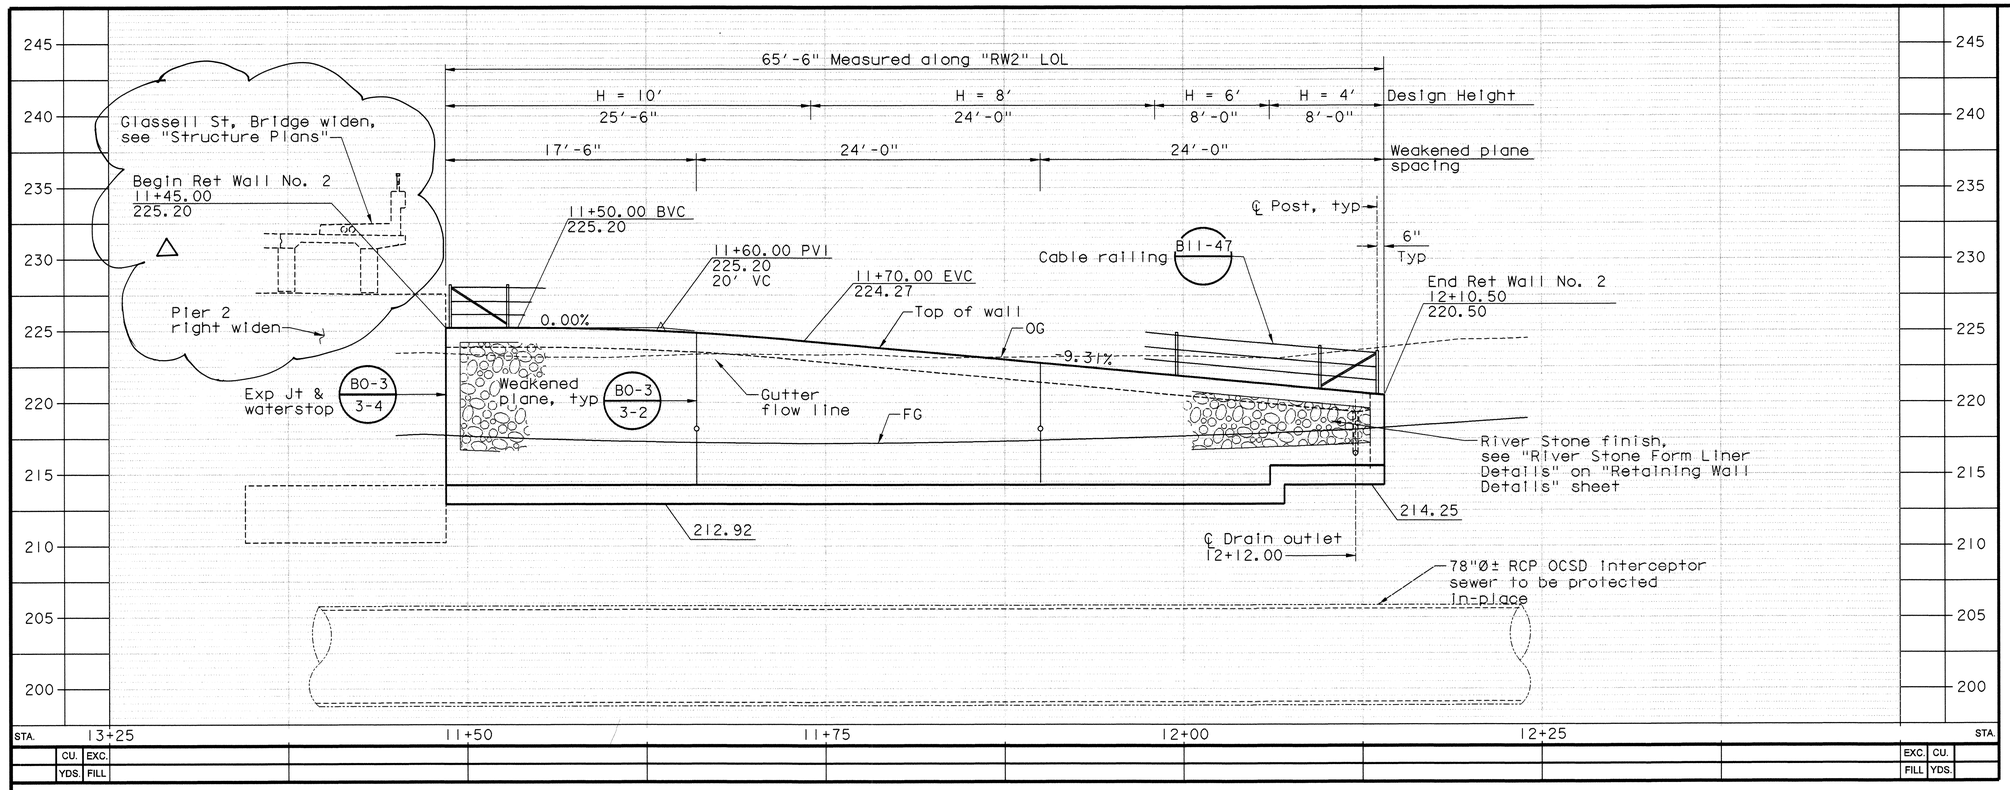

ELEVATION

1" = 5'

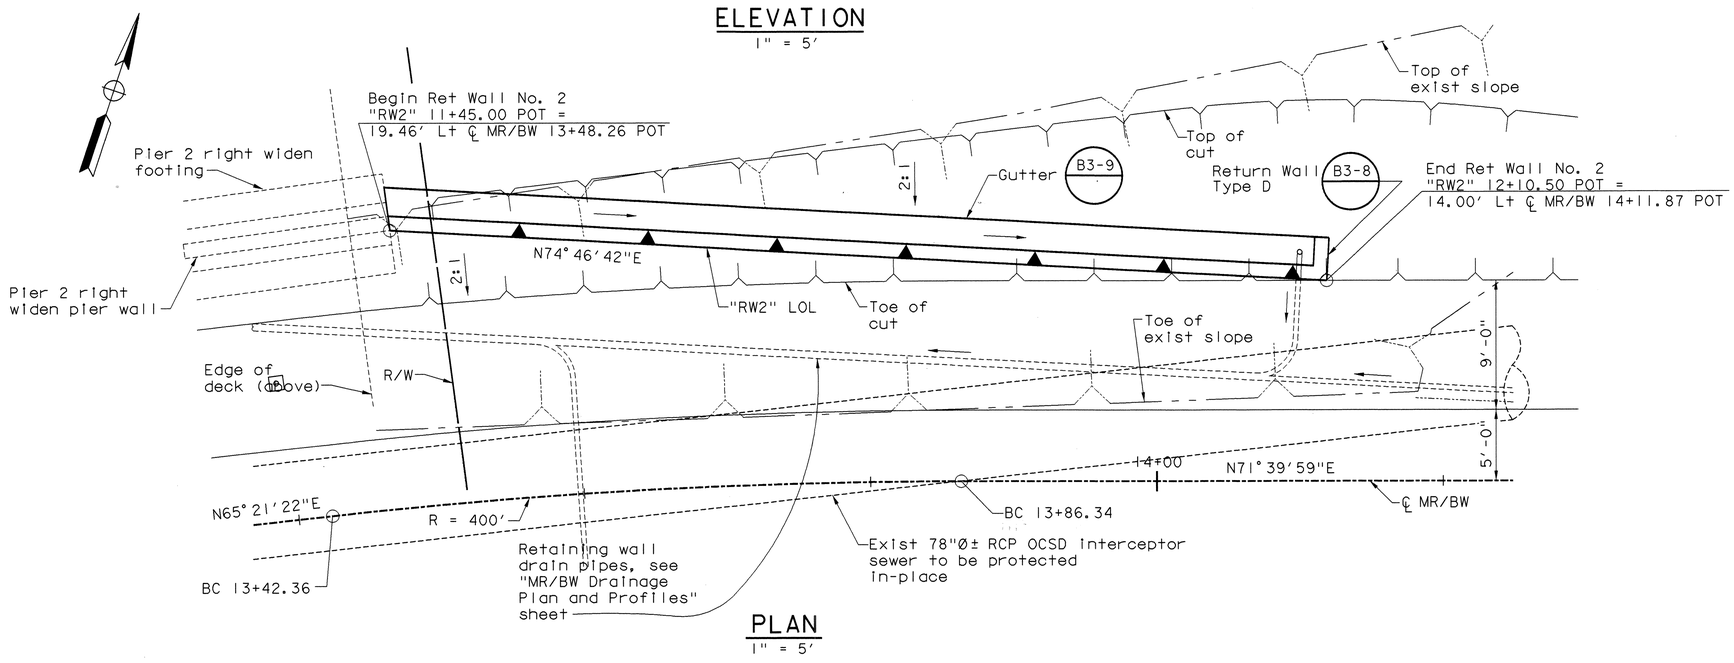

PLAN

1" = 5'

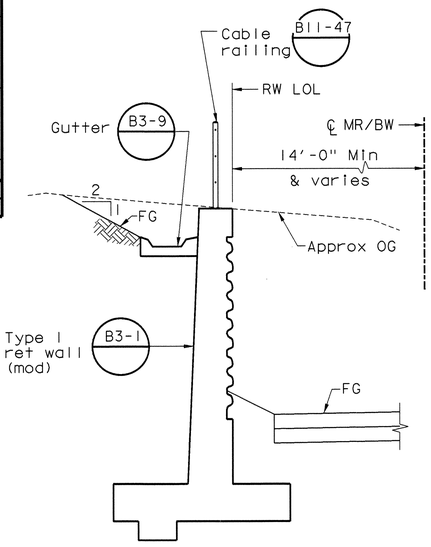

TYPICAL SECTION

No Scale

W. Koo & Associates, Inc.
600 The City Parkway West, Suite 310
Orange CA. 92868
PH: (714) 456-0280
FAX: (714) 456-0295

MARK	DATE	DESCRIPTION

REVISIONS

PREPARED UNDER RESPONSIBLE CHARGE OF:

REGISTERED PROFESSIONAL ENGINEER SHAFI M. SHARIFAN No. CE 49697 Exp. 9-30-06 CIVIL STATE OF CALIFORNIA

7/15/05
DATE

ORANGE COUNTY
RESOURCES AND DEVELOPMENT
MANAGEMENT DEPARTMENT

GLASSELL STREET BRIDGE WIDENING
OVER SANTA ANA RIVER

RETAINING WALL NO. 2
STRUCTURE PLAN

DESIGNED G. BUELOW		SHEET
DRAWN G. BUELOW	CHECKED S. SHARIFAN	15R
SCALE AS SHOWN	DATE 7/19/02	DRAWING NO.
		OF 70

Date Plotted: 07/25/2005

File Name: t:\cad\010-14\glassell\rw2_pp.dgn