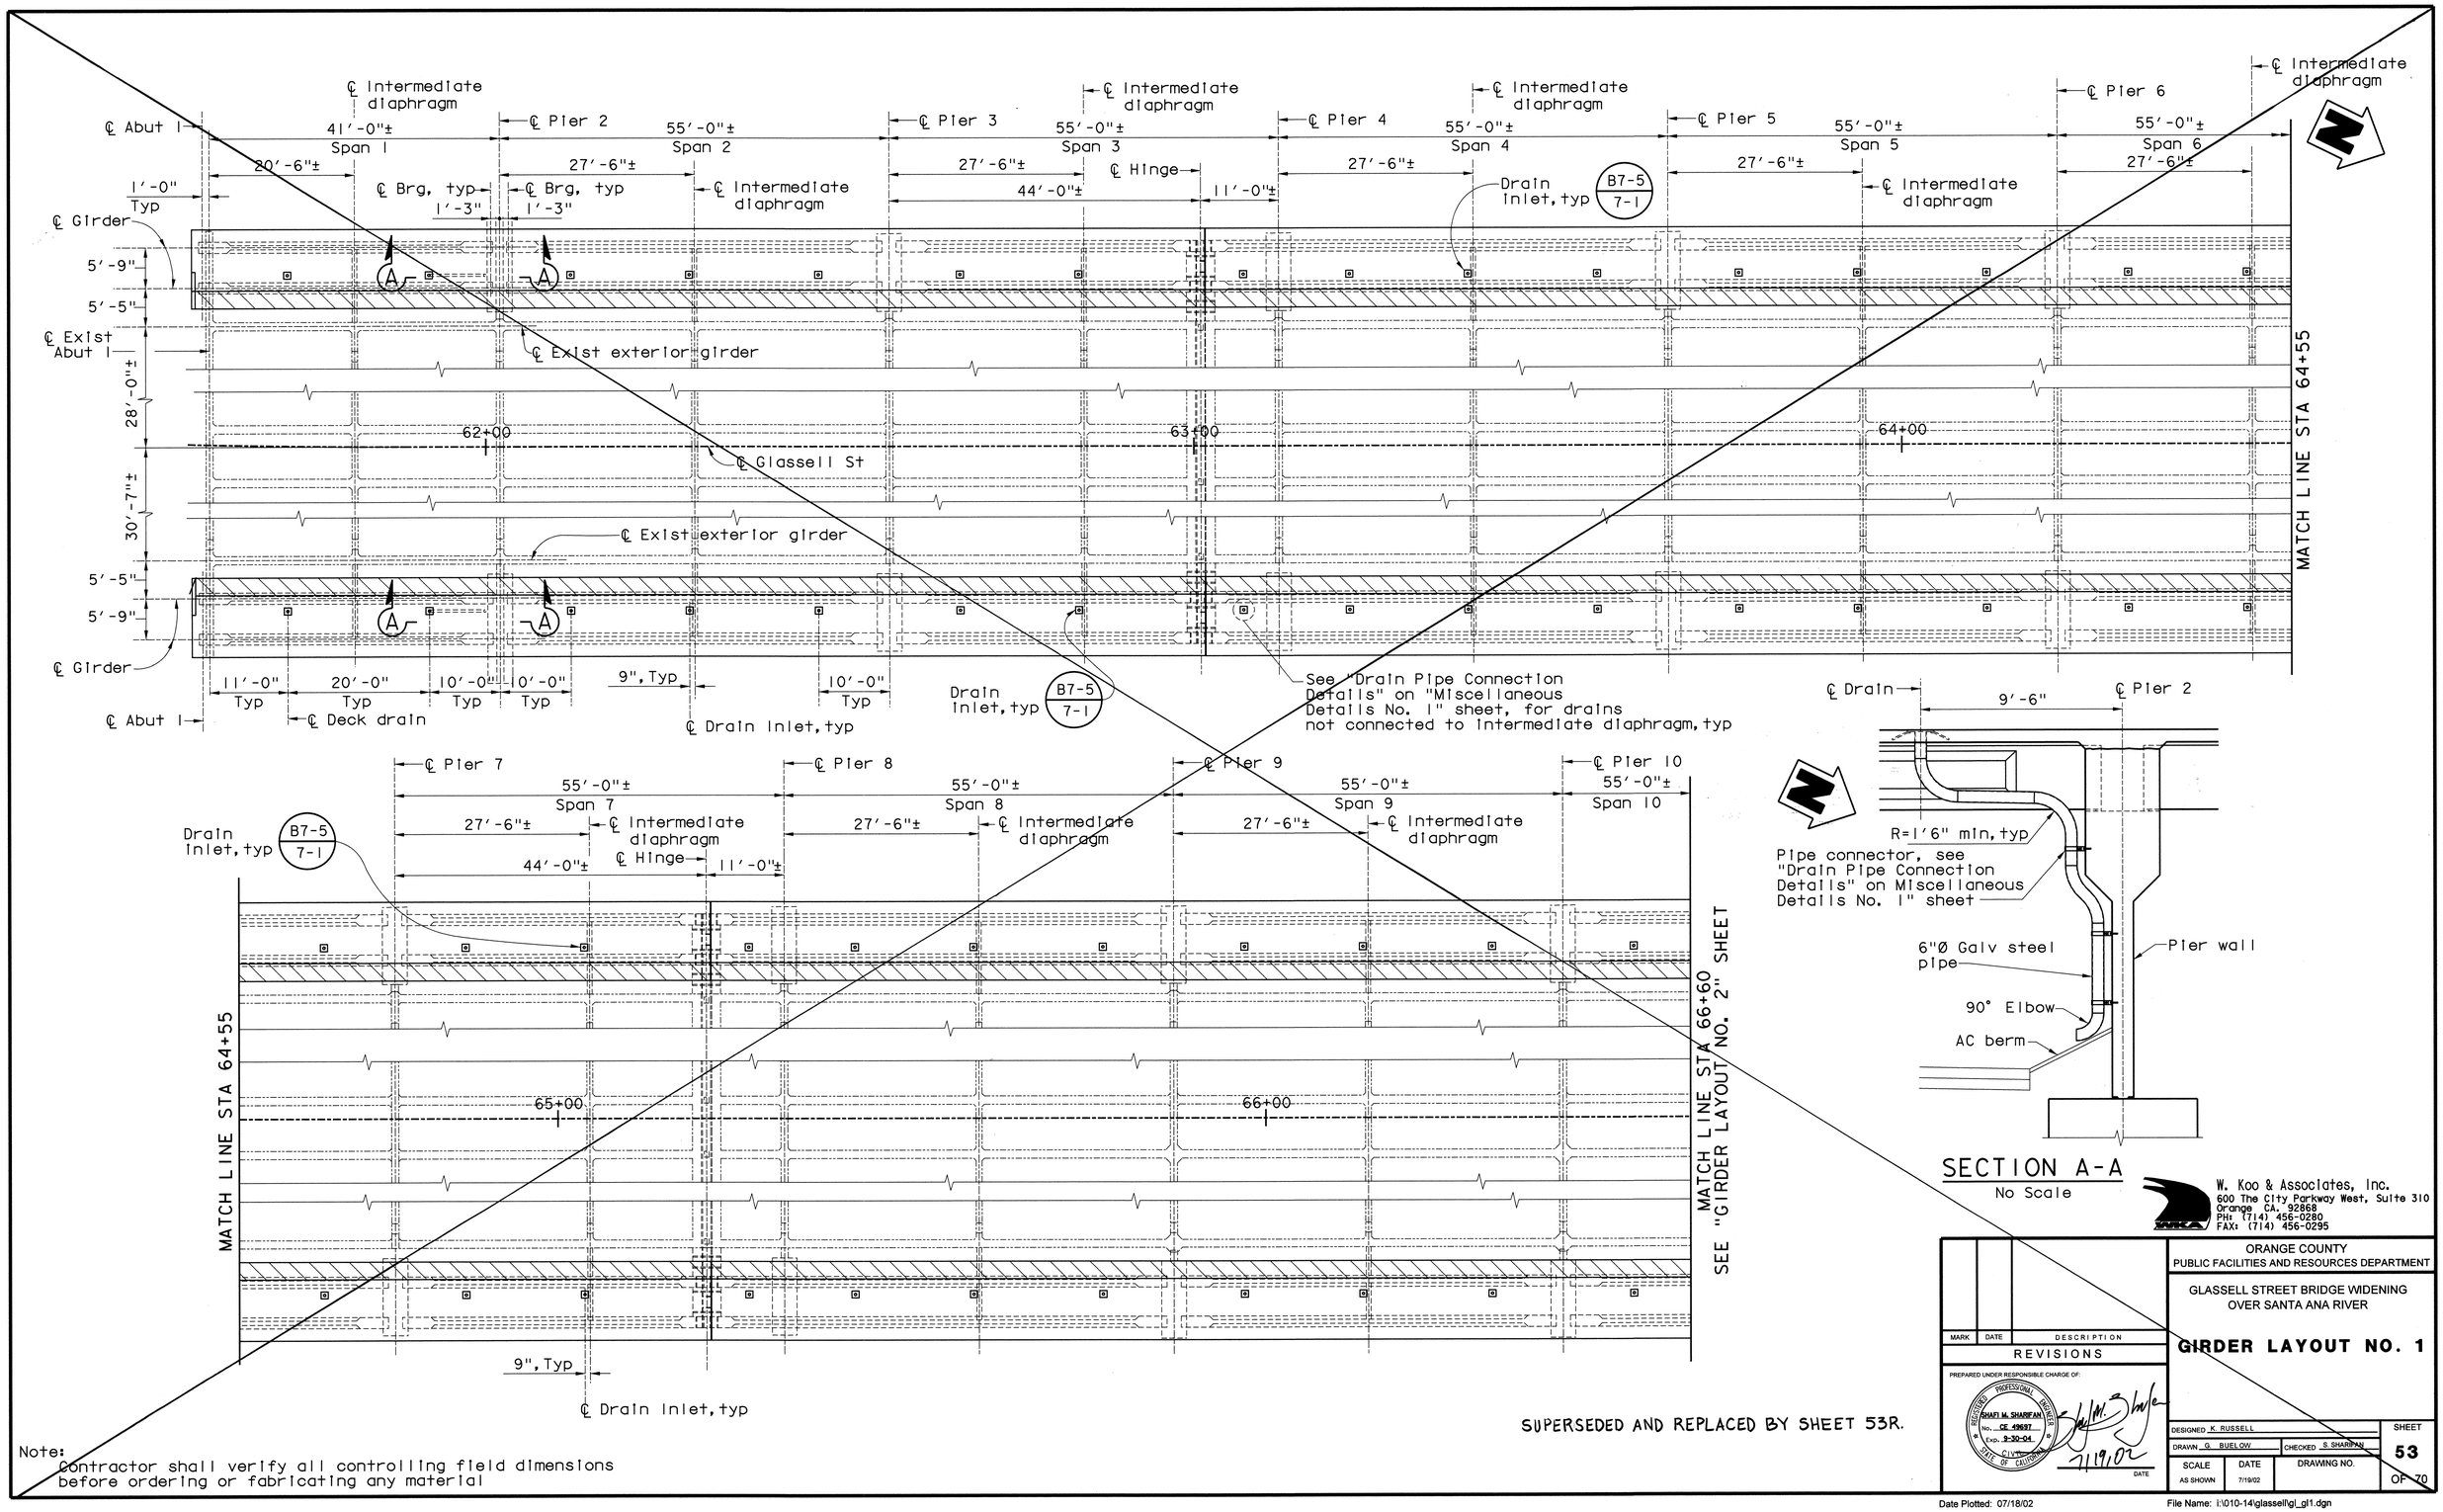

SUPERSEDED AND REPLACED BY SHEET 53R.

Note:
Contractor shall verify all controlling field dimensions before ordering or fabricating any material