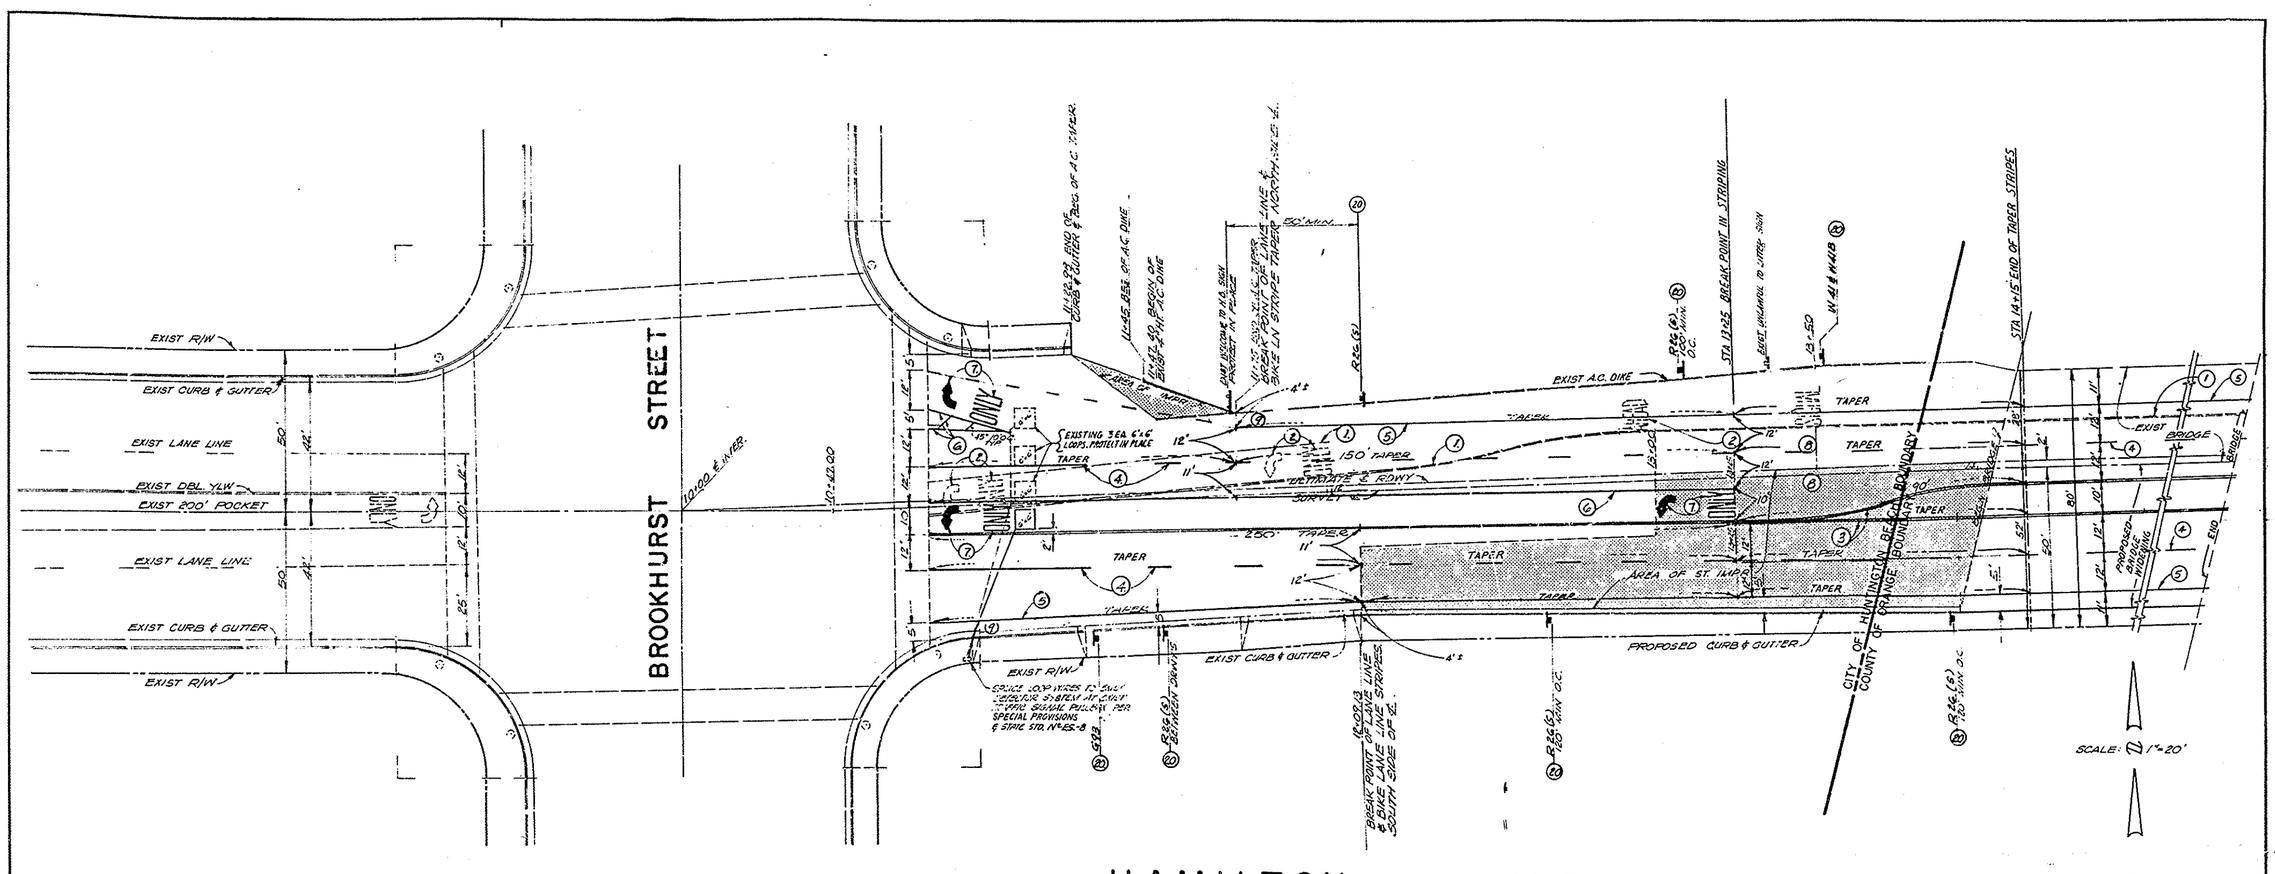

NOTES - STRIPING (see special provision)

1. SANDBLAST EXISTING STRIPE.
2. SANDBLAST EXISTING PAVEMENT MARKING.
3. PAINT 4" WIDE DOUBLE YELLOW STRIPE WITH REFLECTIVE BEADS AND BLACK PAINT IN BETWEEN THE DOUBLE YELLOW STRIPES.
4. PAINT 4" WIDE WHITE STRIPE WITH REFLECTIVE BEADS.
5. PAINT 6" WIDE WHITE STRIPE, (BIKE LN.) WITH REFLECTIVE BEADS.
6. PAINT 8" WIDE WHITE STRIPE WITH REFLECTIVE BEADS.
7. PAINT "ONLY" AND "ARROW SYMBOL" PAVEMENT MARKINGS WITH REFLECTIVE BEADS.
8. PAINT "SIGNAL AHEAD" PAVEMENT MARKINGS WITH REFLECTIVE BEADS.
9. PAINT "BIKE ONLY" AND "ARROW SYMBOL" PAVEMENT MARKINGS WITH REFLECTIVE BEADS.

NOTES - SIGNING (see special provision)

20. INSTALL SIGN AS SHOWN ON GALVANIZED "U" CHANNEL POST IN A READILY DISCERNABLE POSITION AND FREE FROM OBSTRUCTIONS TO MOTORISTS AND BICYCLISTS VISION.

#12504
Hamilton-Victoria Bridge (SA38)
Sheet 22 of 22
Red. 24x1
Linen

REVISIONS				
NUMBER	DATE	INITIALS		APPV'D
1.	3/14/77	S.Y.	CHANGE IN WIDTH TO MIN. 12'; 250' TAPER, REDESIGNED RADIUS IN POINT OF N.B. SIGN	[illegible]

REFERENCES

PREPARED UNDER THE SUPERVISION OF Ralph A. Lopez R.C.E. NO. 23799	DATE 10/6/76
DRAWN BY S.Y.	9/28/76
CHECKED	
RECOMMENDED	
APPROVED Michael Zamora DEPARTMENT OF PUBLIC WORKS	DATE 2/15/77

PLAN OF CHANNELIZATION & SIGNING & INSTALLATION OF TRAFFIC SIGNAL DETECTOR
HAMILTON AVENUE
BROOKHURST STREET TO SANTA ANA RIVER

CITY OF HUNTINGTON BEACH
DEPARTMENT OF PUBLIC WORKS

477

SHEET NO. 22 OF 22

DR8 (12504)