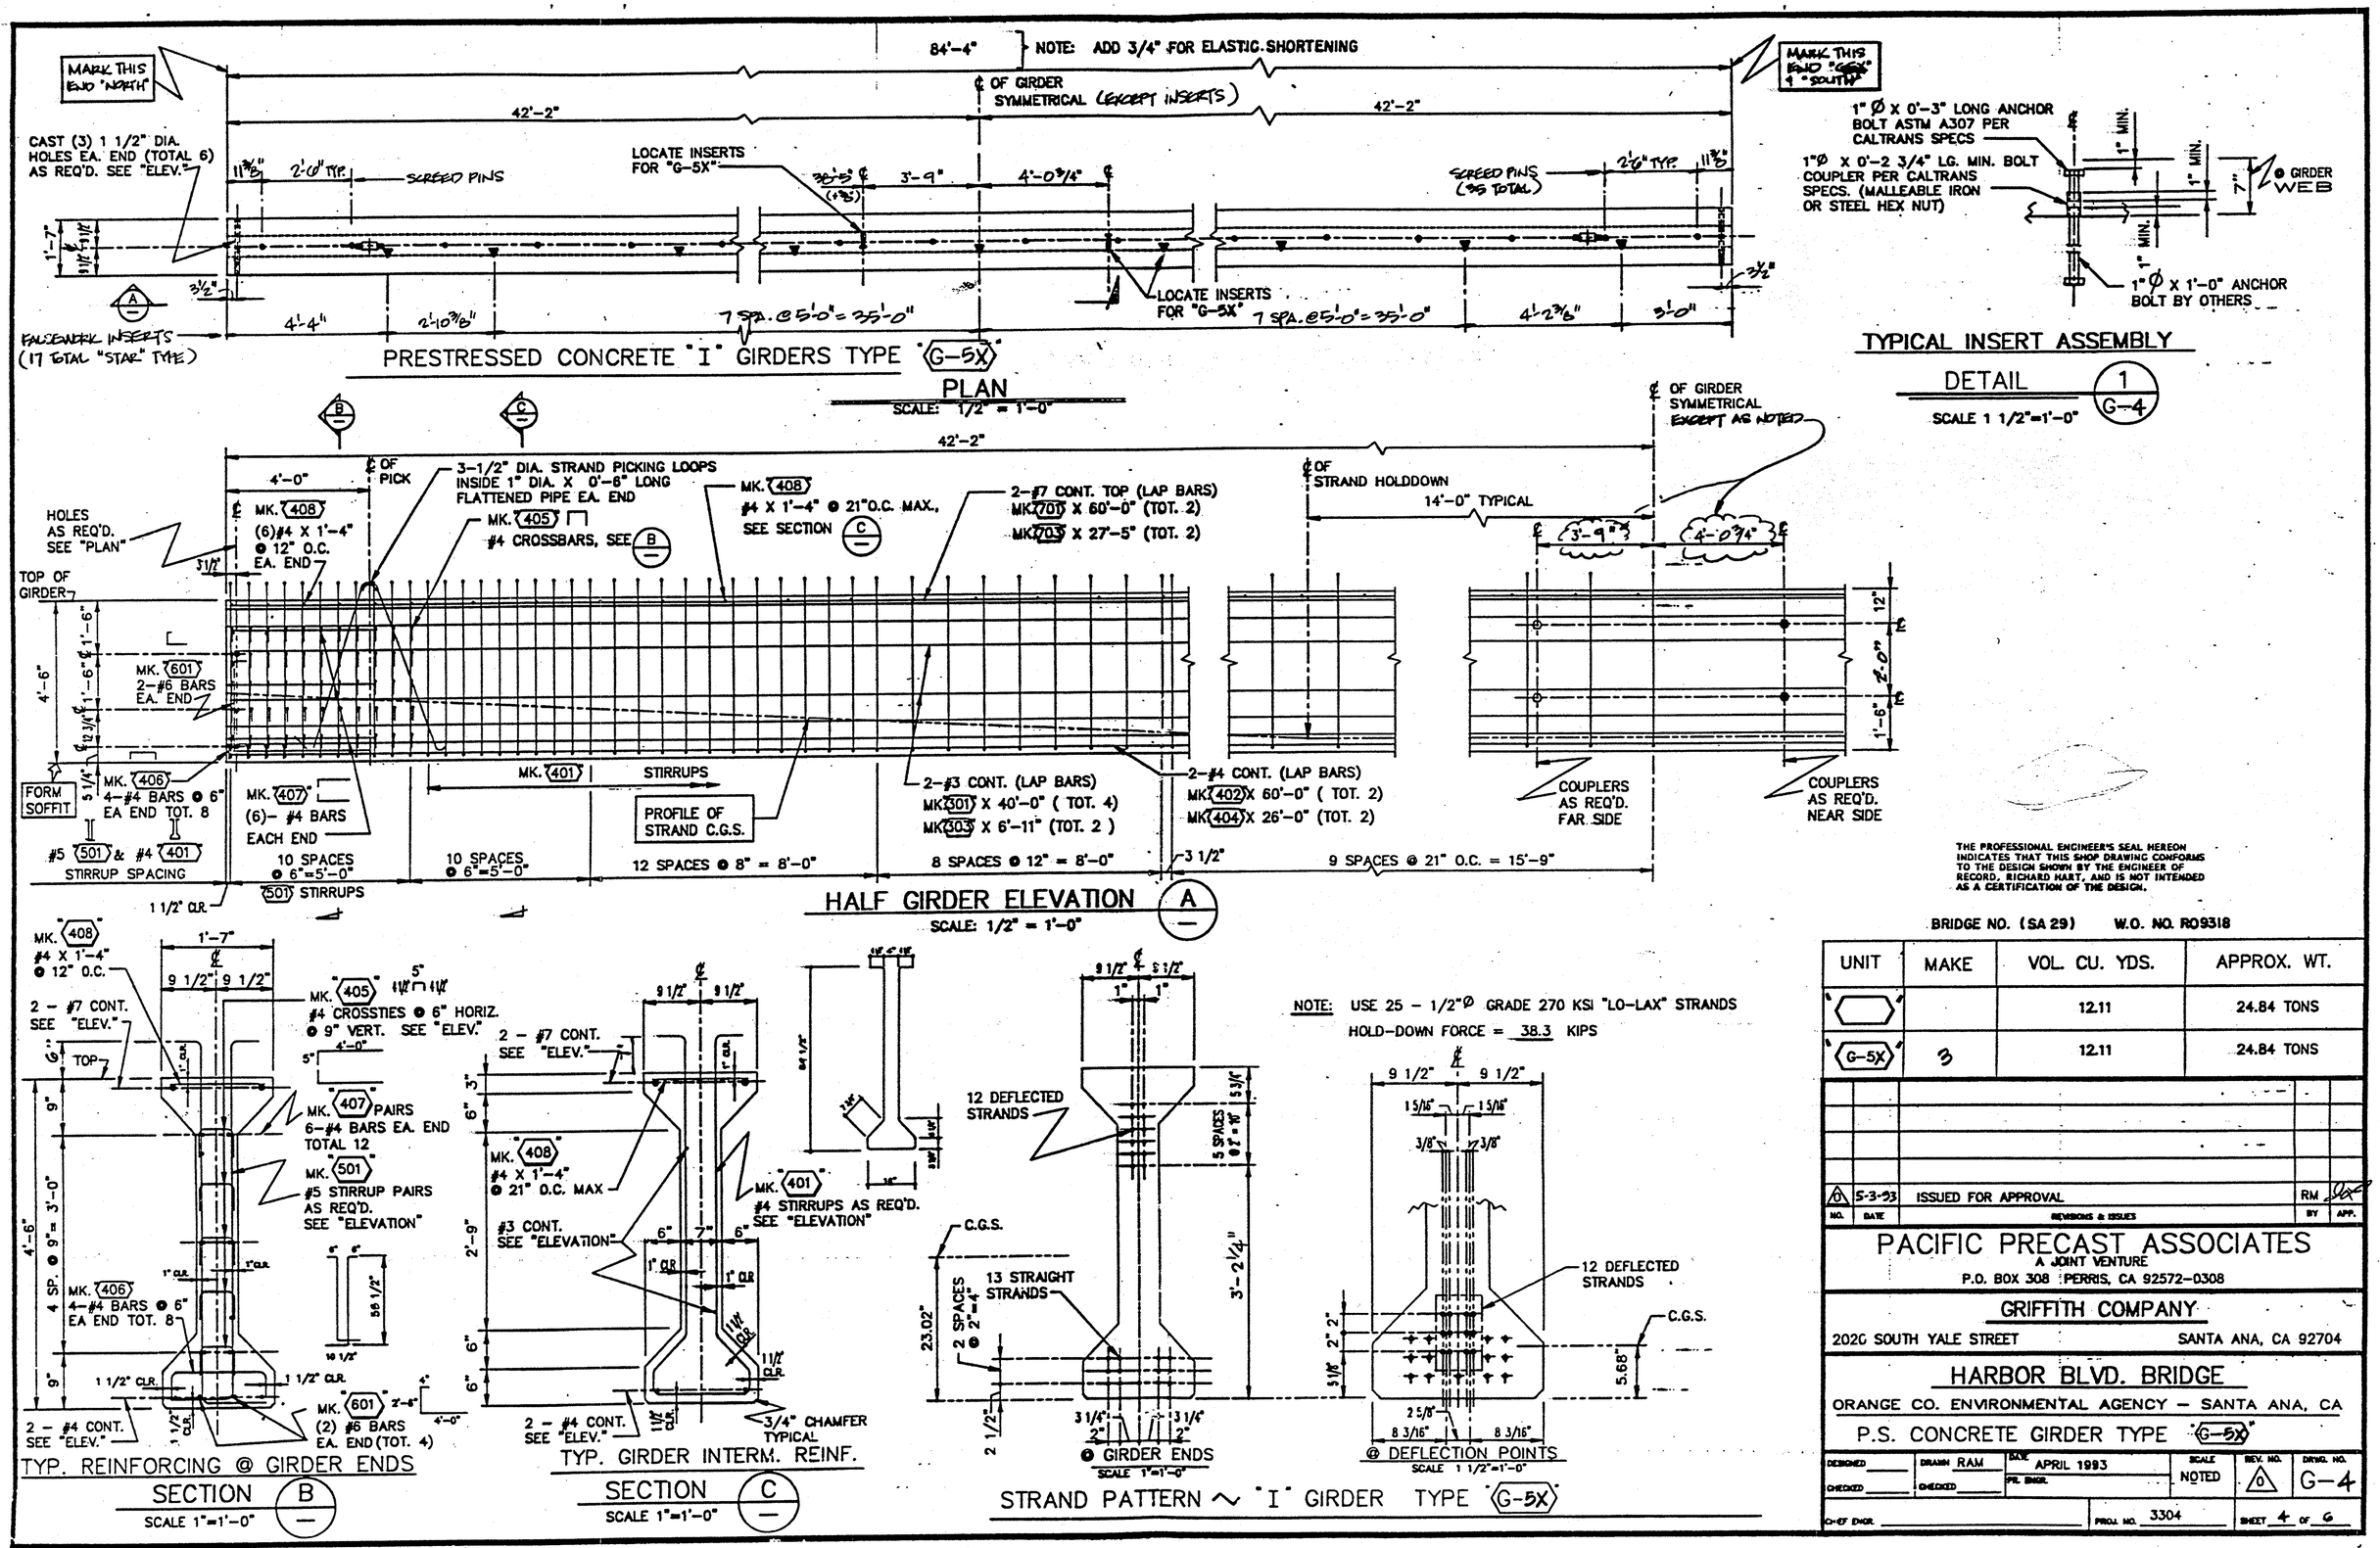

THE PROFESSIONAL ENGINEER'S SEAL HEREON INDICATES THAT THIS SHOP DRAWING CONFORMS TO THE DESIGN SHOWN BY THE ENGINEER OF RECORD, RICHARD HART, AND IS NOT INTENDED AS A CERTIFICATION OF THE DESIGN.

BRIDGE NO. (SA 29) W.O. NO. R09318

UNIT	MAKE	VOL. CU. YDS.	APPROX. WT.
		12.11	24.84 TONS
G-5X	3	12.11	24.84 TONS

NO.	DATE	REVISIONS & ISSUES	BY	APP.
0	5-3-93	ISSUED FOR APPROVAL	RM	

PACIFIC PRECAST ASSOCIATES
A JOINT VENTURE
P.O. BOX 308 PERRIS, CA 92572-0308

GRIFFITH COMPANY
2020 SOUTH YALE STREET SANTA ANA, CA 92704

HARBOR BLVD. BRIDGE
ORANGE CO. ENVIRONMENTAL AGENCY - SANTA ANA, CA
P.S. CONCRETE GIRDER TYPE "G-5X"

DESIGNED ____ DRAWN RAM DATE APRIL 1993 SCALE NOTED REV. NO. 0 DRWG. NO. G-4
CHECKED ____ CHECKED ____ PR. ENGR. ____
CHIEF ENGR. ____ PROJ. NO. 3304 SHEET 4 OF 6

ORIGINAL