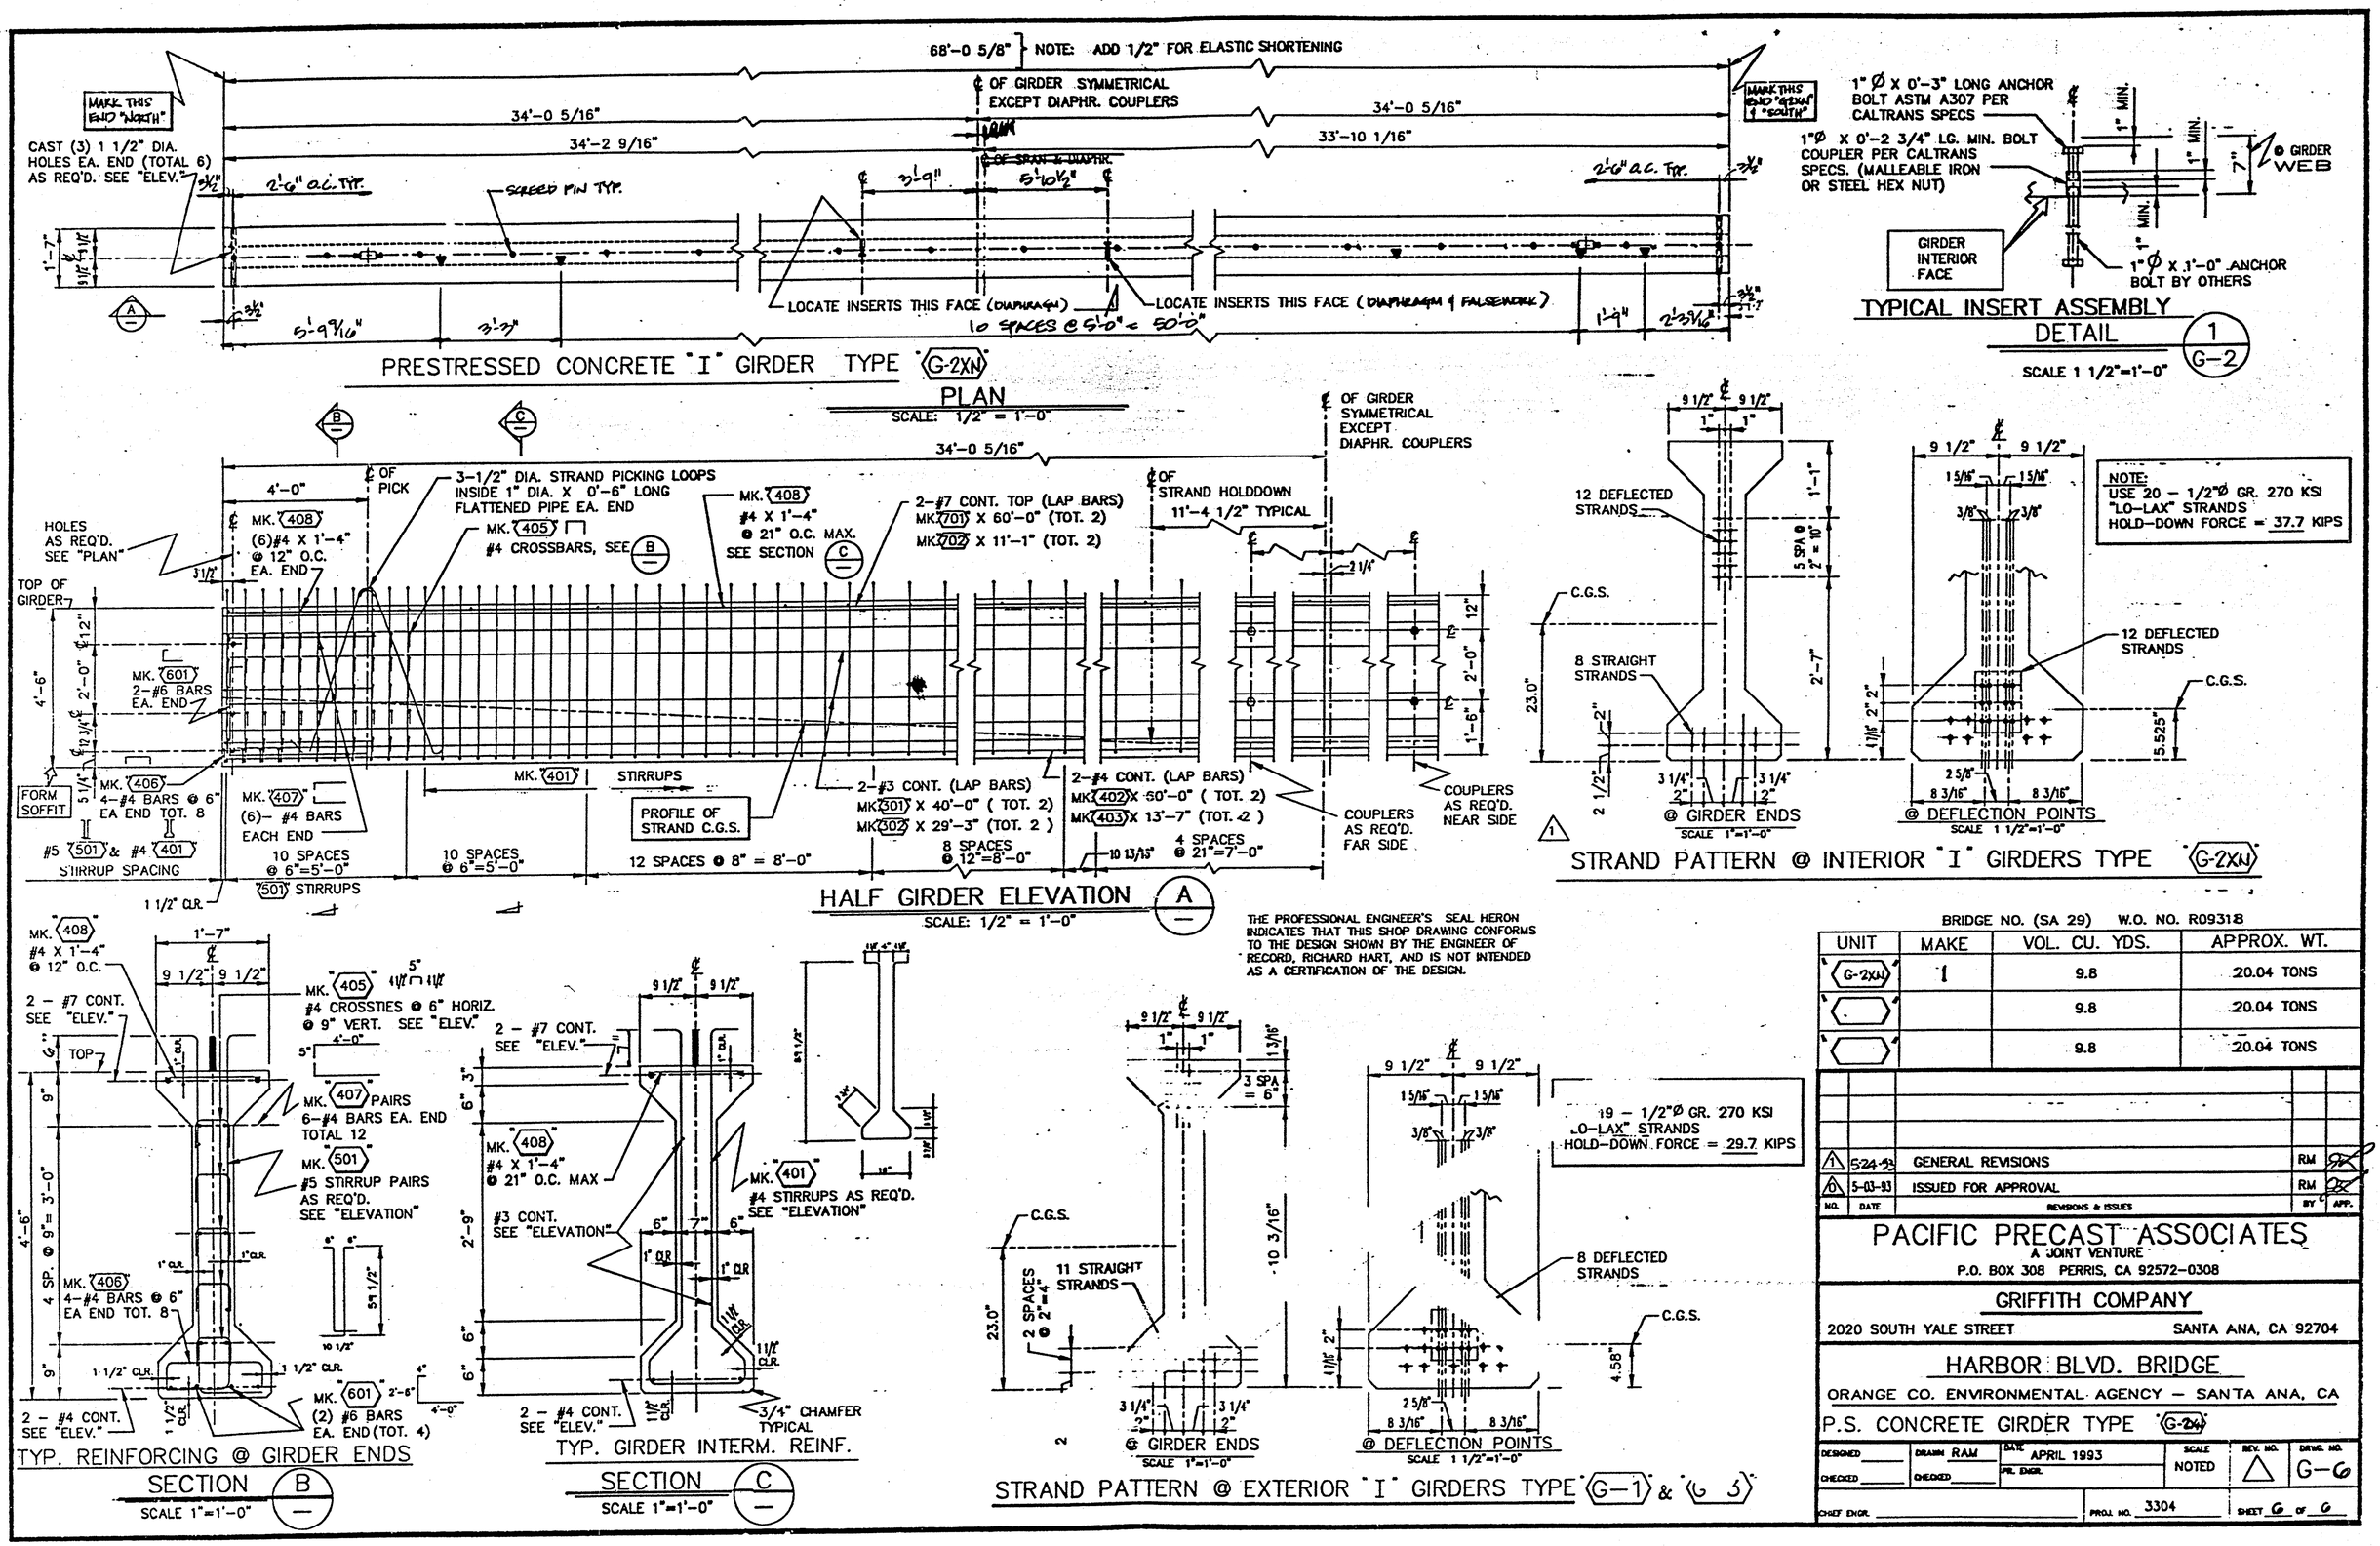

BRIDGE NO. (SA 29) W.O. NO. R09318

UNIT	MAKE	VOL. CU. YDS.	APPROX. WT.
G-2XN	1	9.8	20.04 TONS
		9.8	20.04 TONS
		9.8	20.04 TONS

NO.	DATE	REVISIONS & ISSUES	BY	APP.
1	5-24-93	GENERAL REVISIONS	RM	
0	5-03-93	ISSUED FOR APPROVAL	RM	

PACIFIC PRECAST ASSOCIATES
A JOINT VENTURE
P.O. BOX 308 PERRIS, CA 92572-0308

GRIFFITH COMPANY
2020 SOUTH YALE STREET SANTA ANA, CA 92704

HARBOR BLVD. BRIDGE
ORANGE CO. ENVIRONMENTAL AGENCY - SANTA ANA, CA
P.S. CONCRETE GIRDER TYPE G-2XN

DESIGNED	DRAWN RAM	DATE APRIL 1993	SCALE NOTED	REV. NO. 1	DRWG. NO. G-6
CHECKED	CHECKED	PR. ENGR.			
CHIEF ENGR.		PROJ. NO. 3304		SHEET 6 OF 6	