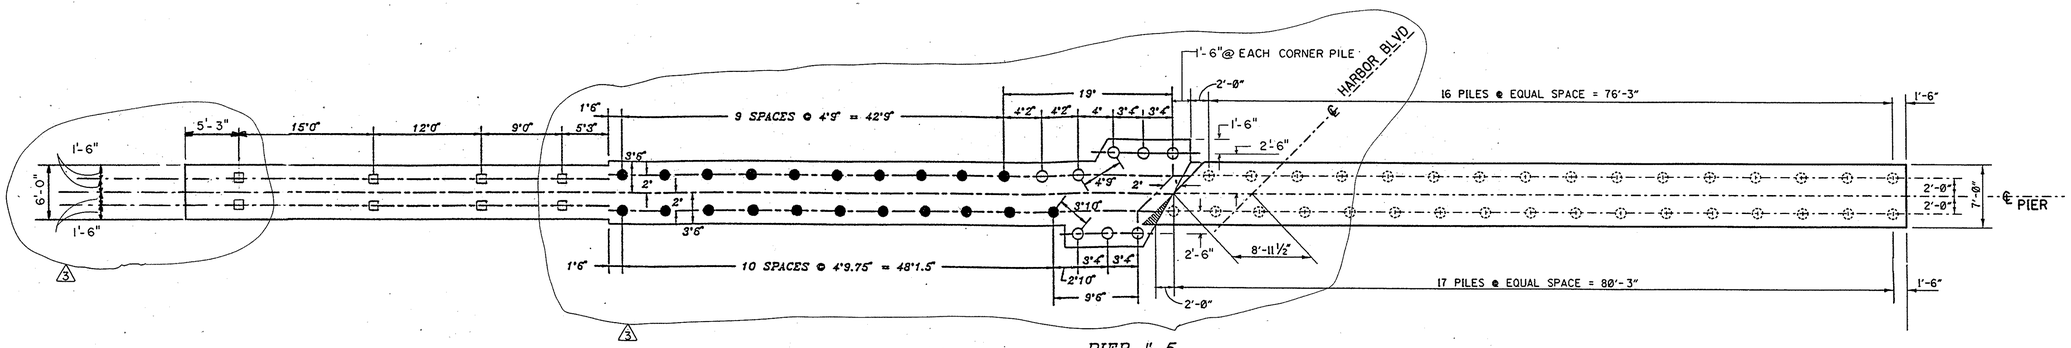


PIER # 5

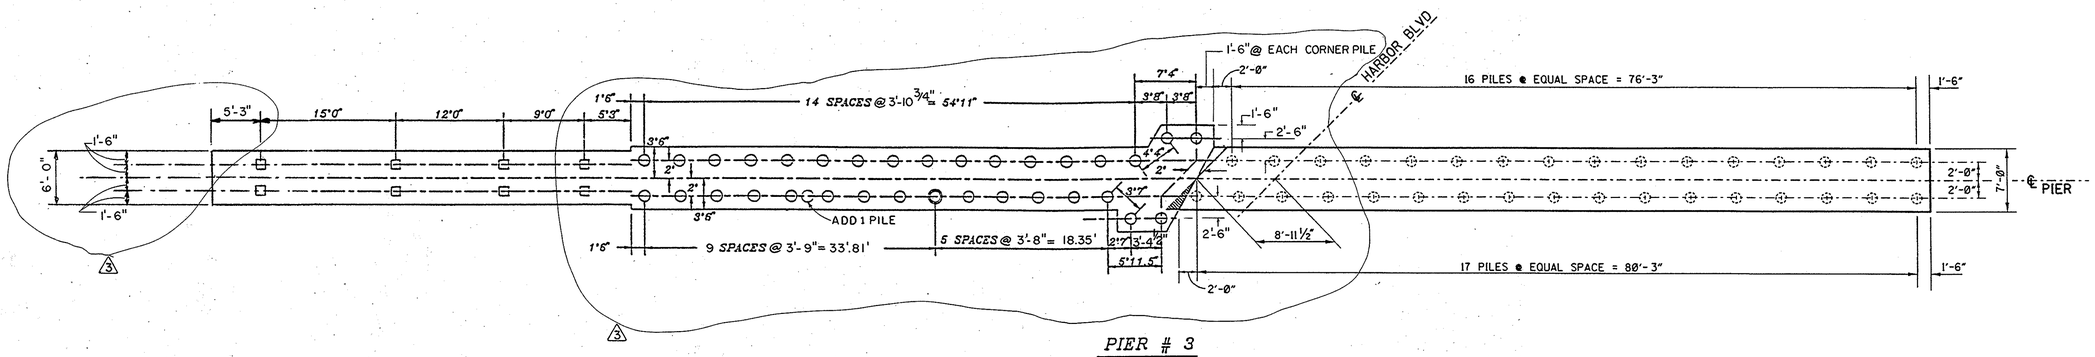


PIER # 3

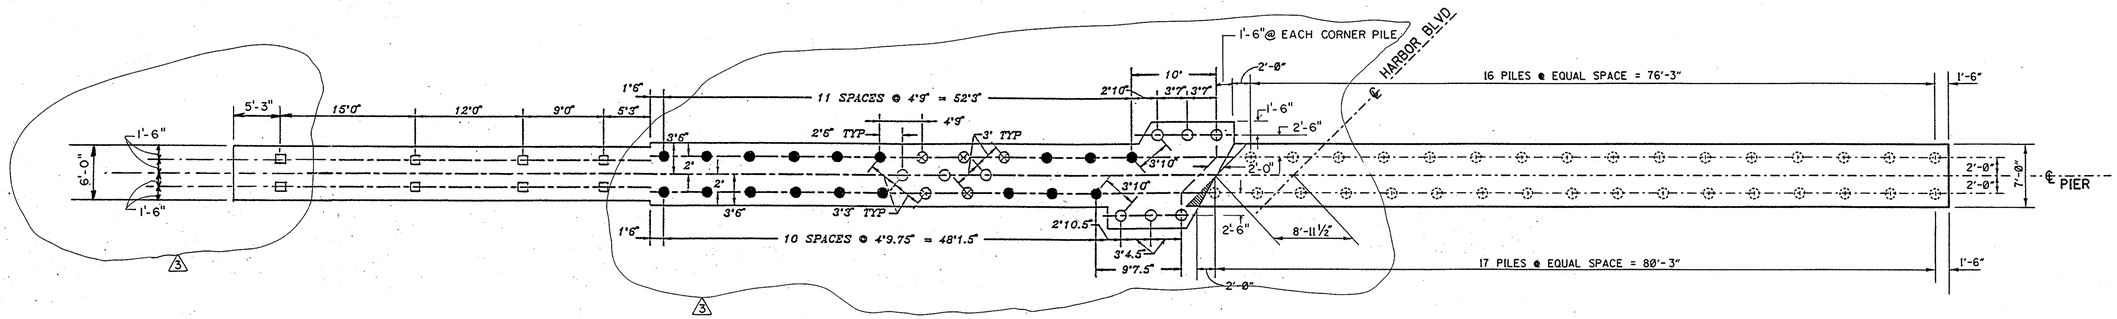


PIER # 2

FOR ALL PIE

RECORD DRAWING

LEGEND

- ⊗ – 100 TON PILES – DRIVEN
- ○ – 80 TON PILES – ADDED
- ⊗ – 80 TON PILES – DRIVEN
- ◎ – TEST PILE – DRIVEN
- □ – 70 TON PILE
- 3 ◌ – 100 TON PILES – DRIVEN

# PIER WALL FOUNDATION PLAN 3

SCALE : ⅛" = 1'-0"

3 NOTE : THIS PLAN SHEET REVISES PLAN SHEET #23 OF THE PLANS, BY MODIFYING THE PIER AND PILING FOR PIERS 2, 3 & 5. ALL REVISIONS ON THIS SHEET WERE PREPARED UNDER THE DIRECTION OF ERIC G. FOTIADI, CALIFORNIA REGISTERED CIVIL ENGINEER NO. 35763, EXPIRATION DATE 6/30/95, AND SEALED AND STAMPED BY HIM, ON THE ORIGINAL 8½ X 11 COPY OF THIS SHEET ON 6/9/94. THE ORIGINAL SIGNED AND SEALED SHEET IS IN THE PROJECT FILES. THE INFORMATION HAS BEEN TRANSFERED TO THIS SHEET FOR LEGIBILITY AND EASE OF USE.

| MARK | DATE | DESCRIPTION |
|---|---|---|
| 3 | 3/99 | PIER REVISIONS RECORD DRAWING |

REVISIONS

PREPARED UNDER RESPONSIBLE CHARGE OF:

DATE

ORANGE COUNTY
PUBLIC FACILITIES AND RESOURCES DEPARTM

HARBOR BLVD BRIDGE IMPROVEME

PIERS

DESIGNED
DRAWN
CHECKED
SCALE AS SHOWN
DATE
DRAWING NO.
SH 2 OF