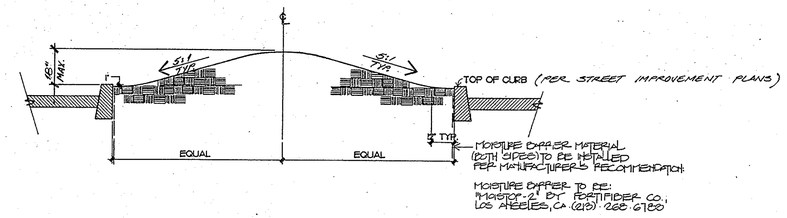

4 TURF MOUND IN MEDIAN

N.T.S.

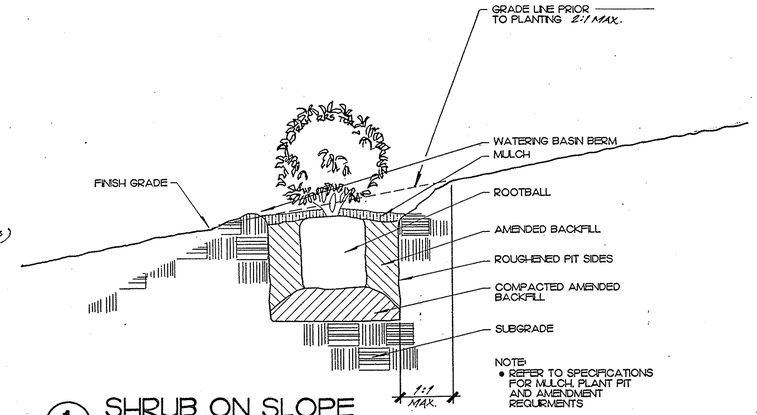

NOTE:
- REFER TO SPECIFICATIONS FOR MULCH, PLANT PIT AND AMENDMENT REQUIRMENTS

1 SHRUB ON SLOPE

N.T.S.

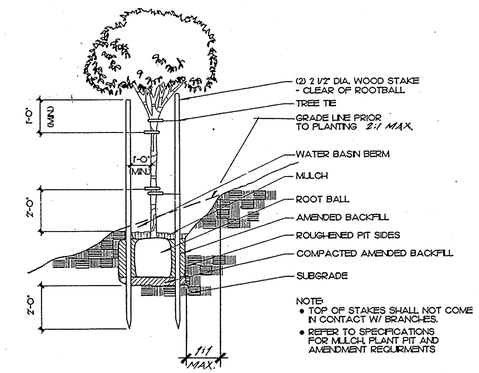

NOTE:
- TOP OF STAKES SHALL NOT COME IN CONTACT W/ BRANCHES.
- REFER TO SPECIFICATIONS FOR MULCH, PLANT PIT AND AMENDMENT REQUIRMENTS

2 TREE ON SLOPE

N.T.S.

PLANTING REQUIREMENTS:

1. TREE SPACING 35' MIN. TO 50' MAX.
2. PLANT 50' MIN. FROM BCR ON THE APPROACH TO AN INTERSECTION AND 15' FROM THE BCR ON THE EXIT SIDE.
3. PLANT 10' MIN. FROM EDGE OF DRIVE APPROACH.
4. PLANT 10' MIN. FROM UTILITY & SEWER LINES.
5. PLANT 20' MIN. FROM STREET LIGHT STANDARDS AND POWER POLES.
6. PLANT 10' MIN. FROM FIRE HYDRANTS.
7. 3'x3' TREE WELL STANDARD, UNLESS OTHERWISE SPECIFIED.

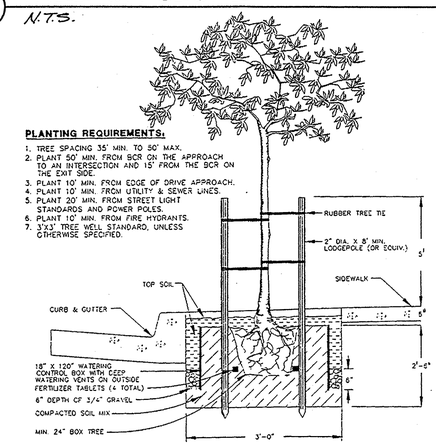

3 STREET TREE IN TREE WELL

(CITY STANDARD PLAN NO. 124) N.T.S.

RECORD DRAWING

REGISTERED LANDSCAPE ARCHITECT
GARY L. BYE No. 3544
Gary L. Bye
EXP. 12/31/93
Date
STATE OF CALIFORNIA

FILE NO.	REVISIONS									REFERENCES
	NUMBER	DATE	INITIALS	DESCRIPTIONS	APPRVD	NUMBER	DATE	INITIALS	DESCRIPTIONS	APPRVD	

PREPARED UNDER THE SUPERVISION OF GARY BYE 3544 R.L.A. No		DATE 2/19/93
DESIGNED F.M.A.	DRAWN F.M.A.	
R/W APPROVED	CHECKED GB	
RECOMMENDED		2/22/93
APPROVED		4/23/93
CITY ENGINEER	R.C.E. NO. 85161	

HARBOR BLVD. IMPROVEMENTS

PLANTING

DETAIL SHEET

PUBLIC WORKS AGENCY
CITY OF SANTA ANA

SHEET 41 OF 60