PREPARED UNDER THE SUPERVISION OF:	ORANGE COUNTY ROAD DEPARTMENT
CLIFFORD C. HOOD R.C.E. 12489 — DATE: 3-2-71	PROJECT JERONIMO ROAD
	LIMITS LOS ALISOS BLVD TO CHERRY AVE.
	SCALE HORIZ. 1"=40' VERT. 1"=4' — SHEET 5 OF 33

BENCH MARK

D-785 STD. USC & GS BRONZE DISK STAMPED "D-785" ABOUT 0.7 MILES SE. ALONG THE A.T. & S.F. RAILROAD FROM THE CROSSING OF EL TORO RD. AT EL TORO RD. AT A CONC. CUVERT D-189 IN TOP S.W. HDWL. 28.1' S.W OF THE S.W. RAIL 0.6' N.W. OF THE S.E. END OF HDWL. & ABOUT 15' LOWER THAN THE TRACK.
1958 ELEV. 417.633
1964 ELEV. 417.616

Note: Existing water line (30' nw'ly of ℄) to be removed by contractor and reconstructed by others.

CONSTRUCTION NOTE

(1) REMOVE EXISTING TYPE (F-1) GUIDE MARKER

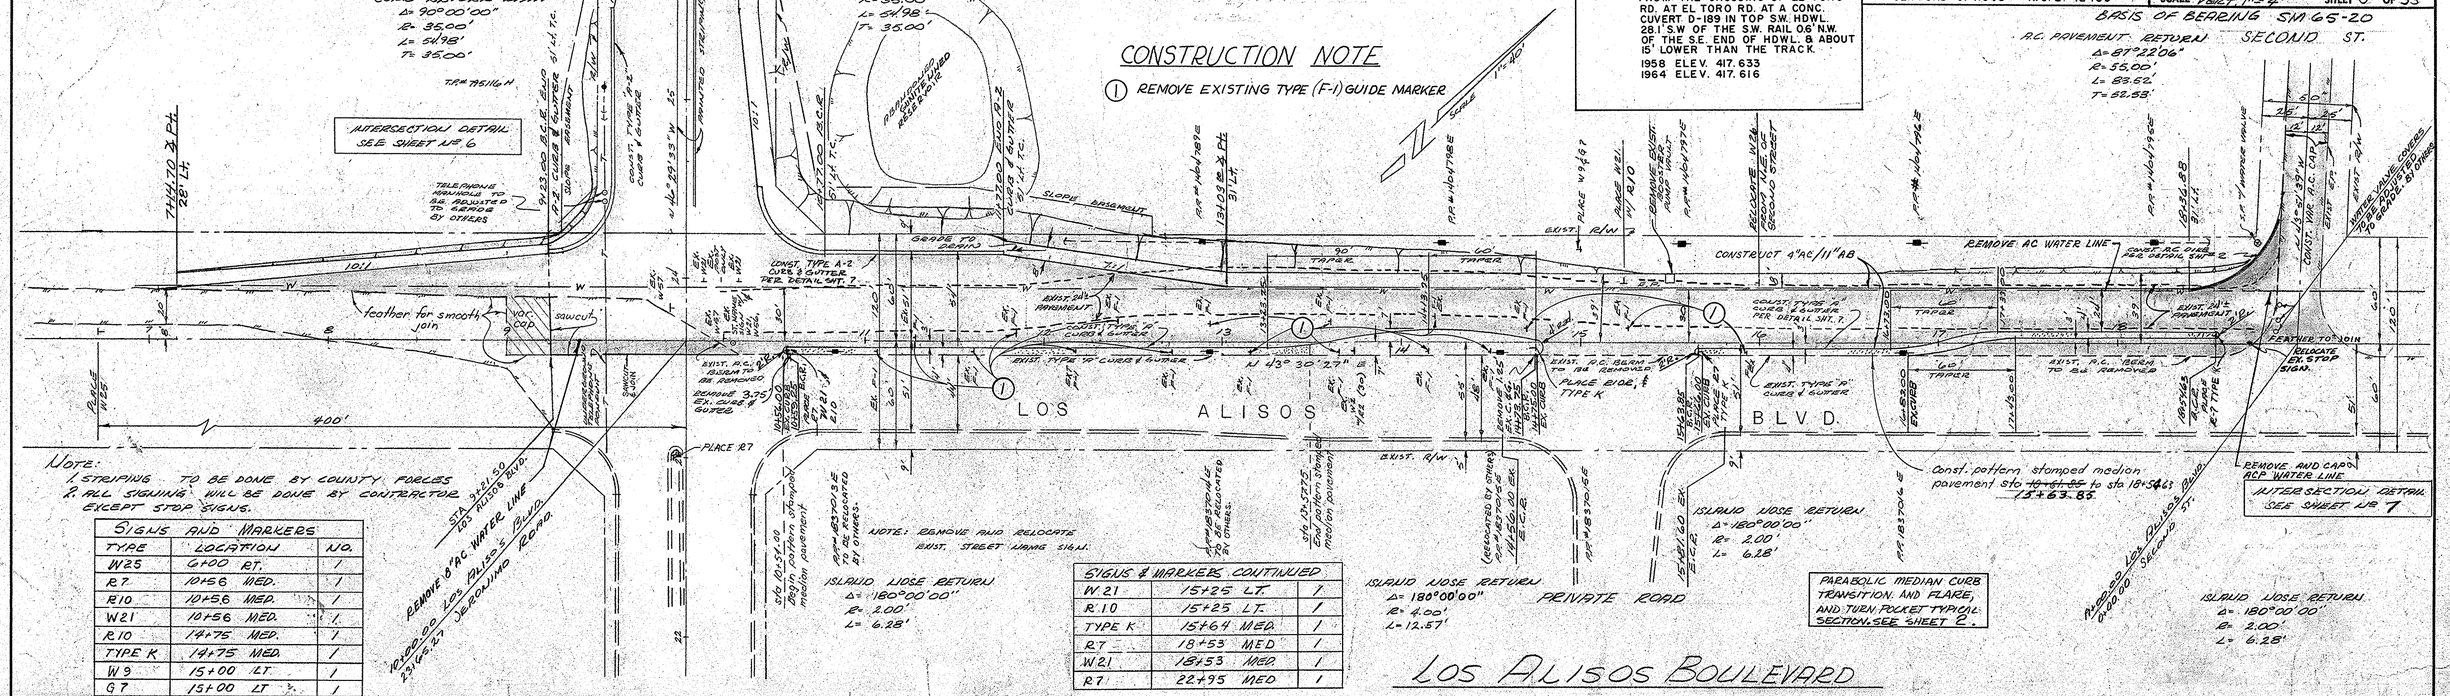

NOTE:

1. STRIPING TO BE DONE BY COUNTY FORCES
2. ALL SIGNING WILL BE DONE BY CONTRACTOR EXCEPT STOP SIGNS.

SIGNS AND MARKERS		
TYPE	LOCATION	NO.
W25	6+00 RT.	1
R7	10+56 MED.	1
R10	10+56 MED.	1
W21	10+56 MED.	1
R10	14+75 MED.	1
TYPE K	14+75 MED.	1
W9	15+00 LT.	1
G7	15+00 LT.	1

SIGNS & MARKERS CONTINUED		
W21	15+25 LT.	1
R10	15+25 LT.	1
TYPE K	15+64 MED.	1
R7	18+53 MED.	1
W21	18+53 MED.	1
R7	22+95 MED.	1

INITIAL	DATE
WMT	9/18/73
	2/19/73
	9/18/73

DESIGNED
DRAWN
CHECKED
APPROVED

STA.	7	8	9	10	11	12	13	14	15	16	17	18	19	STA.
CU. EXC.	58	102	144	1275	2672	2837	2379	1626	757	171	21	36	12078	EXC. CU.
YDS. EMB.	92	83	102	0	0	0	0	3	26	74	219	181	780	EMB. YDS

F3011-92

DR 10 (11212)