EXACT® STRAIGHT EDGE RULE SE-48

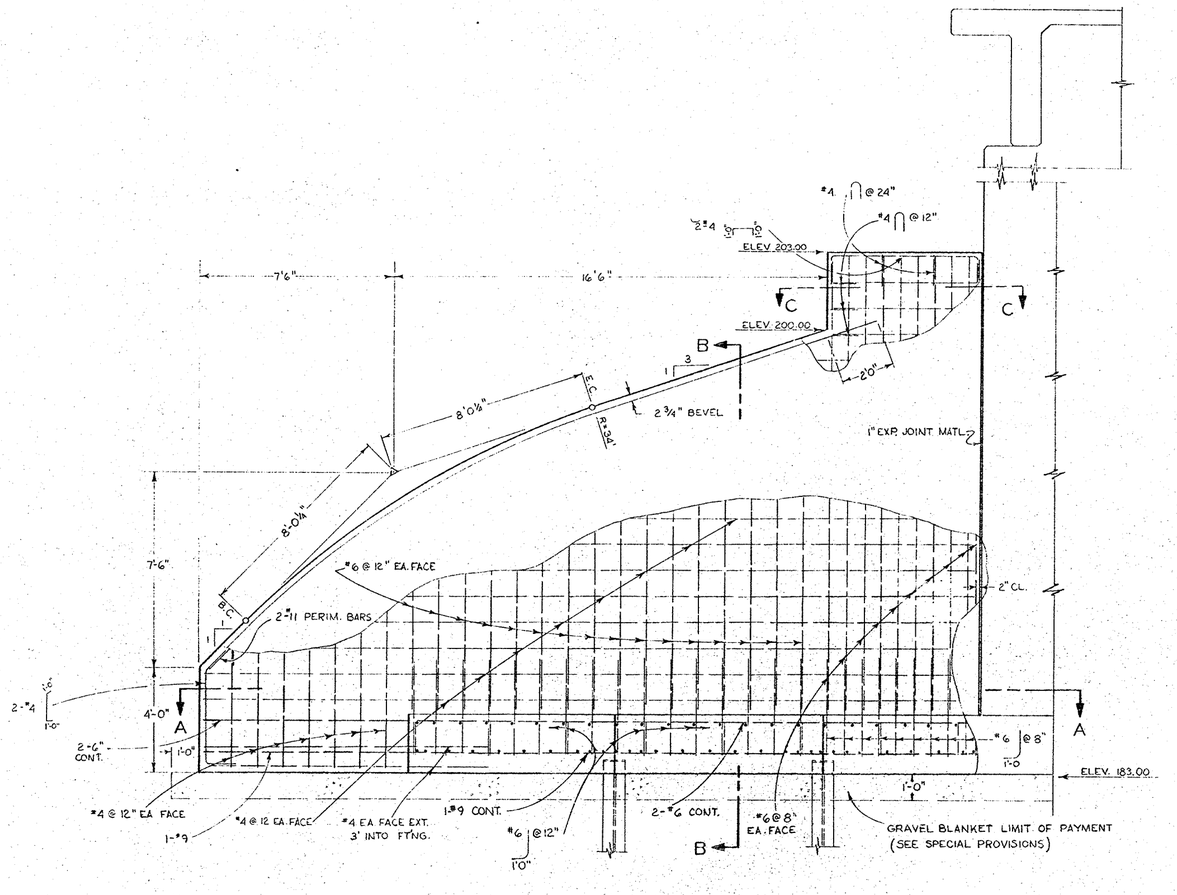

TYPICAL PIER EXTENSION DETAILS

SCALE—3/8"=1'-0"

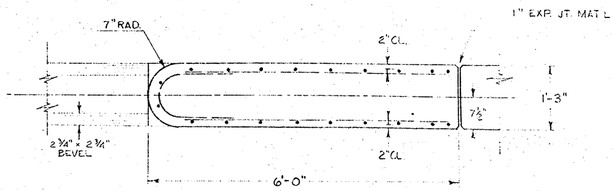

SECTION C-C

SCALE 3/4"=1'-0"

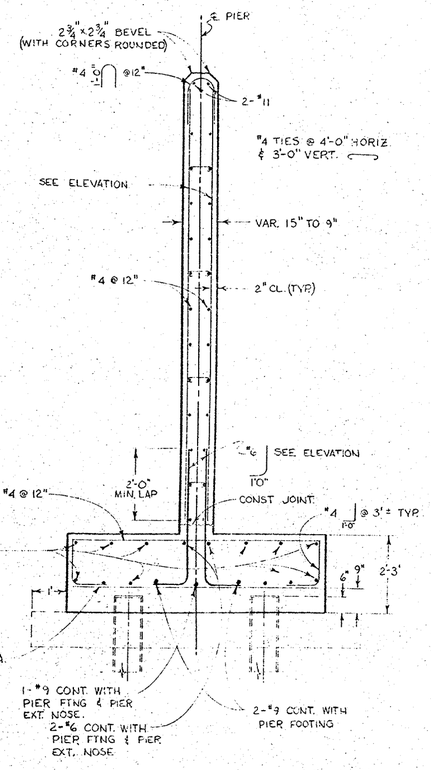

SECTION B-B

SCALE—1/2"=1'-0"

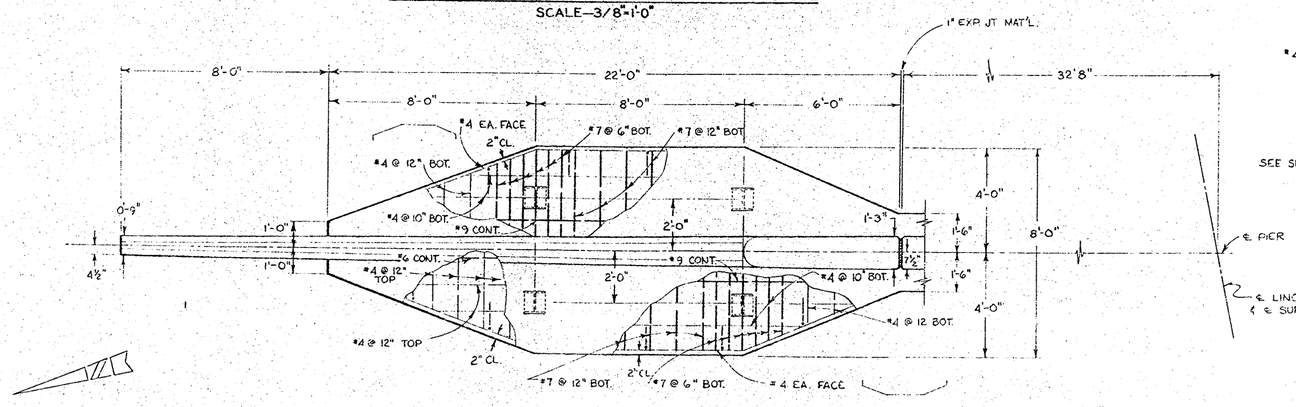

SECTION A-A

SCALE 3/8"=1'-0"

AS BUILT

LINCOLN AVENUE BRIDGE
Plan # 10326

Sheet 18 of 25
Red: 22:5.1
Scale: As Shown
Vellum

LINCOLN AVENUE
BRIDGE SA-10
OVER
SANTA ANA RIVER
PIER EXTENSION
DETAILS

18 of 25

DR 10/1032