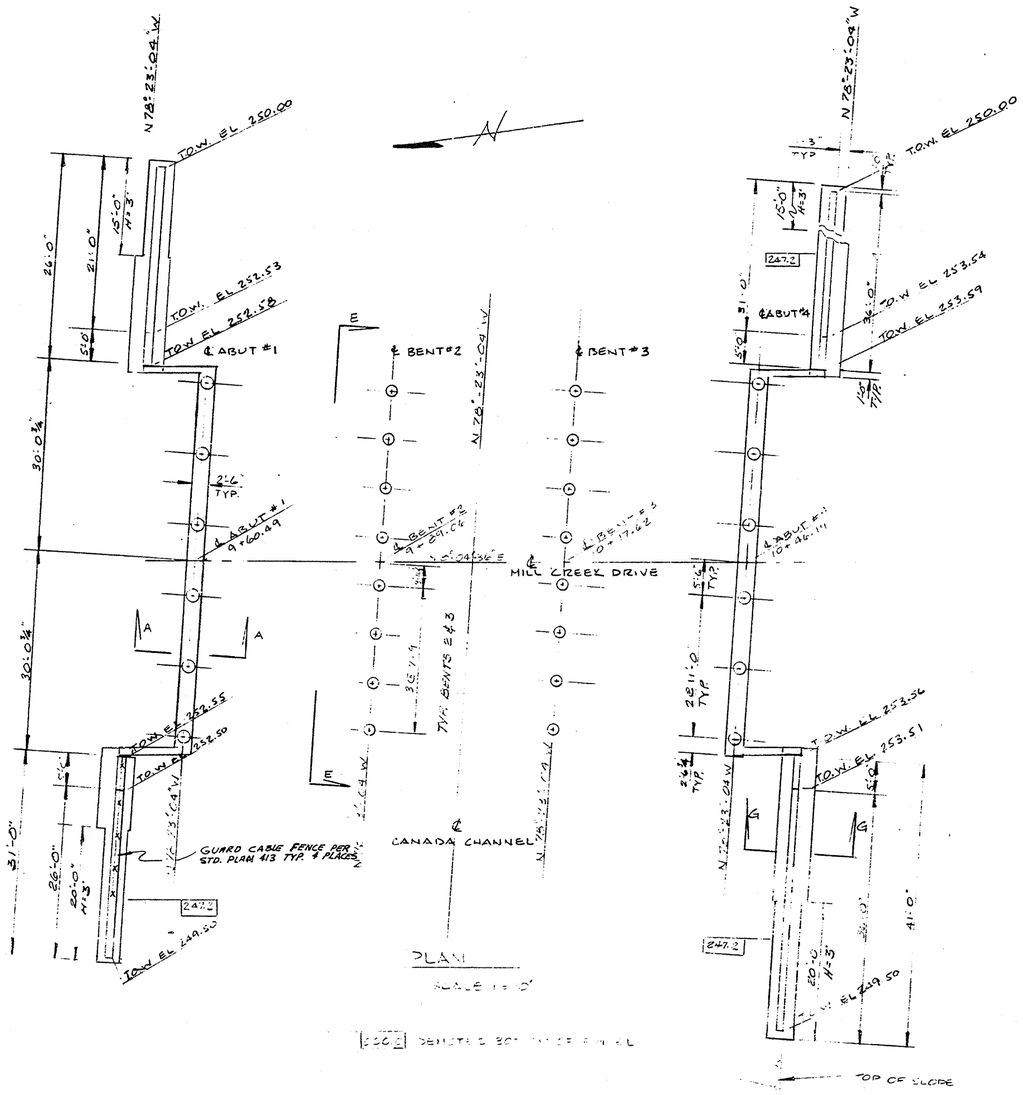

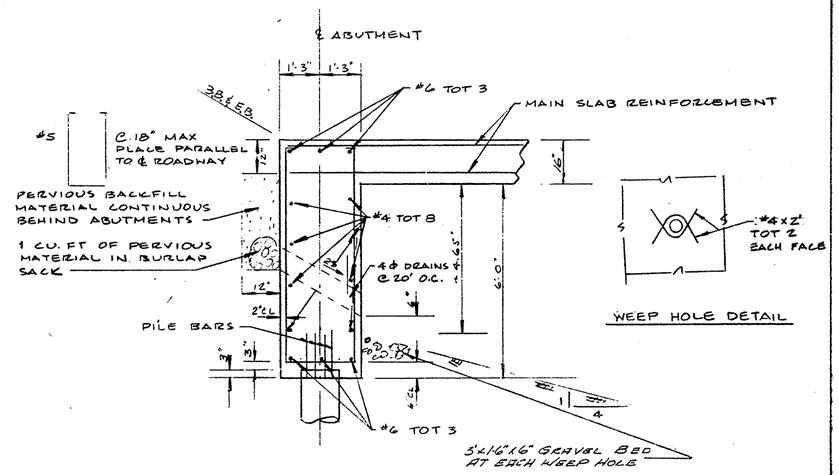

ABUTMENT SECTION A-A

SCALE ½" = 1'-0"

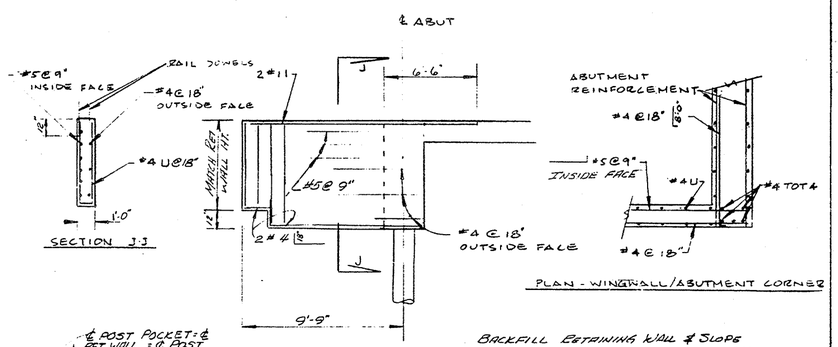

BACKFILL RETAINING WALL & SLOPE PRIOR TO ABUTMENT BKFL. AT W.I.D.

WINGWALL ELEVATION

SCALE ¼" = 1'-0"

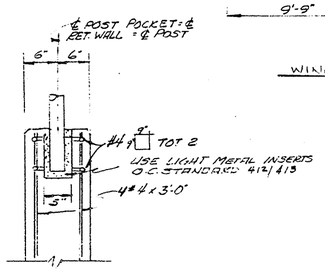

POST ANCHORAGE DETAIL

1" = 1'-0"

Dr. 7 13150
Street Improvements
Sheet 10 of 13
Red 24;1
Cronaflex

SHEET 10/13

CANADA CHANNEL BRIDGE

ABUTMENT PLAN AND ABUTMENT DETAILS

DR.7 13150