12-14-11

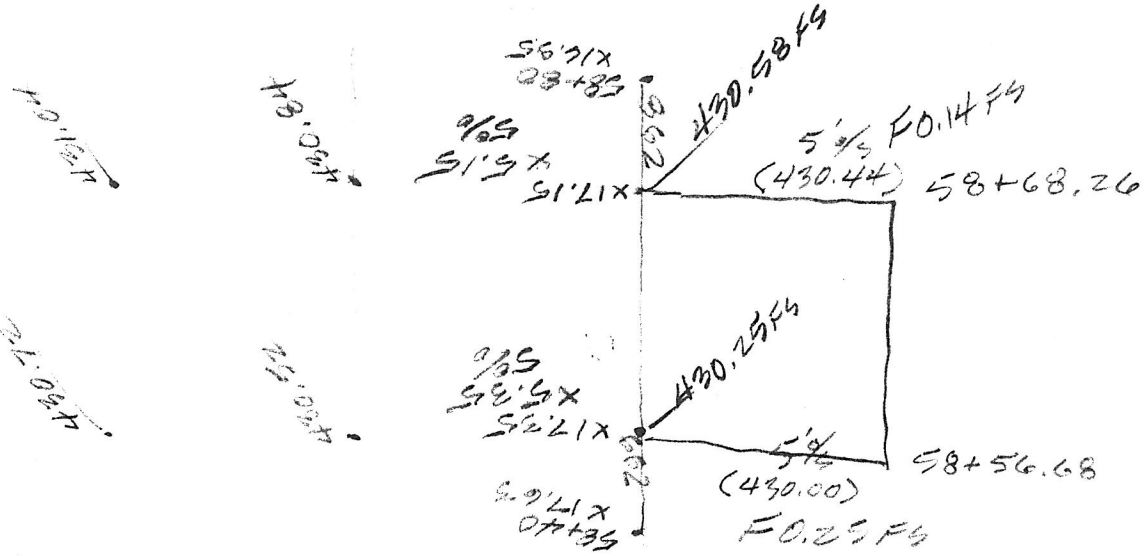
58+68.26
58+56.68
(430.44)
(430.00)
F0.14 FG
F0.25 FG
430.58 FG
430.25 FG

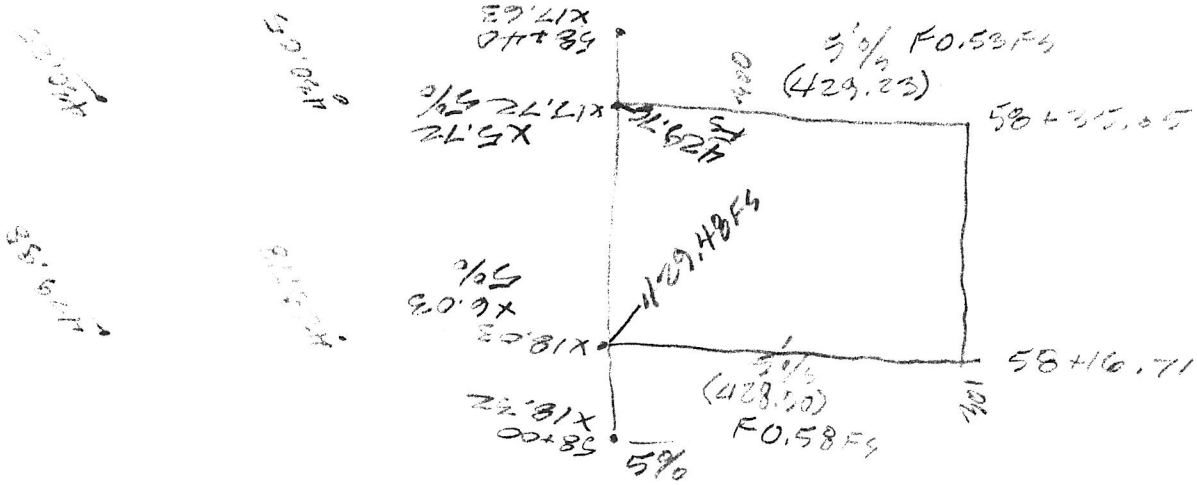
58+16.71
(429.23)
(428.20)
F0.53 FG
F0.58 FG
429.48 FG

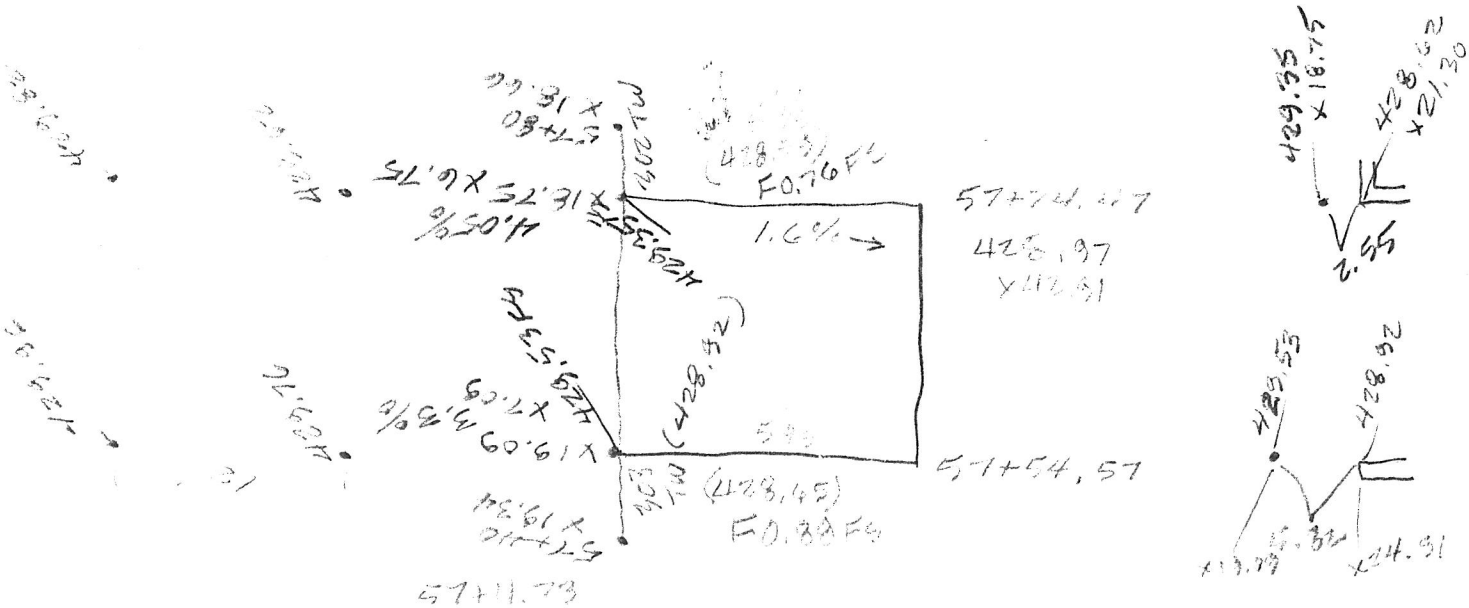
57+54.57
57+11.73
(428.97)
(428.45)
F0.76 FG
F0.88 FG
1.6%
14.05%
13.75%
428.97
429.55
428.62
2.55
428.53
428.92
6.32