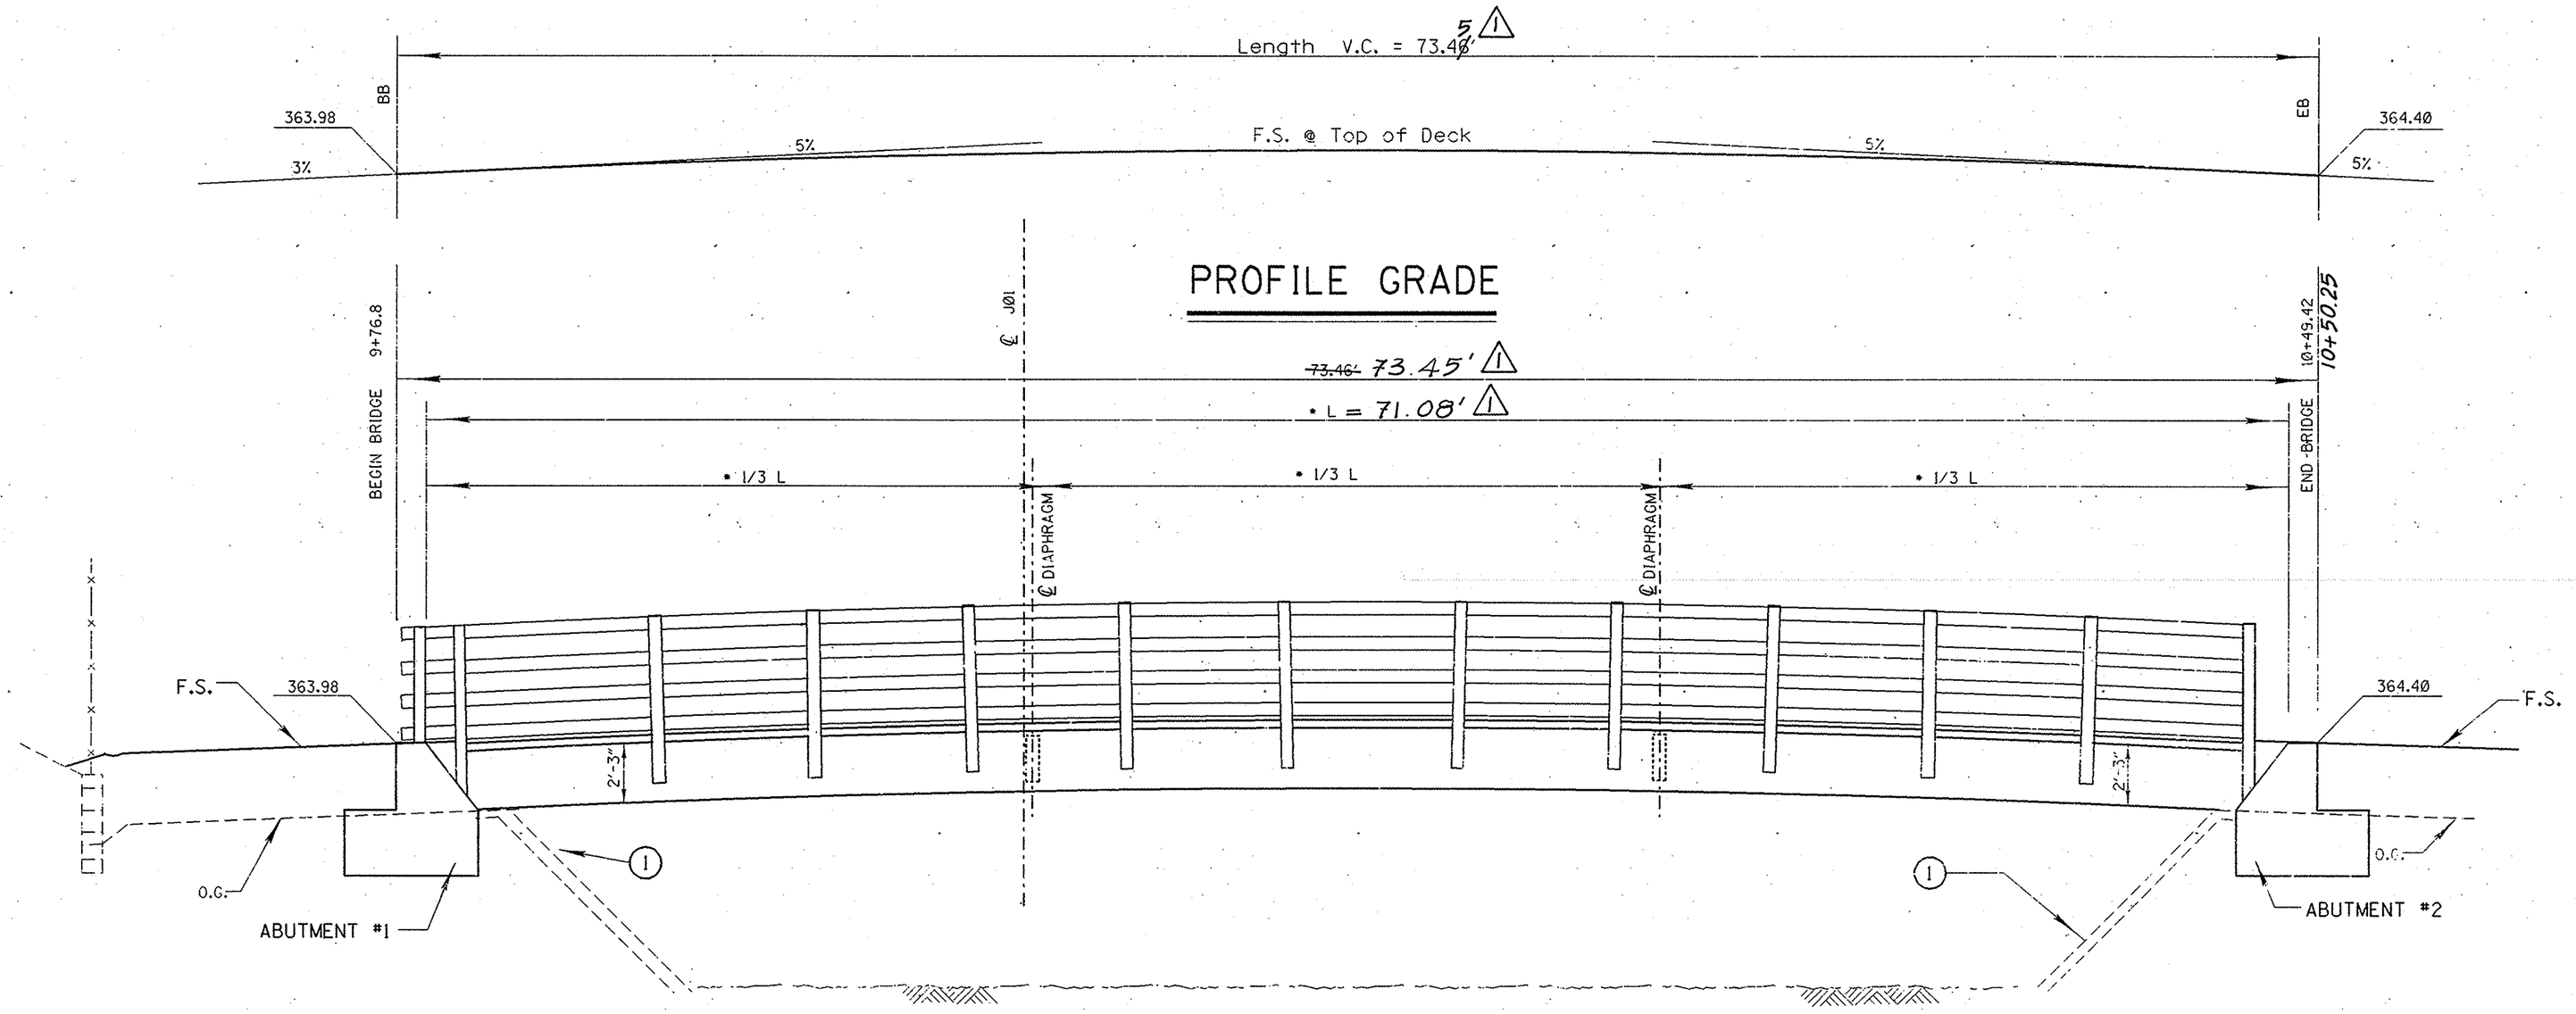

ELEVATION

SCALE: 1"=4'-0"

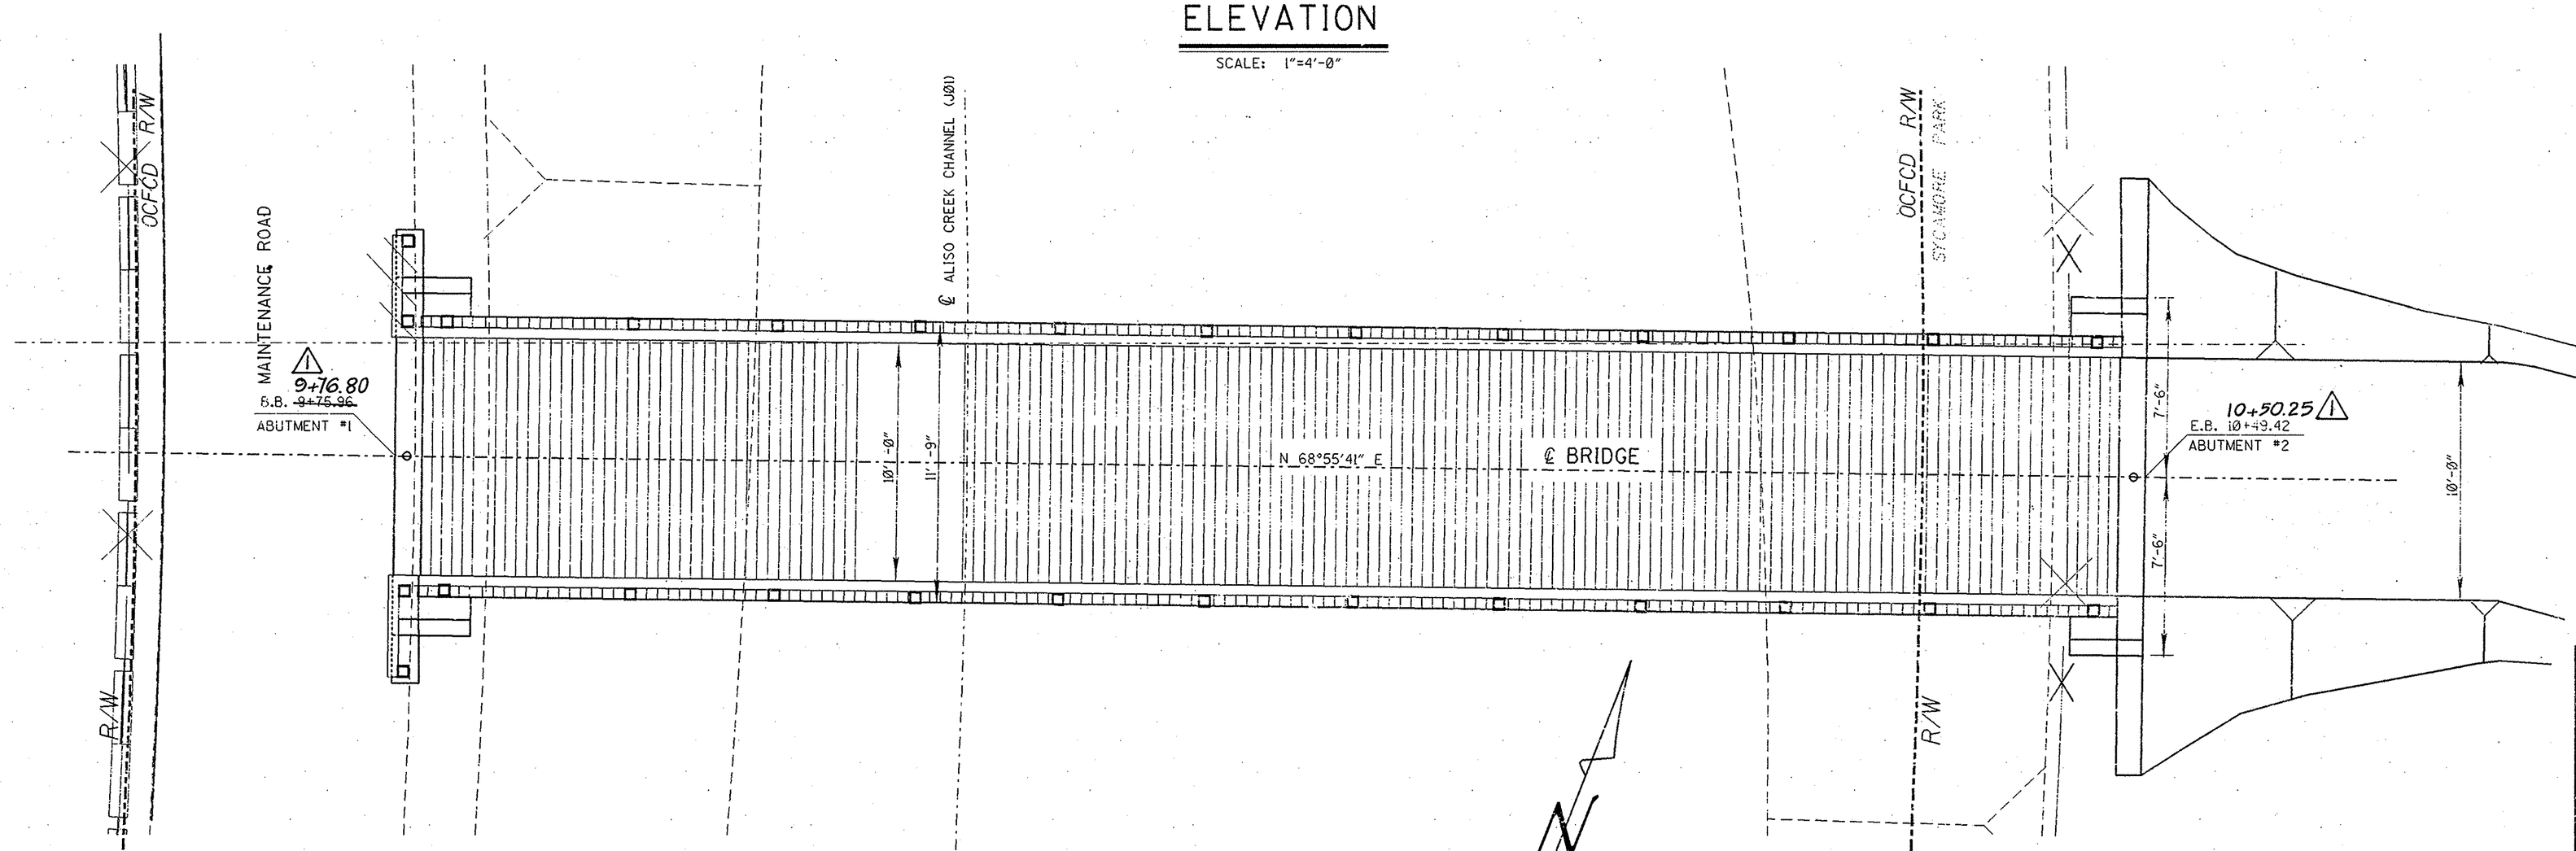

PLAN

SCALE: 1"=4'-0"

GENERAL NOTES

DESIGN: PER AASHTO DATED 1983 AS MODIFIED BY CALTRANS.

LIVE LOAD: 85 psf FOR PEDESTRIAN LOAD PER AASHTO
WIND LOAD IN ACCORDANCE WITH AASHTO.

MATERIALS: GRIDERS - 24F-V4 DF/DF
DECKING, HANDRAILS, POSTS - REDWOOD OR ALASKAN CEDAR, NO. 1 (ALL HEARTWOOD)
1 CCO#2 ~~ALL EXPOSED TIMBER SEALED WITH WOODLIFE II OR EQUIVALEANT~~
ABUTMENT - 560-C-3250 PCC
REINFORCING STEEL - ASTM A615 Schedule 60
HARDWARE - ASTM A307 AND A325

NOTE:

- L = LENGTH OF GIRDER, TO BE FIELD MEASURED AND VERIFIED BY CONTRACTOR PRIOR TO FABRICATION OF GIRDERS.

LEGEND

1. PROTECT IN PLACE
2. REMOVE
4. MATCH EXISTING

1 1/2 0 1 2
3 inches on original drawing

MARK	DATE	DESCRIPTION
1	5/4/92	AS SHOWN

REVISIONS

PREPARED UNDER SUPERVISION OF REGISTERED PROFESSIONAL ENGINEER RICHARD A. HART No. 39595 Exp. 12/31/93 CIVIL STATE OF CALIFORNIA

8/21/91
DATE

RICHARD HART
RCE 39595 (exp. 12-31-93)

ORANGE COUNTY
ENVIRONMENTAL MANAGEMENT AGENCY

ALISO CREEK (J01)
PEDESTRIAN BRIDGE
AT SYCAMORE PARK

GENERAL PLAN

DESIGNED RRS			SHEET
DRAWN GARCIA		CHECKED RAH	3
SCALE AS SHOWN	DATE 9-91	DRAWING NO.	OF 6