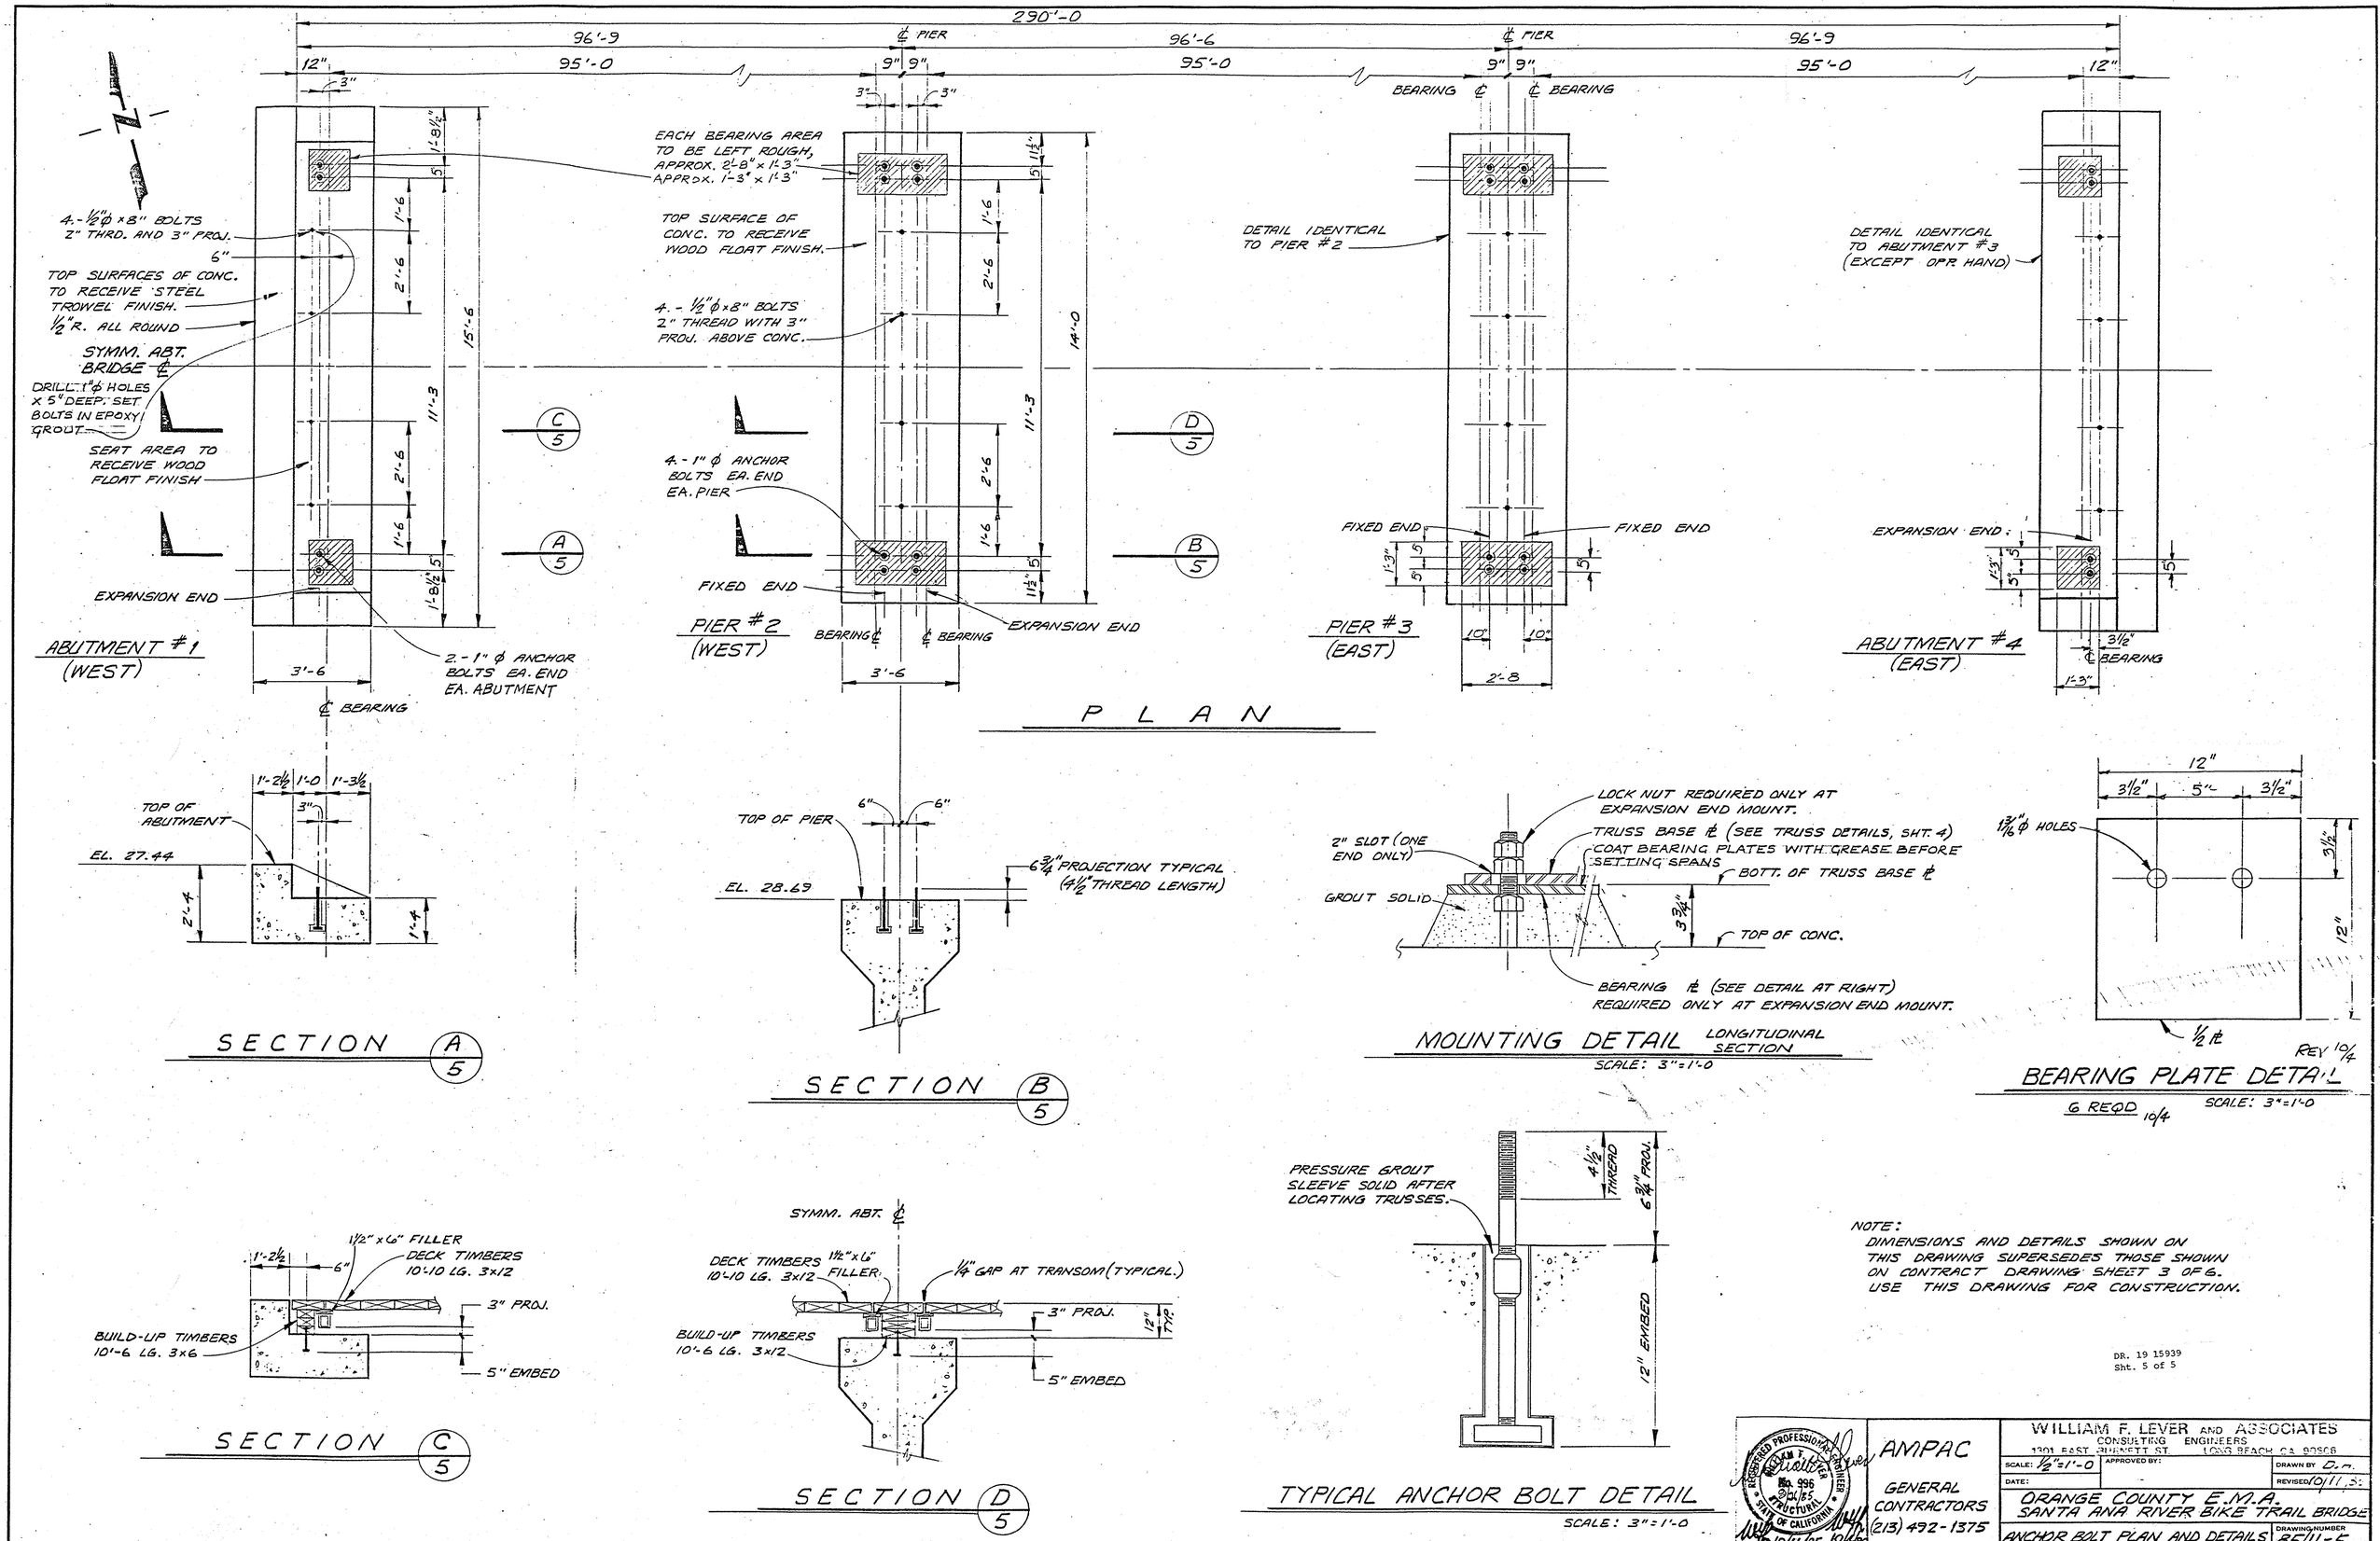

24 X 36 PRINTED ON NO. 1000H CLEARPRINT