


TRUSS TOP PLAN

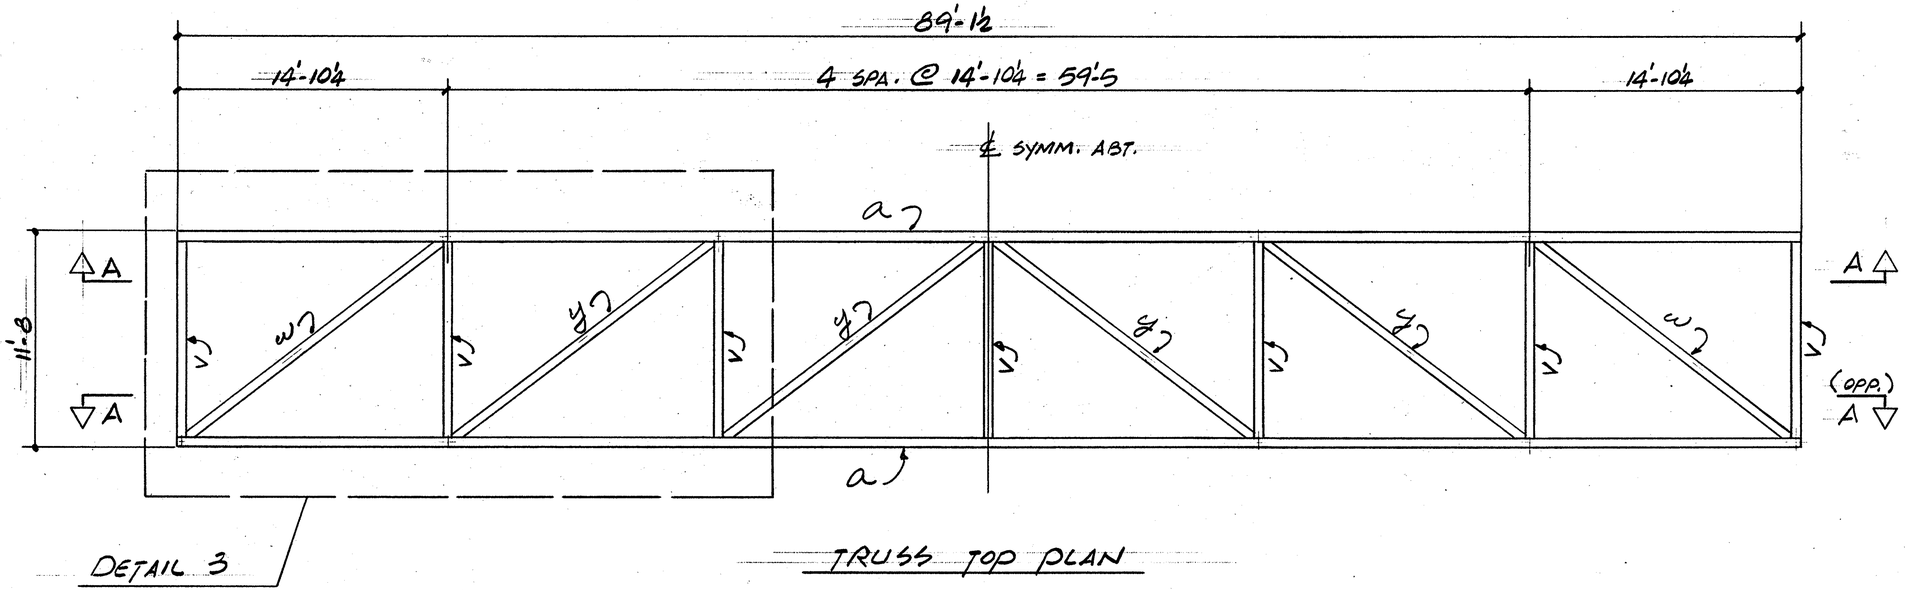


ENLARGED DETAIL 3

WORK THIS DWG. WITH DWG. Nos 5, 6 & 7

| NO. | DATE | DESCRIPTION |
|---|---|---|
| △ | | |
| △ | | |
| △ | | |
| △ | | |
| △ | | |
| △ | | |
| △ | | |

REVISIONS

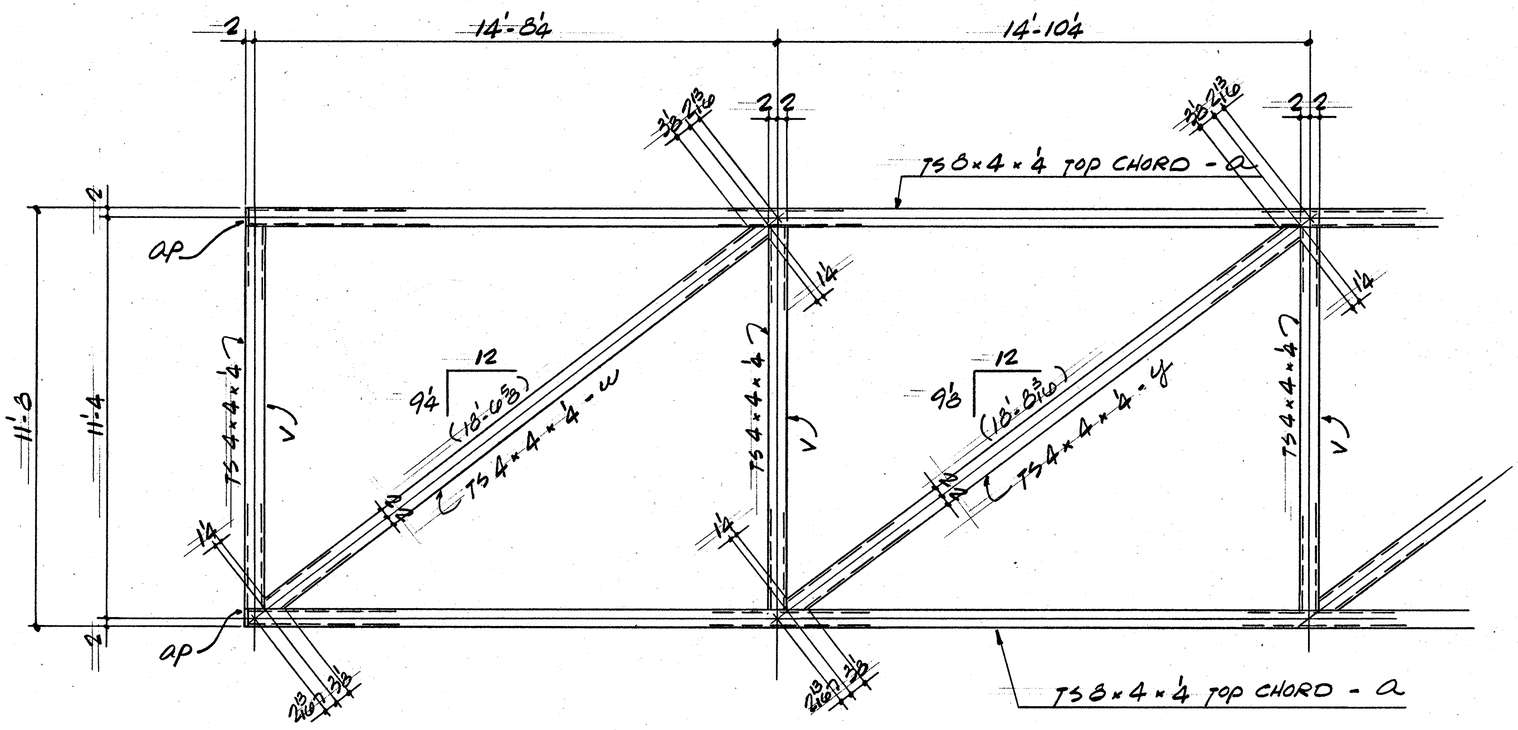THIS DWG AND ALL INFORMATION HEREON IS THE PROPERTY OF PLAS-TAL MFG. CO., INC. AND IS LENT TO THE BORROWER FOR HIS CONFIDENTIAL USE ONLY. ALL RIGHTS OF DESIGN & DETAILS ARE RESERVED.

SCALE:

DRAWN BY: JC DATE: 9/92

CHECKED BY: J DATE: 9/92

APPR'D BY: DATE:

APPR'D BY: DATE:

CUST. P.O. NO.

PMC
PLAS-TAL MFG. CO., INC.
8815 SO. SORENSEN AVE. SANTA FE SPRINGS, CALIF.
213 • 685-6874 213 • 691-0517

CUSTOMER: SOUTH UNDERGROUND CONST.

JOB DESCRIPTION: BIKE TRAIL BRIDGE

LOCATION: SANTA ANA RIVER

WORK ORDER NO.: J-4602

DWG. NO.: 8

REV.: △

SAR Bike Trail Bridge 422'U/S of Imperial Hwy 5/1992
Sht. 13/17