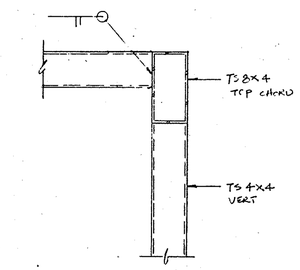

4

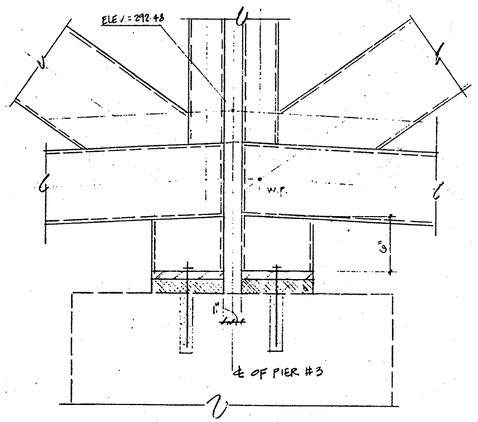

3

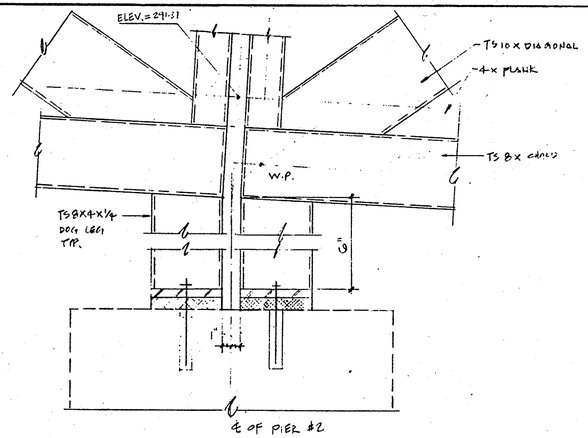

2

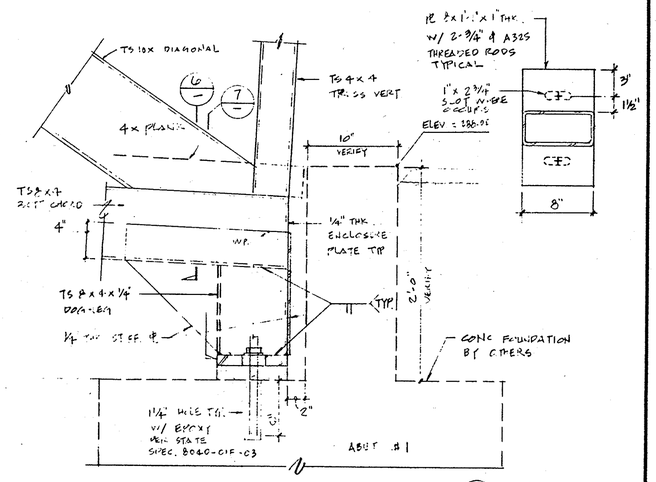

1

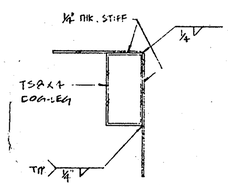

8

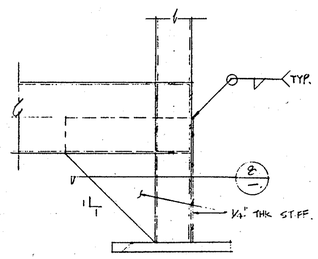

7

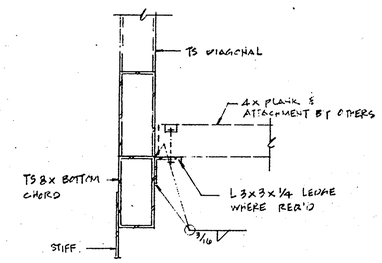

10

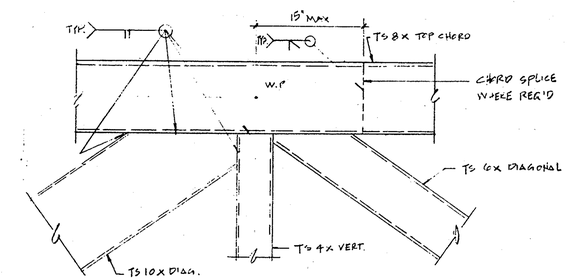

5

PLAS-TAL MFG. CO., INC.
8815 SO. SORENSEN AVE. SANTA FE SPRINGS, CALIF.
213 • 685-6874 213 • 691-0517

WORK ORDER NO.	DWG. NO.	REV.
J-4602	E4.	△

IMPERIAL HIGHWAY BIKE BRIDGE
ACROSS SANTA ANA RIVER

SIDNEY YUEN CONSULTING ENGINEER
1907 LERONA AVENUE
ROWLAND HEIGHTS, CA 91748
(818) 912-0568

SHEET
S-3

SAR BIKE TRAIL AUG 27 1992 5/92 SHT 17/17
BR. 428 U/S OF IMPERIAL HWY