
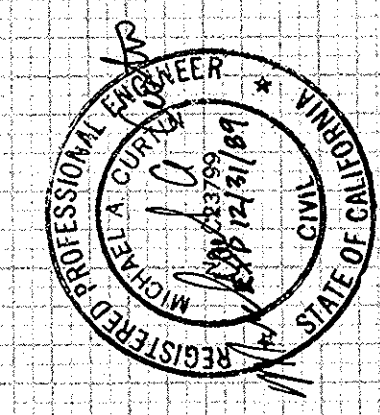


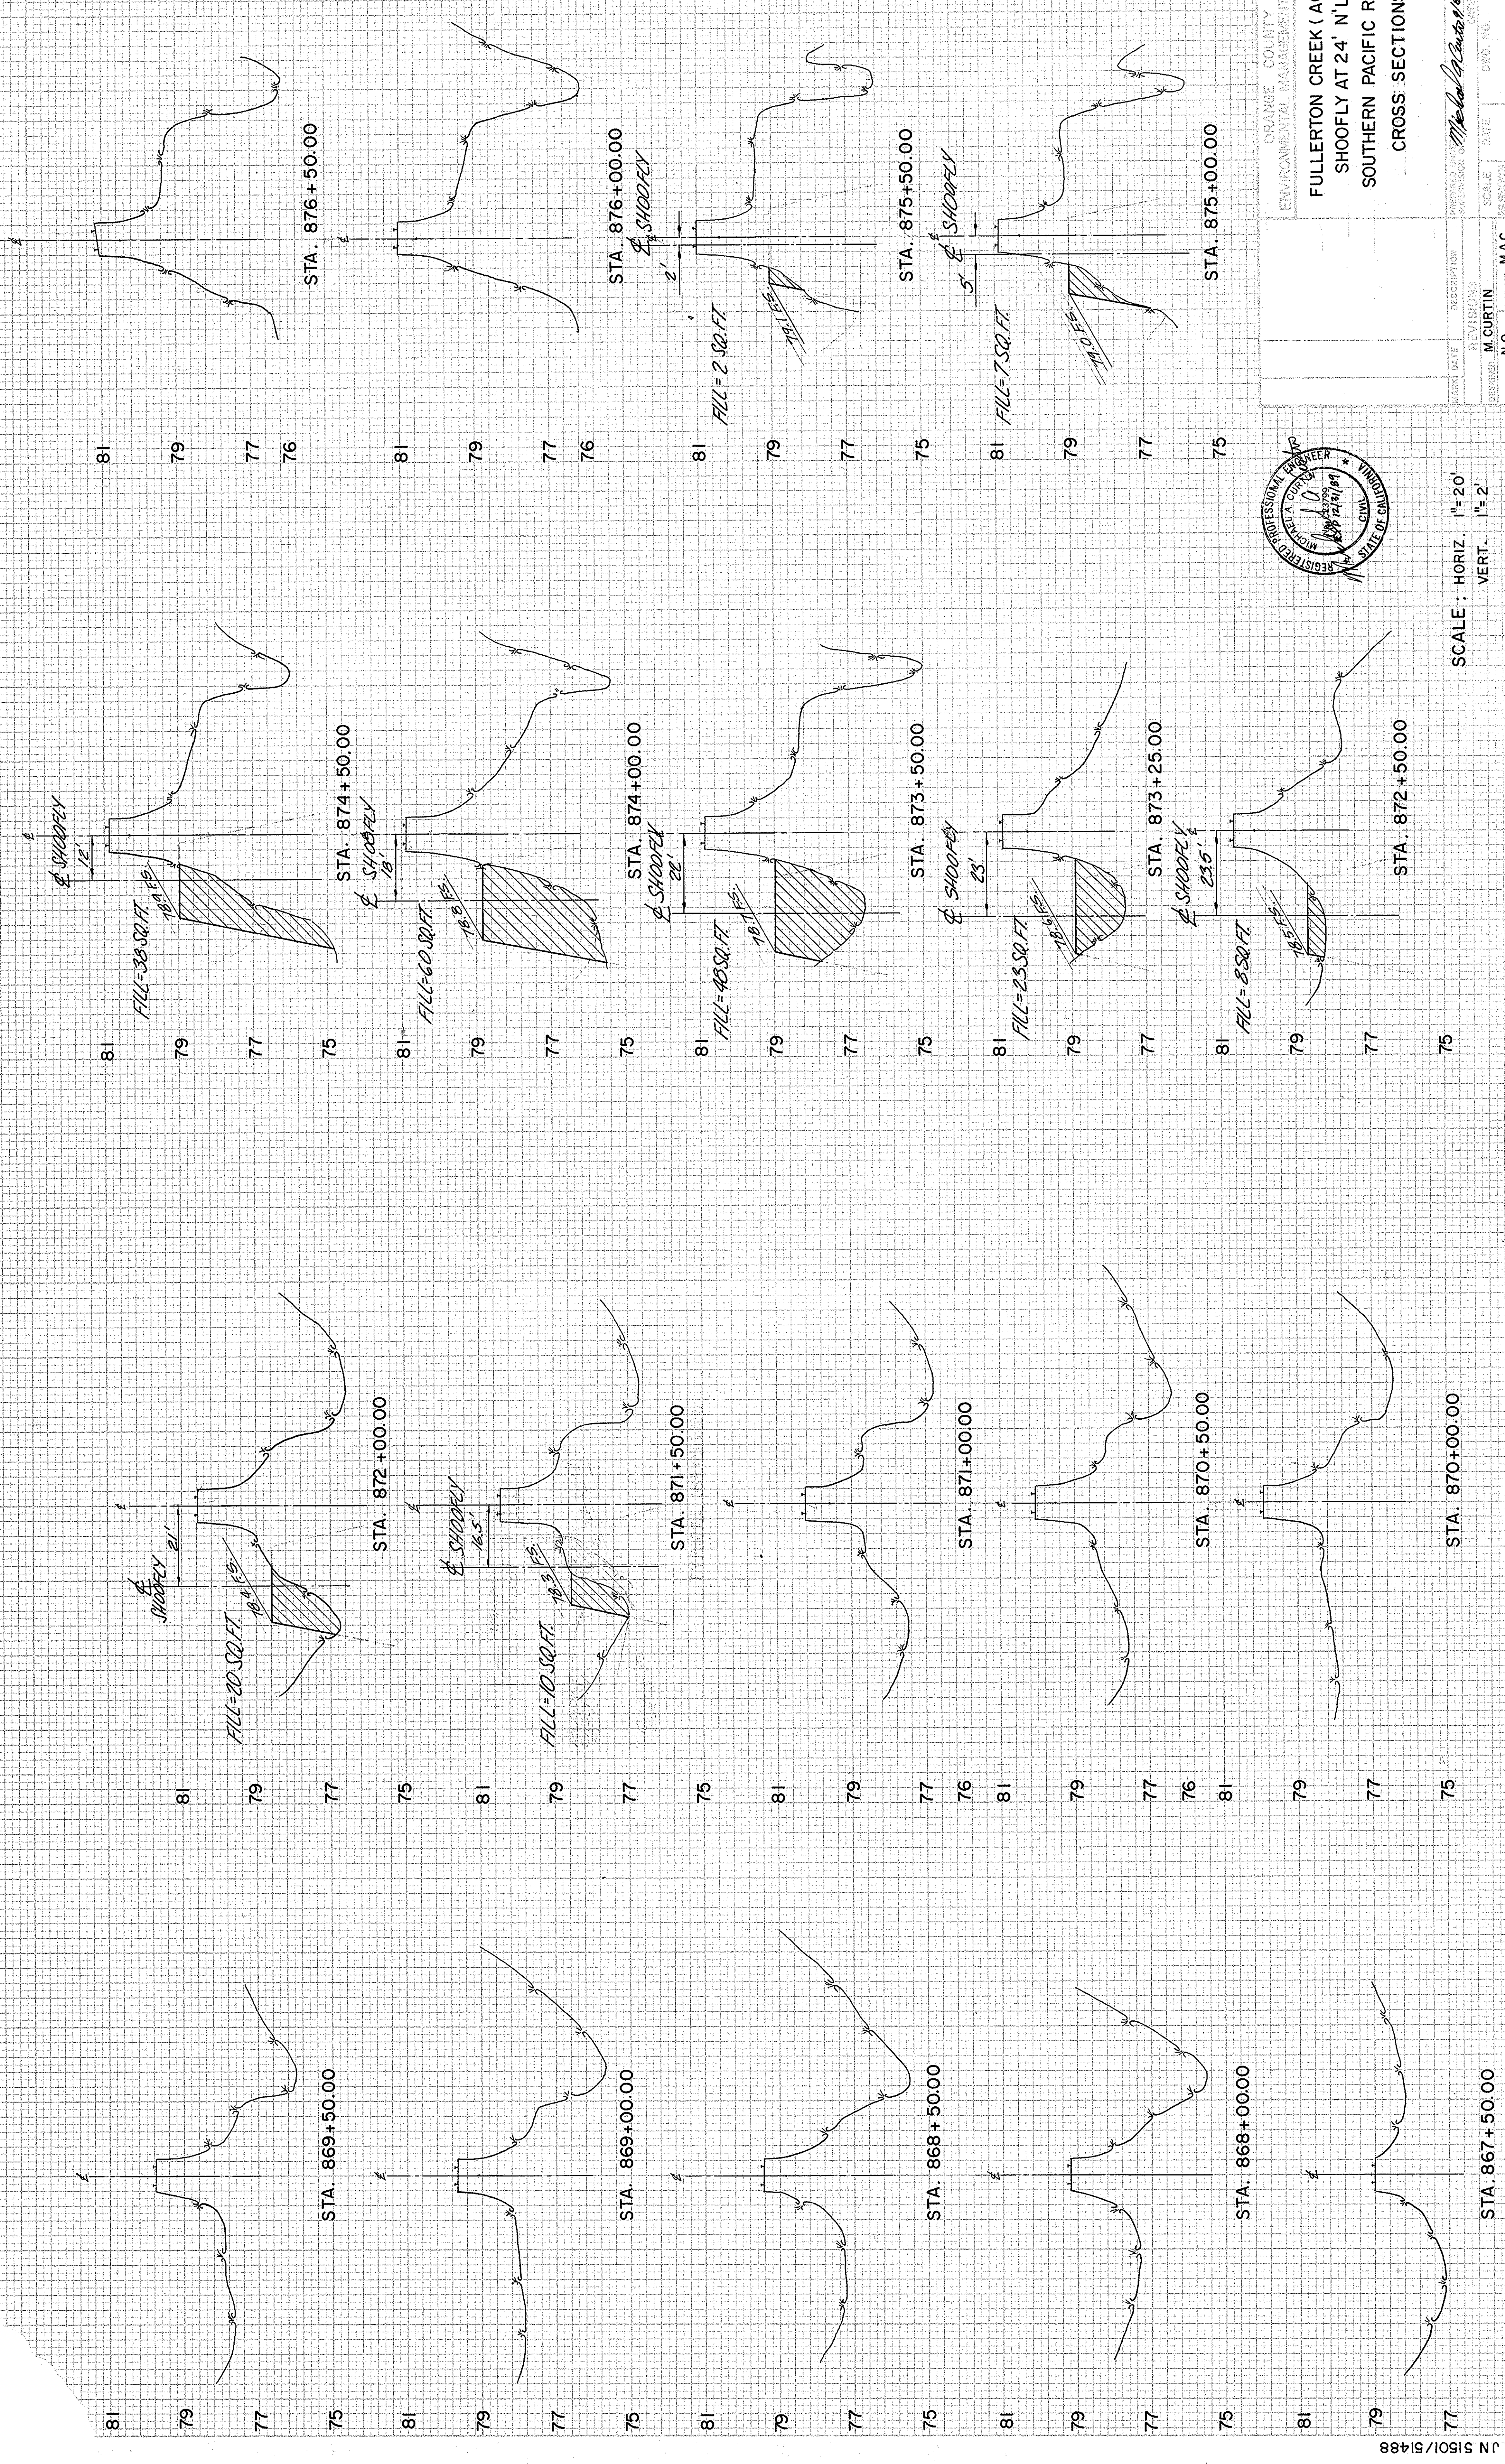

SCALE : HORIZ. 1"=20'
VERT. 1"=2'

ORANGE COUNTY ENVIRONMENTAL MANAGEMENT AGENCY		FULLERTON CREEK (A03) SHOOFLY AT 24' N'LY SOUTHERN PACIFIC R/R CROSS SECTIONS	
DATE	DESCRIPTION	REVISIONS	SHEET
NO.	M. CURTIN		11
NO.	NO.	NO.	OF 11