


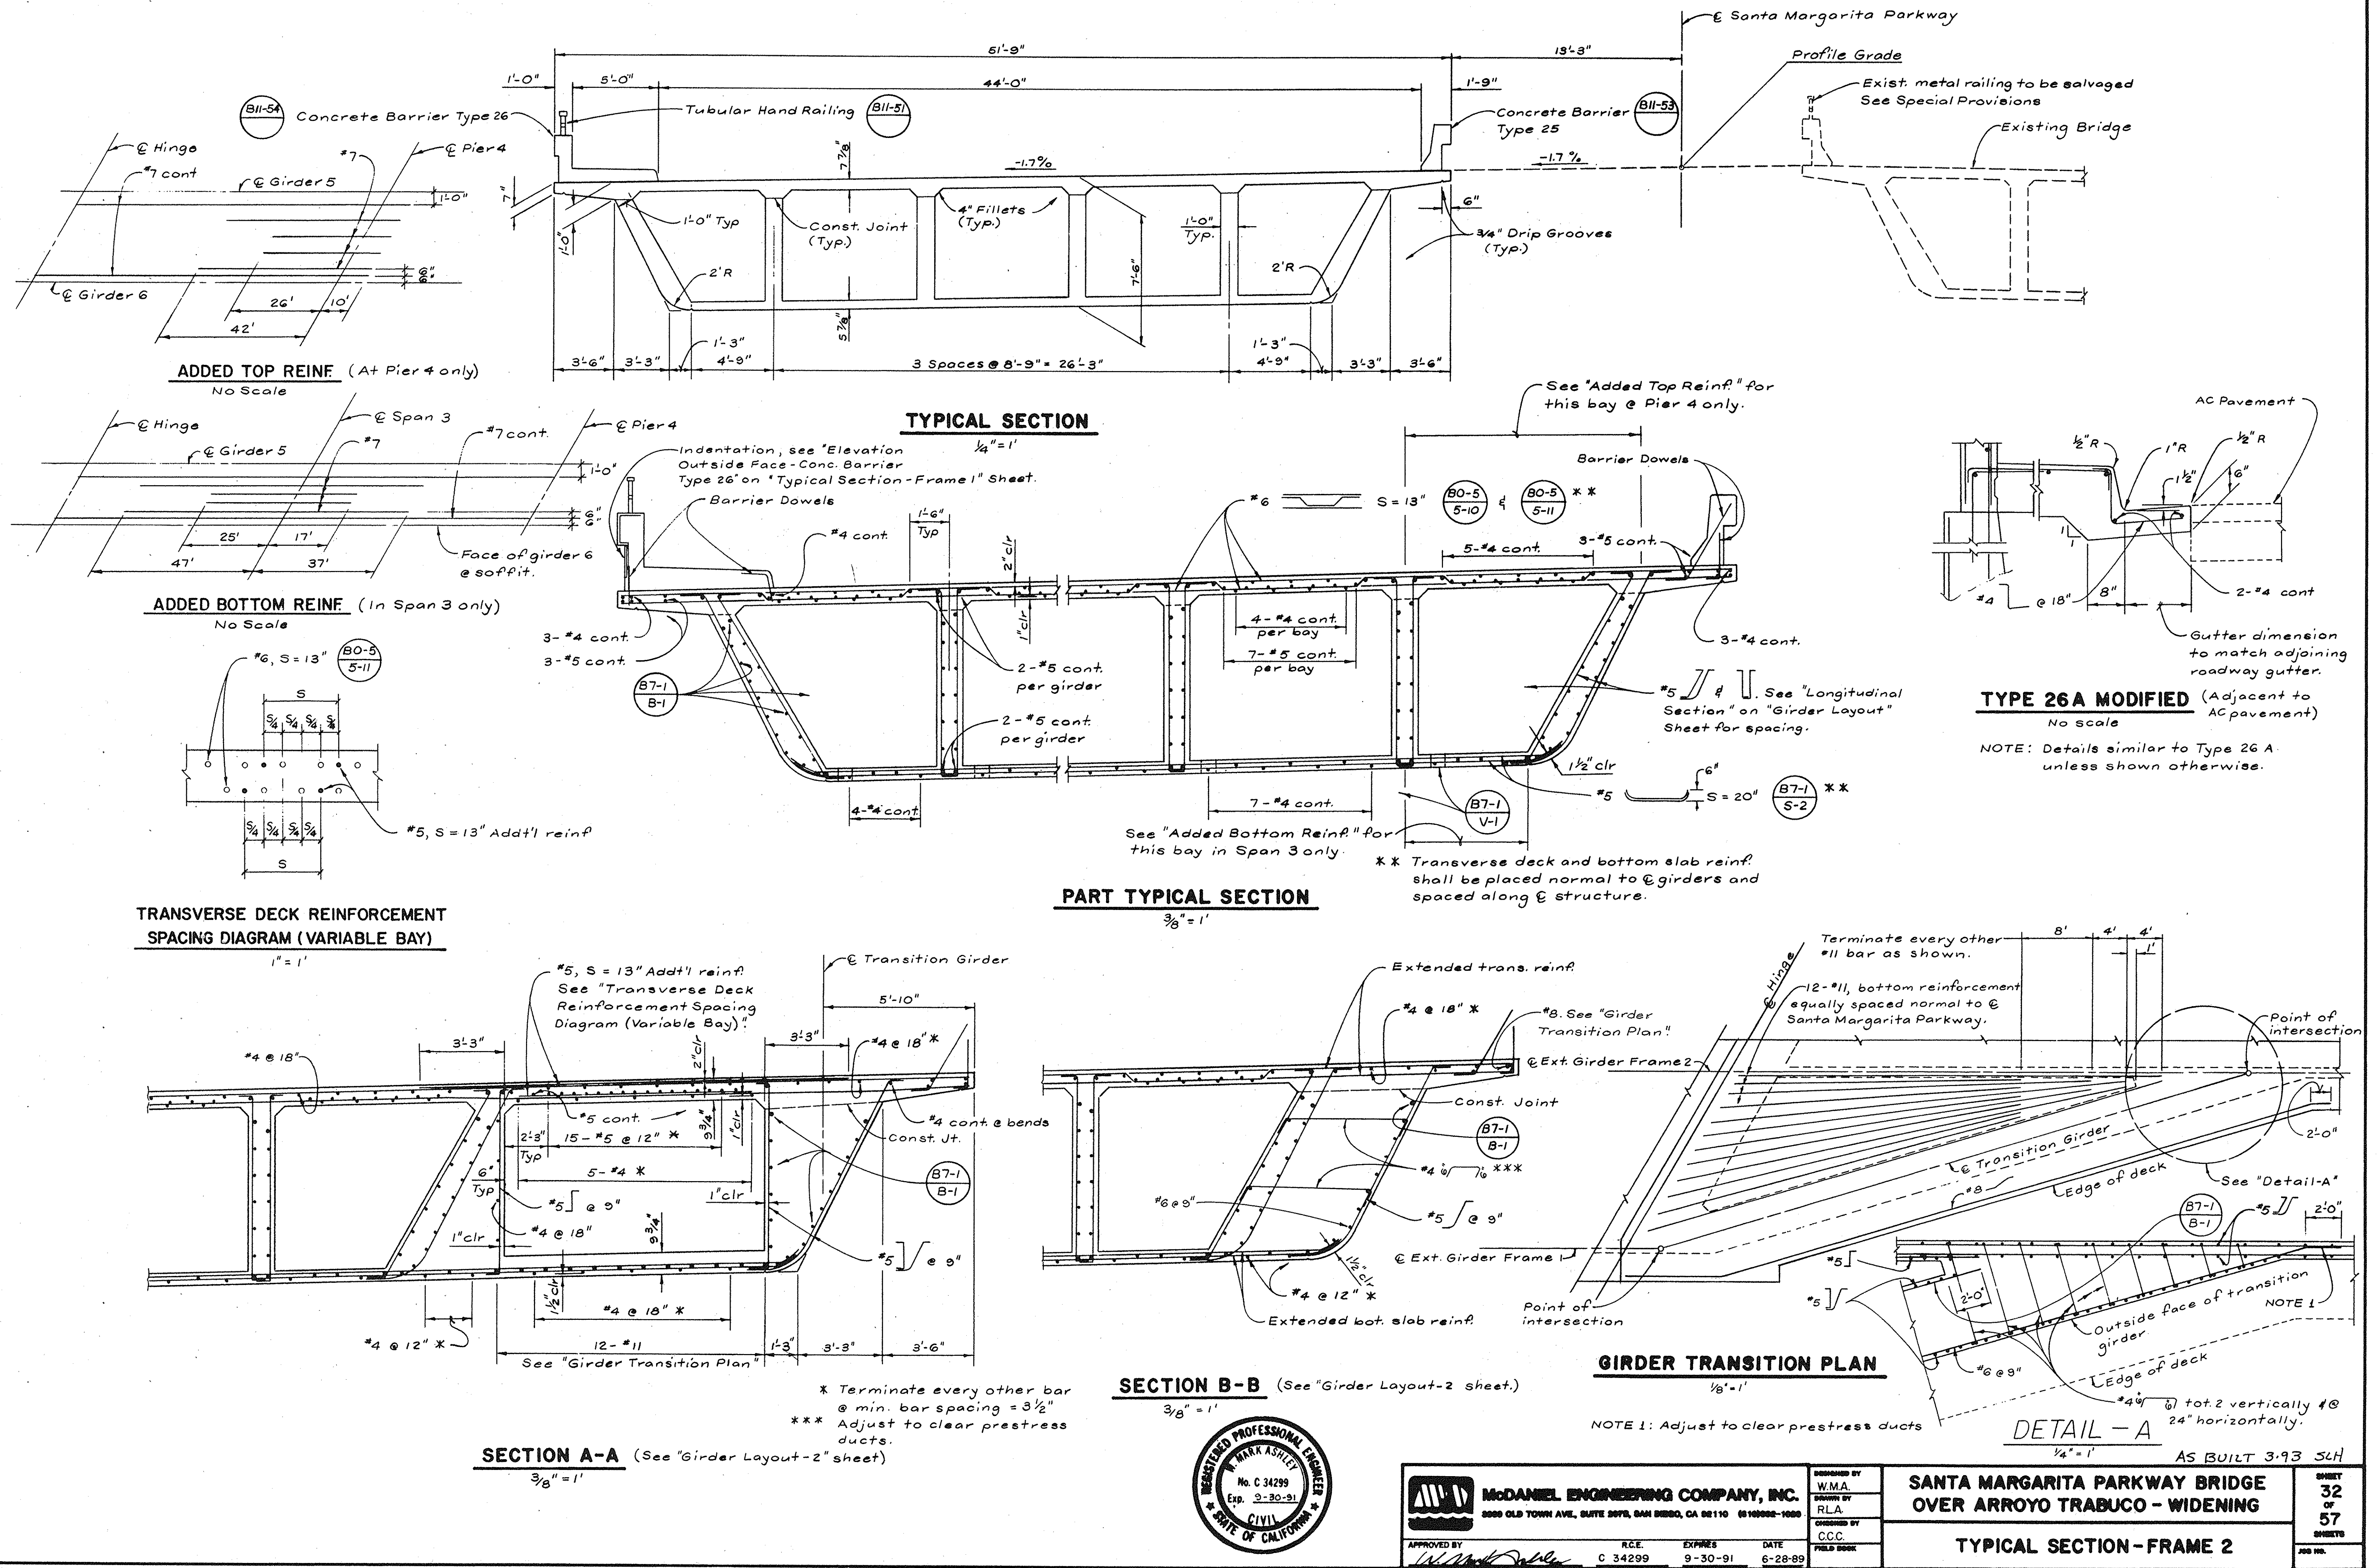

DR 19.15799