


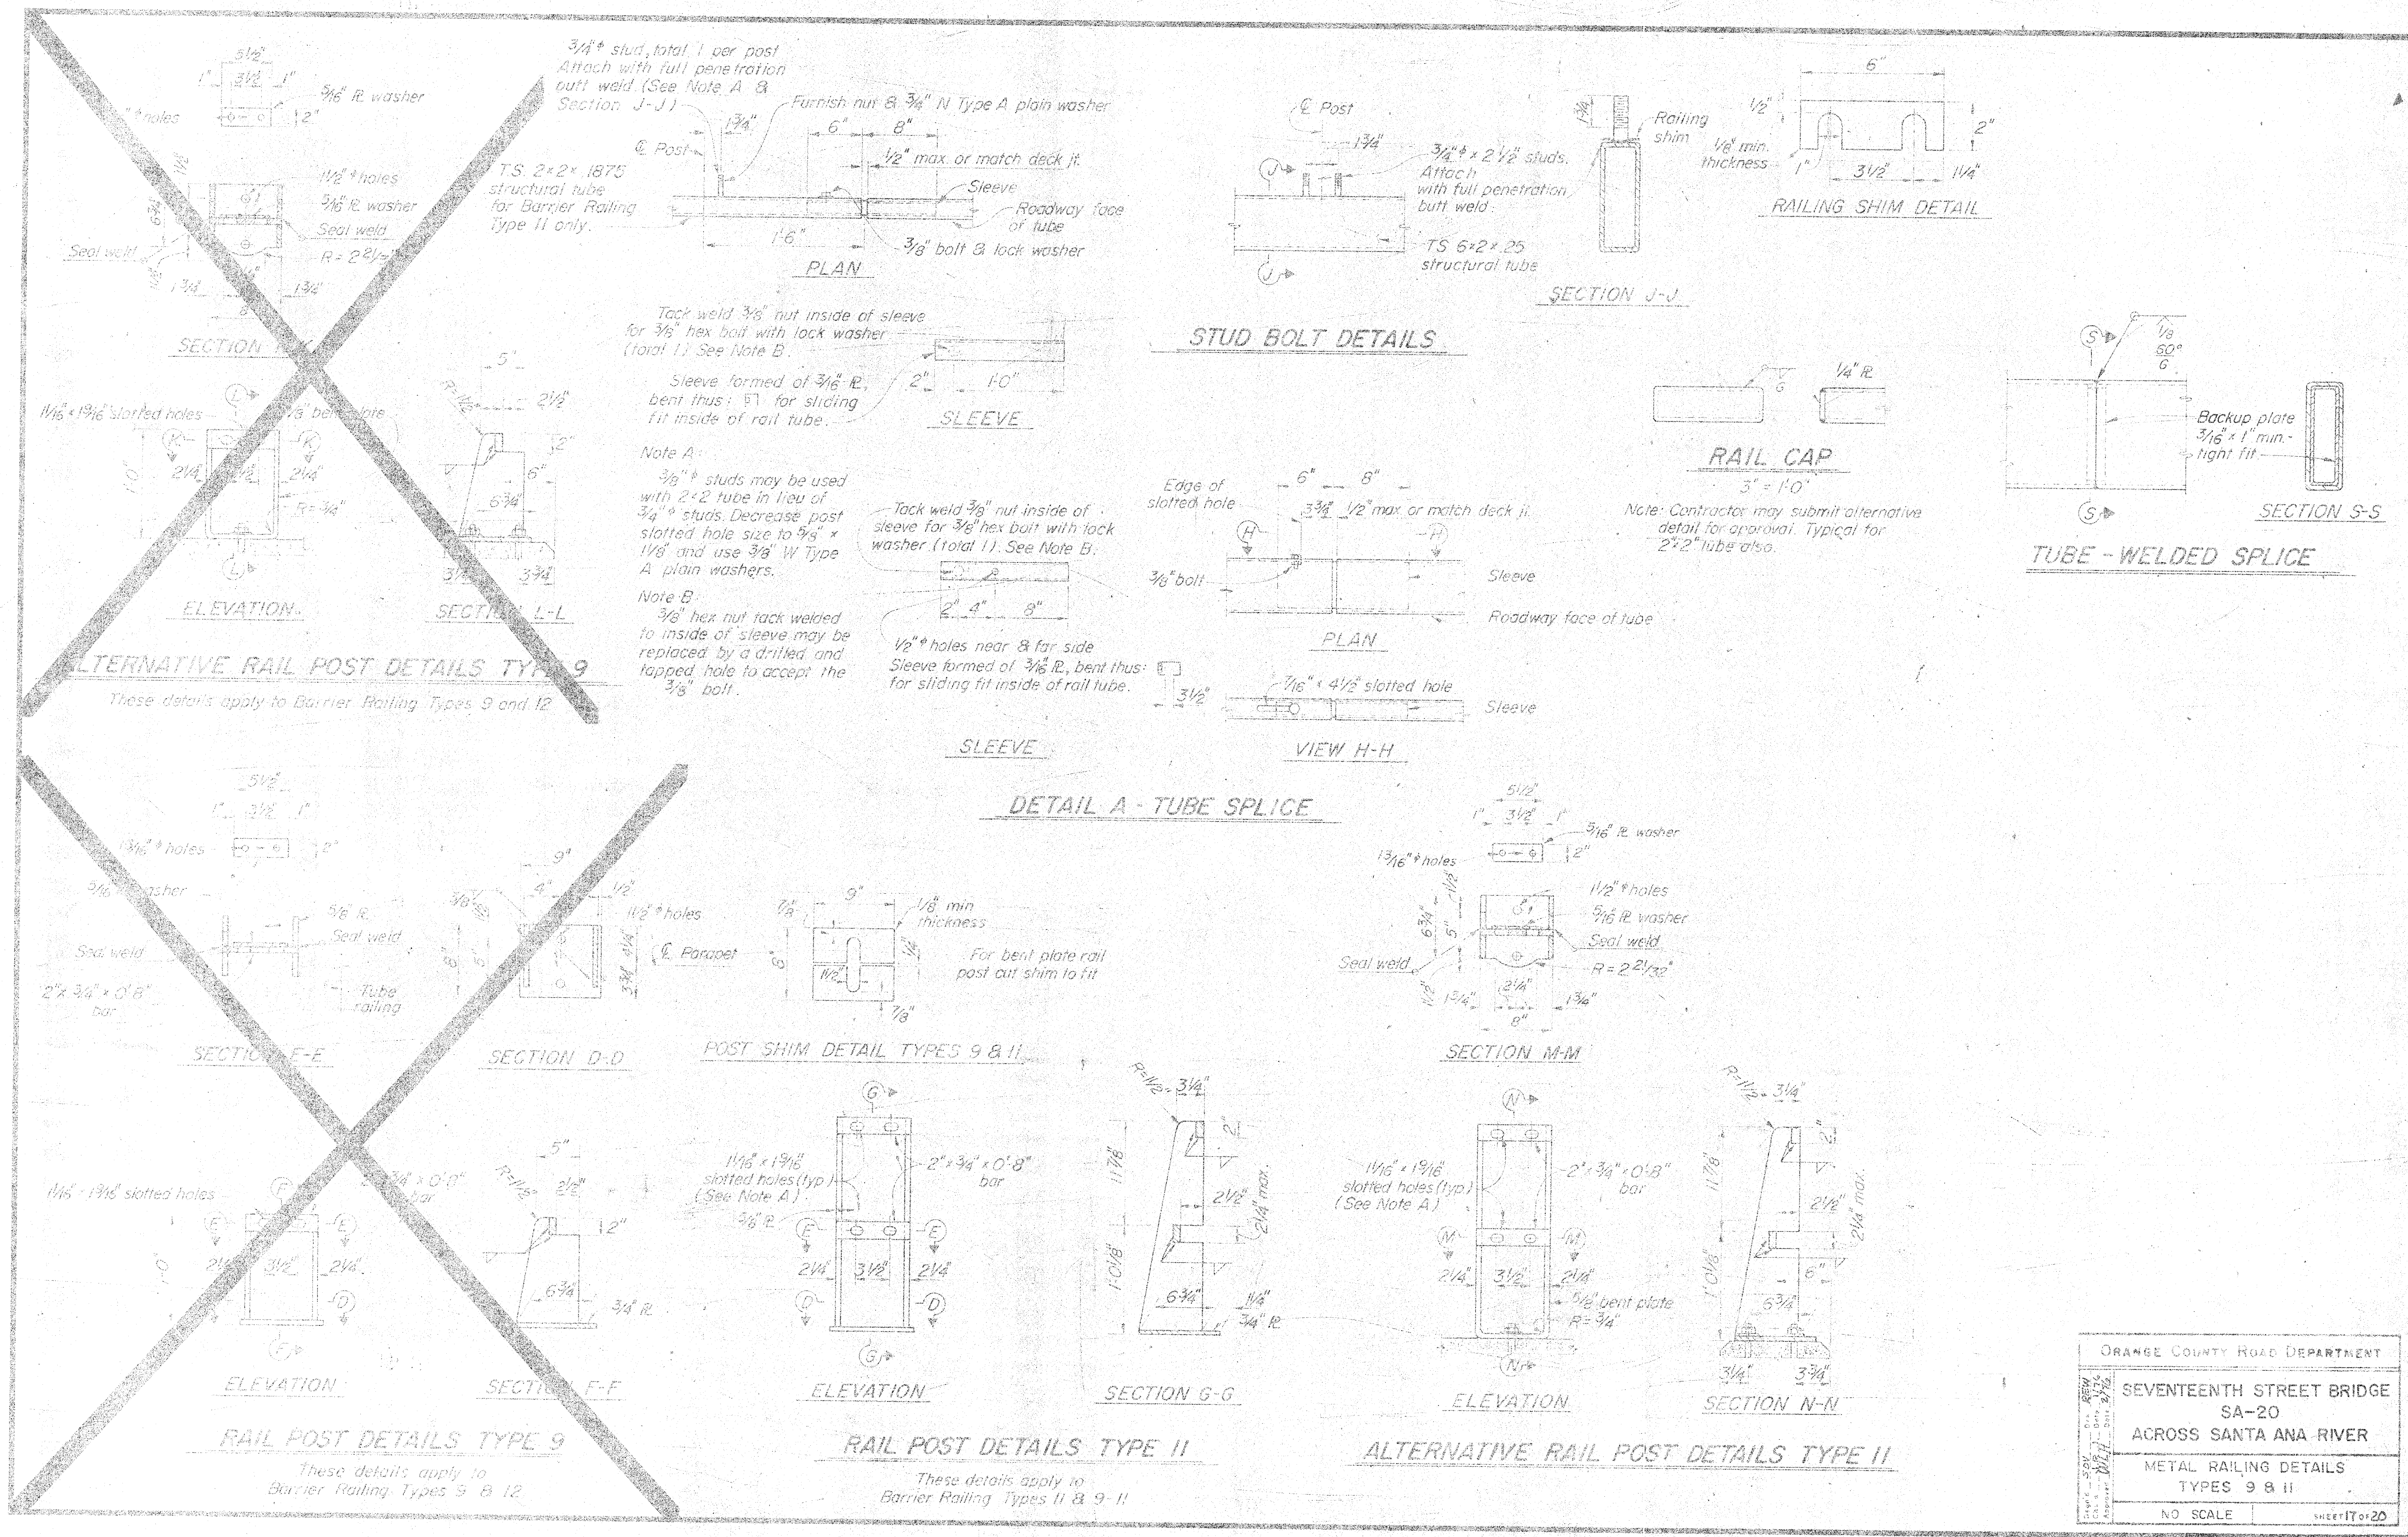

ORANGE COUNTY ROAD DEPARTMENT	
SEVENTEENTH STREET BRIDGE	
SA-20	
ACROSS SANTA ANA RIVER	
METAL RAILING DETAILS	
TYPES 9 & 11	

