
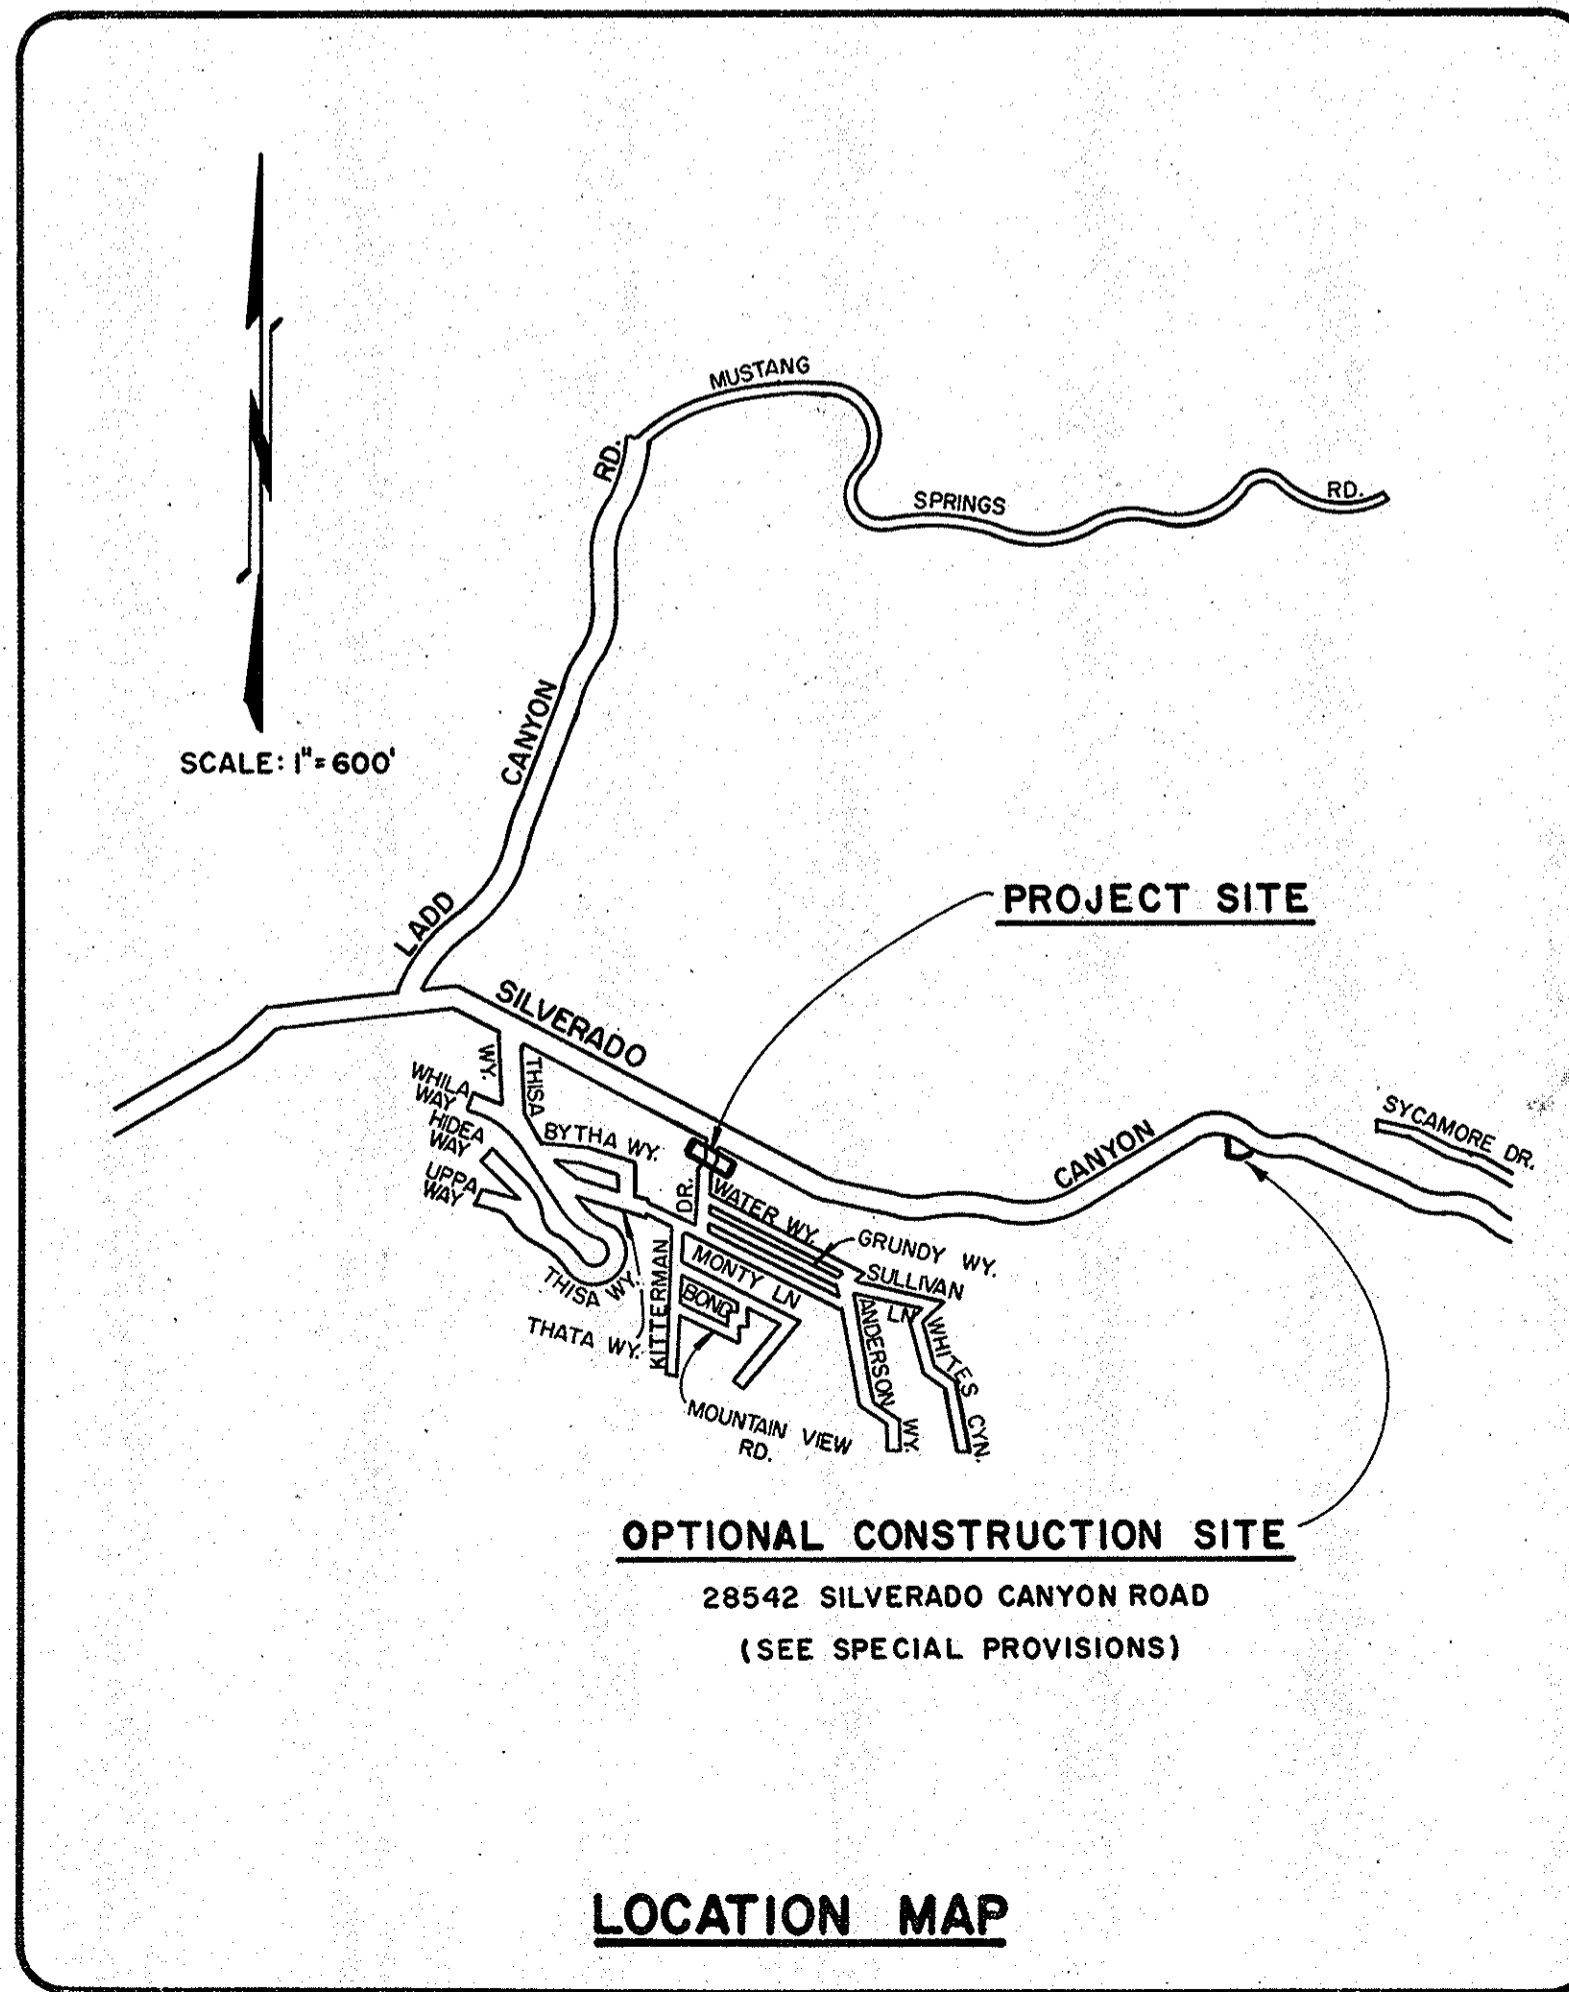


ORANGE COUNTY ENVIRONMENTAL MANAGEMENT AGENCY

SANTA ANA, CALIFORNIA
M. STORM, DIRECTOR

PLANS FOR PLANS FOR THE RESTORATION OF KITTERMAN DRIVE BRIDGE DECK

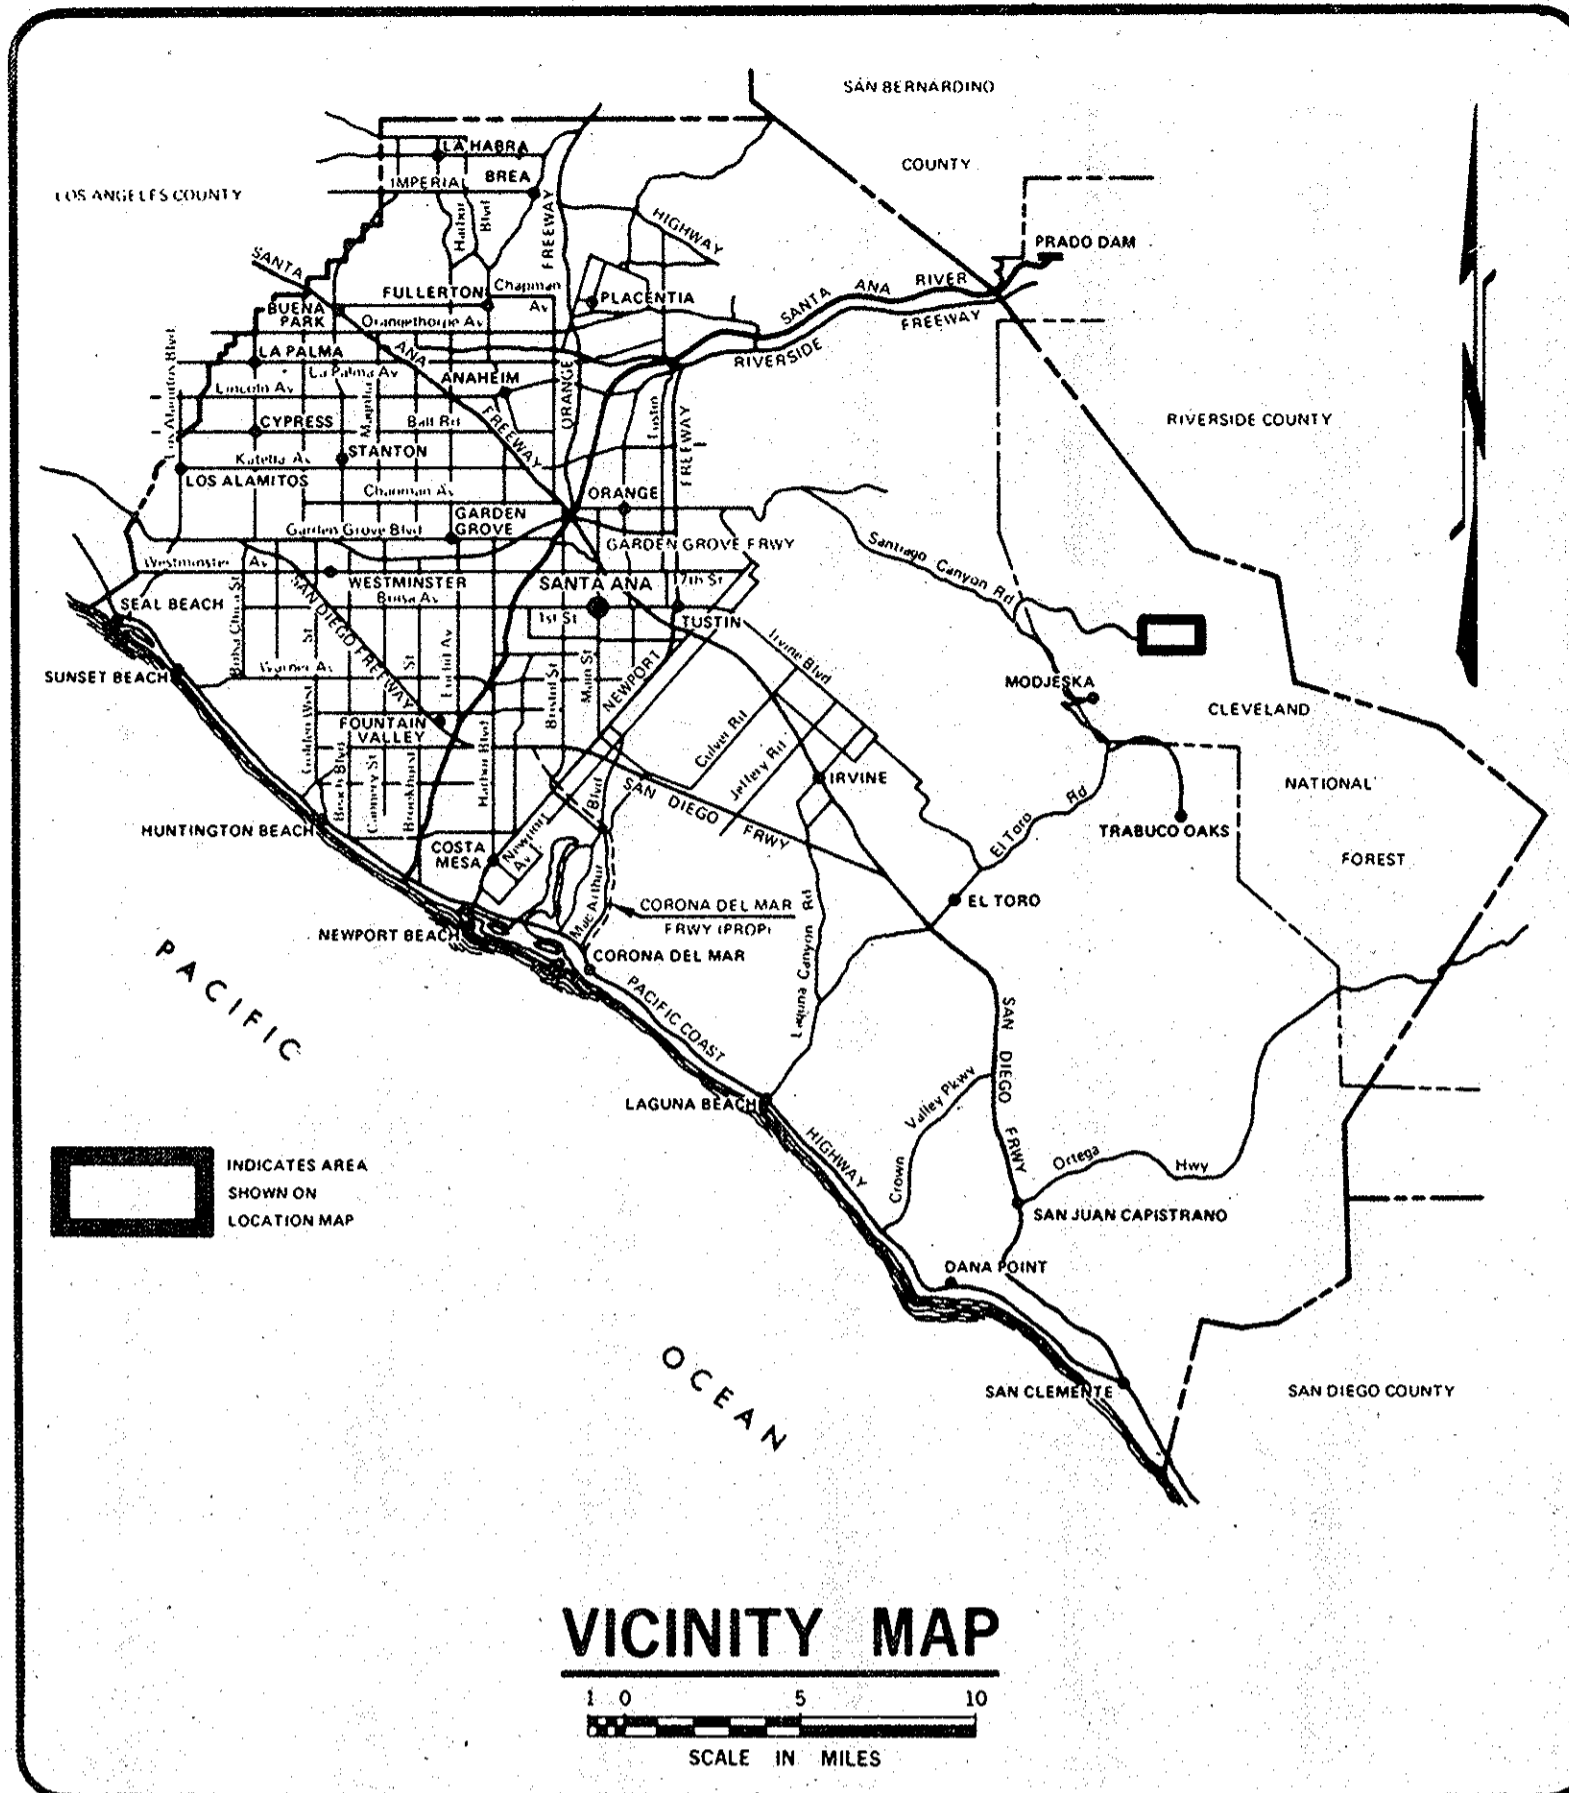

INDEX OF SHEETS	
SHEET	DESCRIPTION
1	TITLE SHEET
2	PLANS FOR BRIDGE DECK REMOVAL
3	PLANS FOR BRIDGE DECK RESTORATION
4	MISCELLANEOUS DETAILS


UTILITY	PHONE NO.
PACIFIC TELEPHONE & TELEGRAPH CO. BILL BADSGARD	(714)999-5175
SO. CALIF. EDISON CO. ED SANCHEZ	(714)973-5491
T.M. CABLEVISION CO. LINDA TESSIER	(714)831-8400

BENCH MARK:
THIS PROJECT WILL NOT REQUIRE SURVEYED VERTICAL CONTROL. IT IS THE INTENT OF THESE PLANS TO MATCH EXISTING ABUTMENT ELEVATIONS.


BASIS OF BEARING:
THIS PROJECT WILL NOT REQUIRE SURVEYED HORIZONTAL CONTROL. IT IS THE INTENT OF THESE PLANS TO MATCH THE EXISTING BRIDGE ALIGNMENT.

AS BUILT
WHILE THE INFORMATION IS BELIEVED TO BE ACCURATE, THE ORANGE COUNTY ENVIRONMENTAL MANAGEMENT AGENCY WILL NOT BE RESPONSIBLE FOR OMISSIONS, ERRORS, OR INACCURACIES.

FUNDED BY: HIGHWAY USER'S TAX

 

EMA-PUBLIC WORKS
SUBMITTED: *William H. Talley* 9/24/82
SECTION CHIEF RCE 16799
RECOMMENDED: *[Signature]* 9/24/82
DIVISION MANAGER RCE 13154
APPROVED: *C.B. Nelson* 9-24-82
DIRECTOR OF PUBLIC WORKS RCE 13142

 

NO.	DESCRIPTION	SHT.	APPROVED	DATE

REVISIONS

W. O. NO. RI4417
DWG. NO. _____

SHEET 1 OF 4