ORIGINAL SURVEY			
NOTE BOOK	CHECKED	CLP	8/69
	PLOTTED	DDN	
	TEMPLAT	DLO	8/69
NO.	AREAS CHECKED	DDN	

FINAL SURVEY		
NOTE BOOK	CHECKED	
	PLOTTED	
	TEMPLAT	
NO.	AREAS CHECKED	

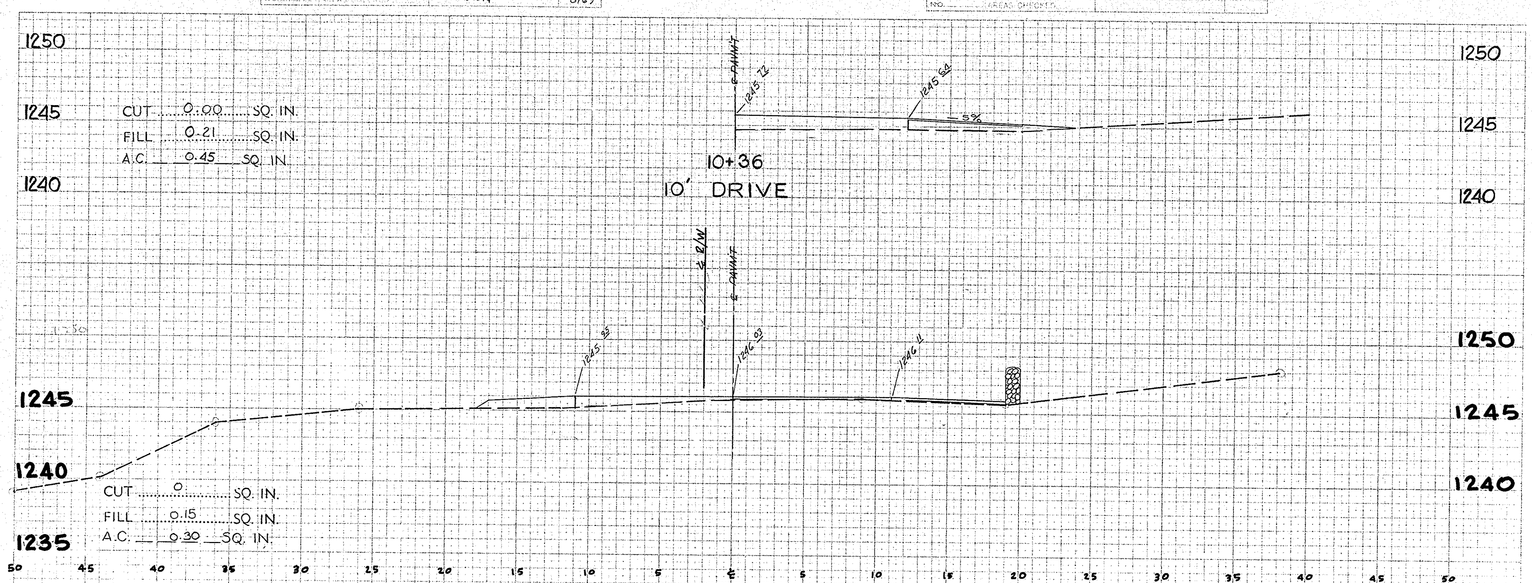

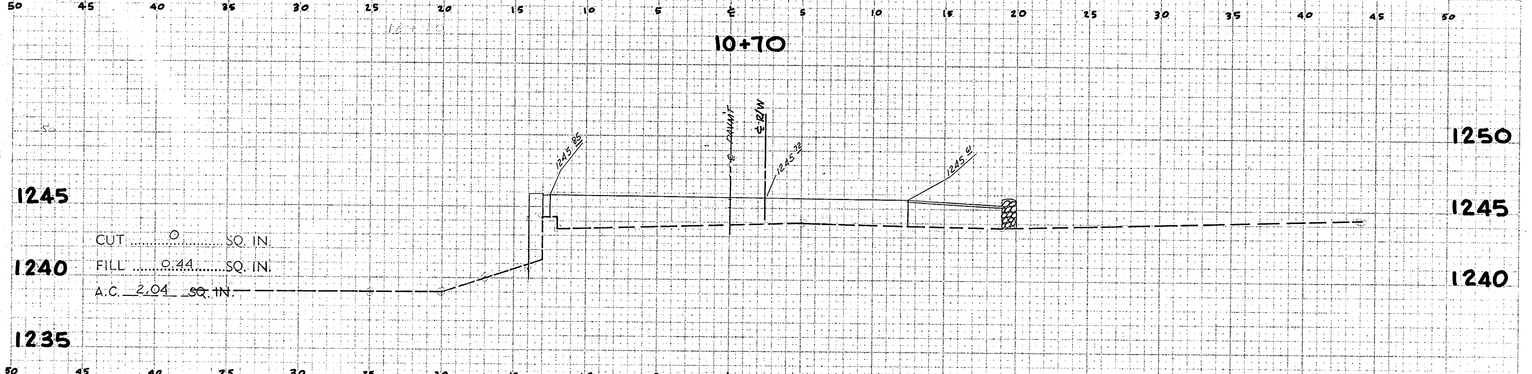

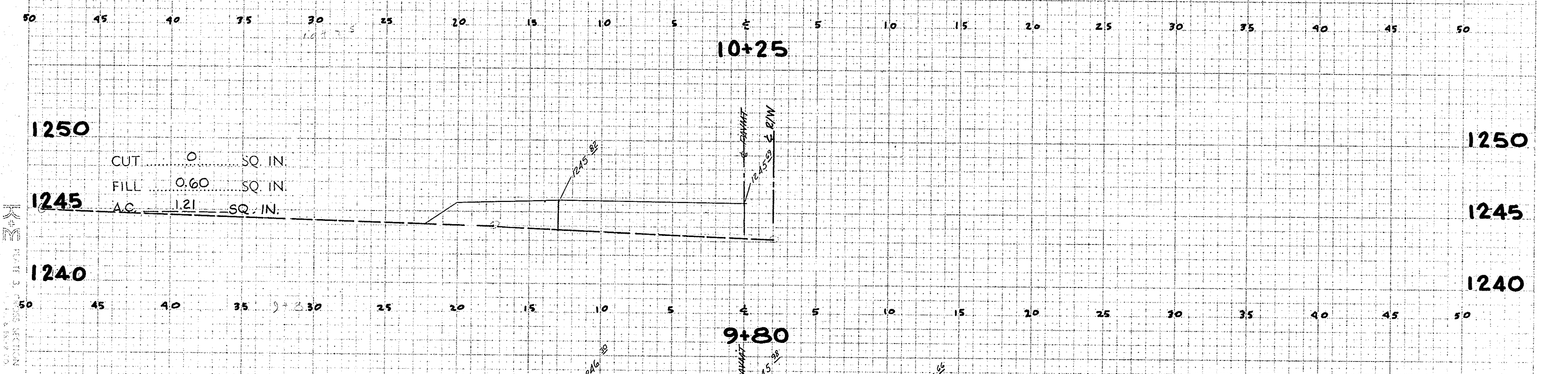

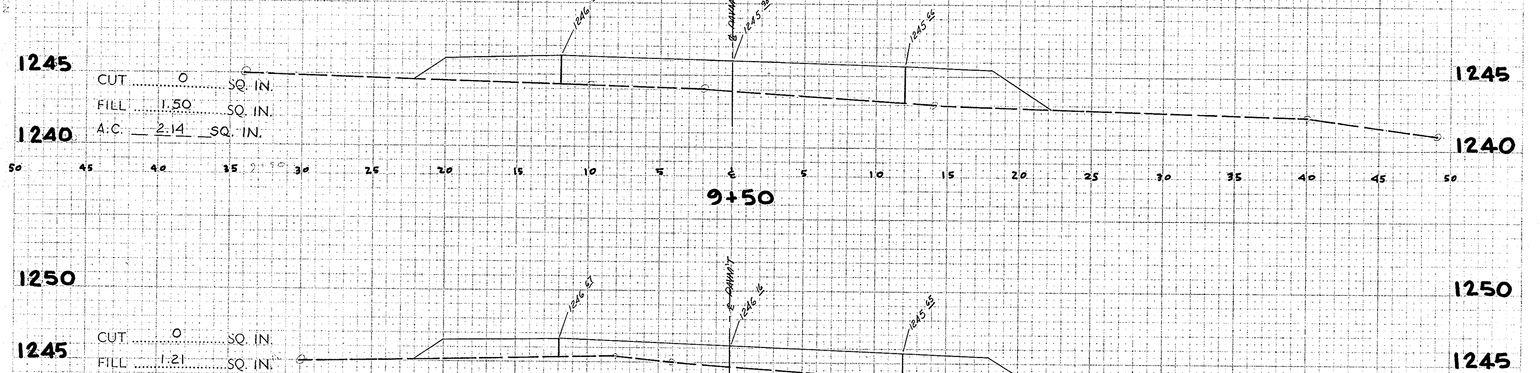

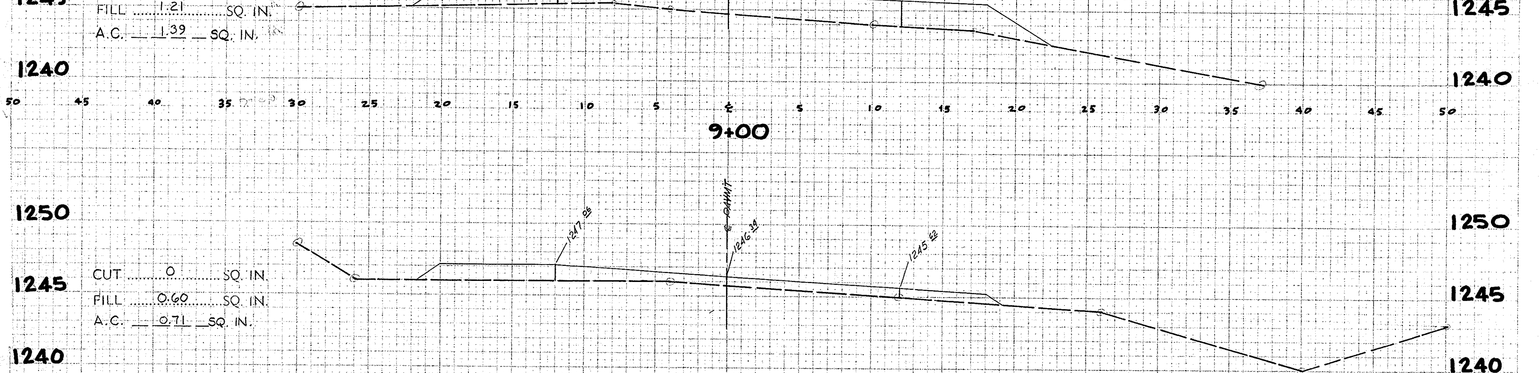

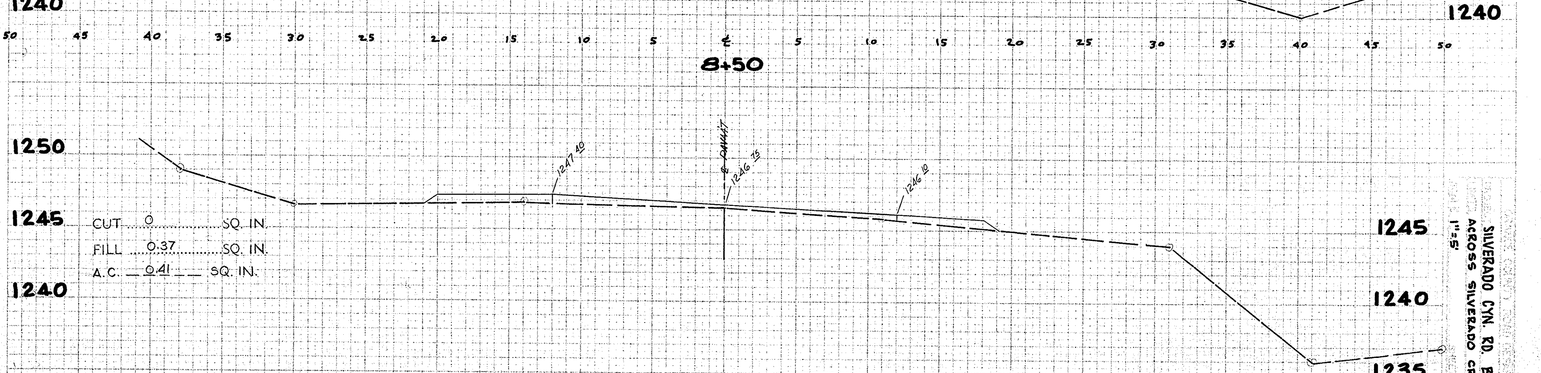

SILVERADO CYN. RD. BRIDGE SN-9
ACROSS SILVERADO CREEK
1"=5'

DR 17 (10/26)