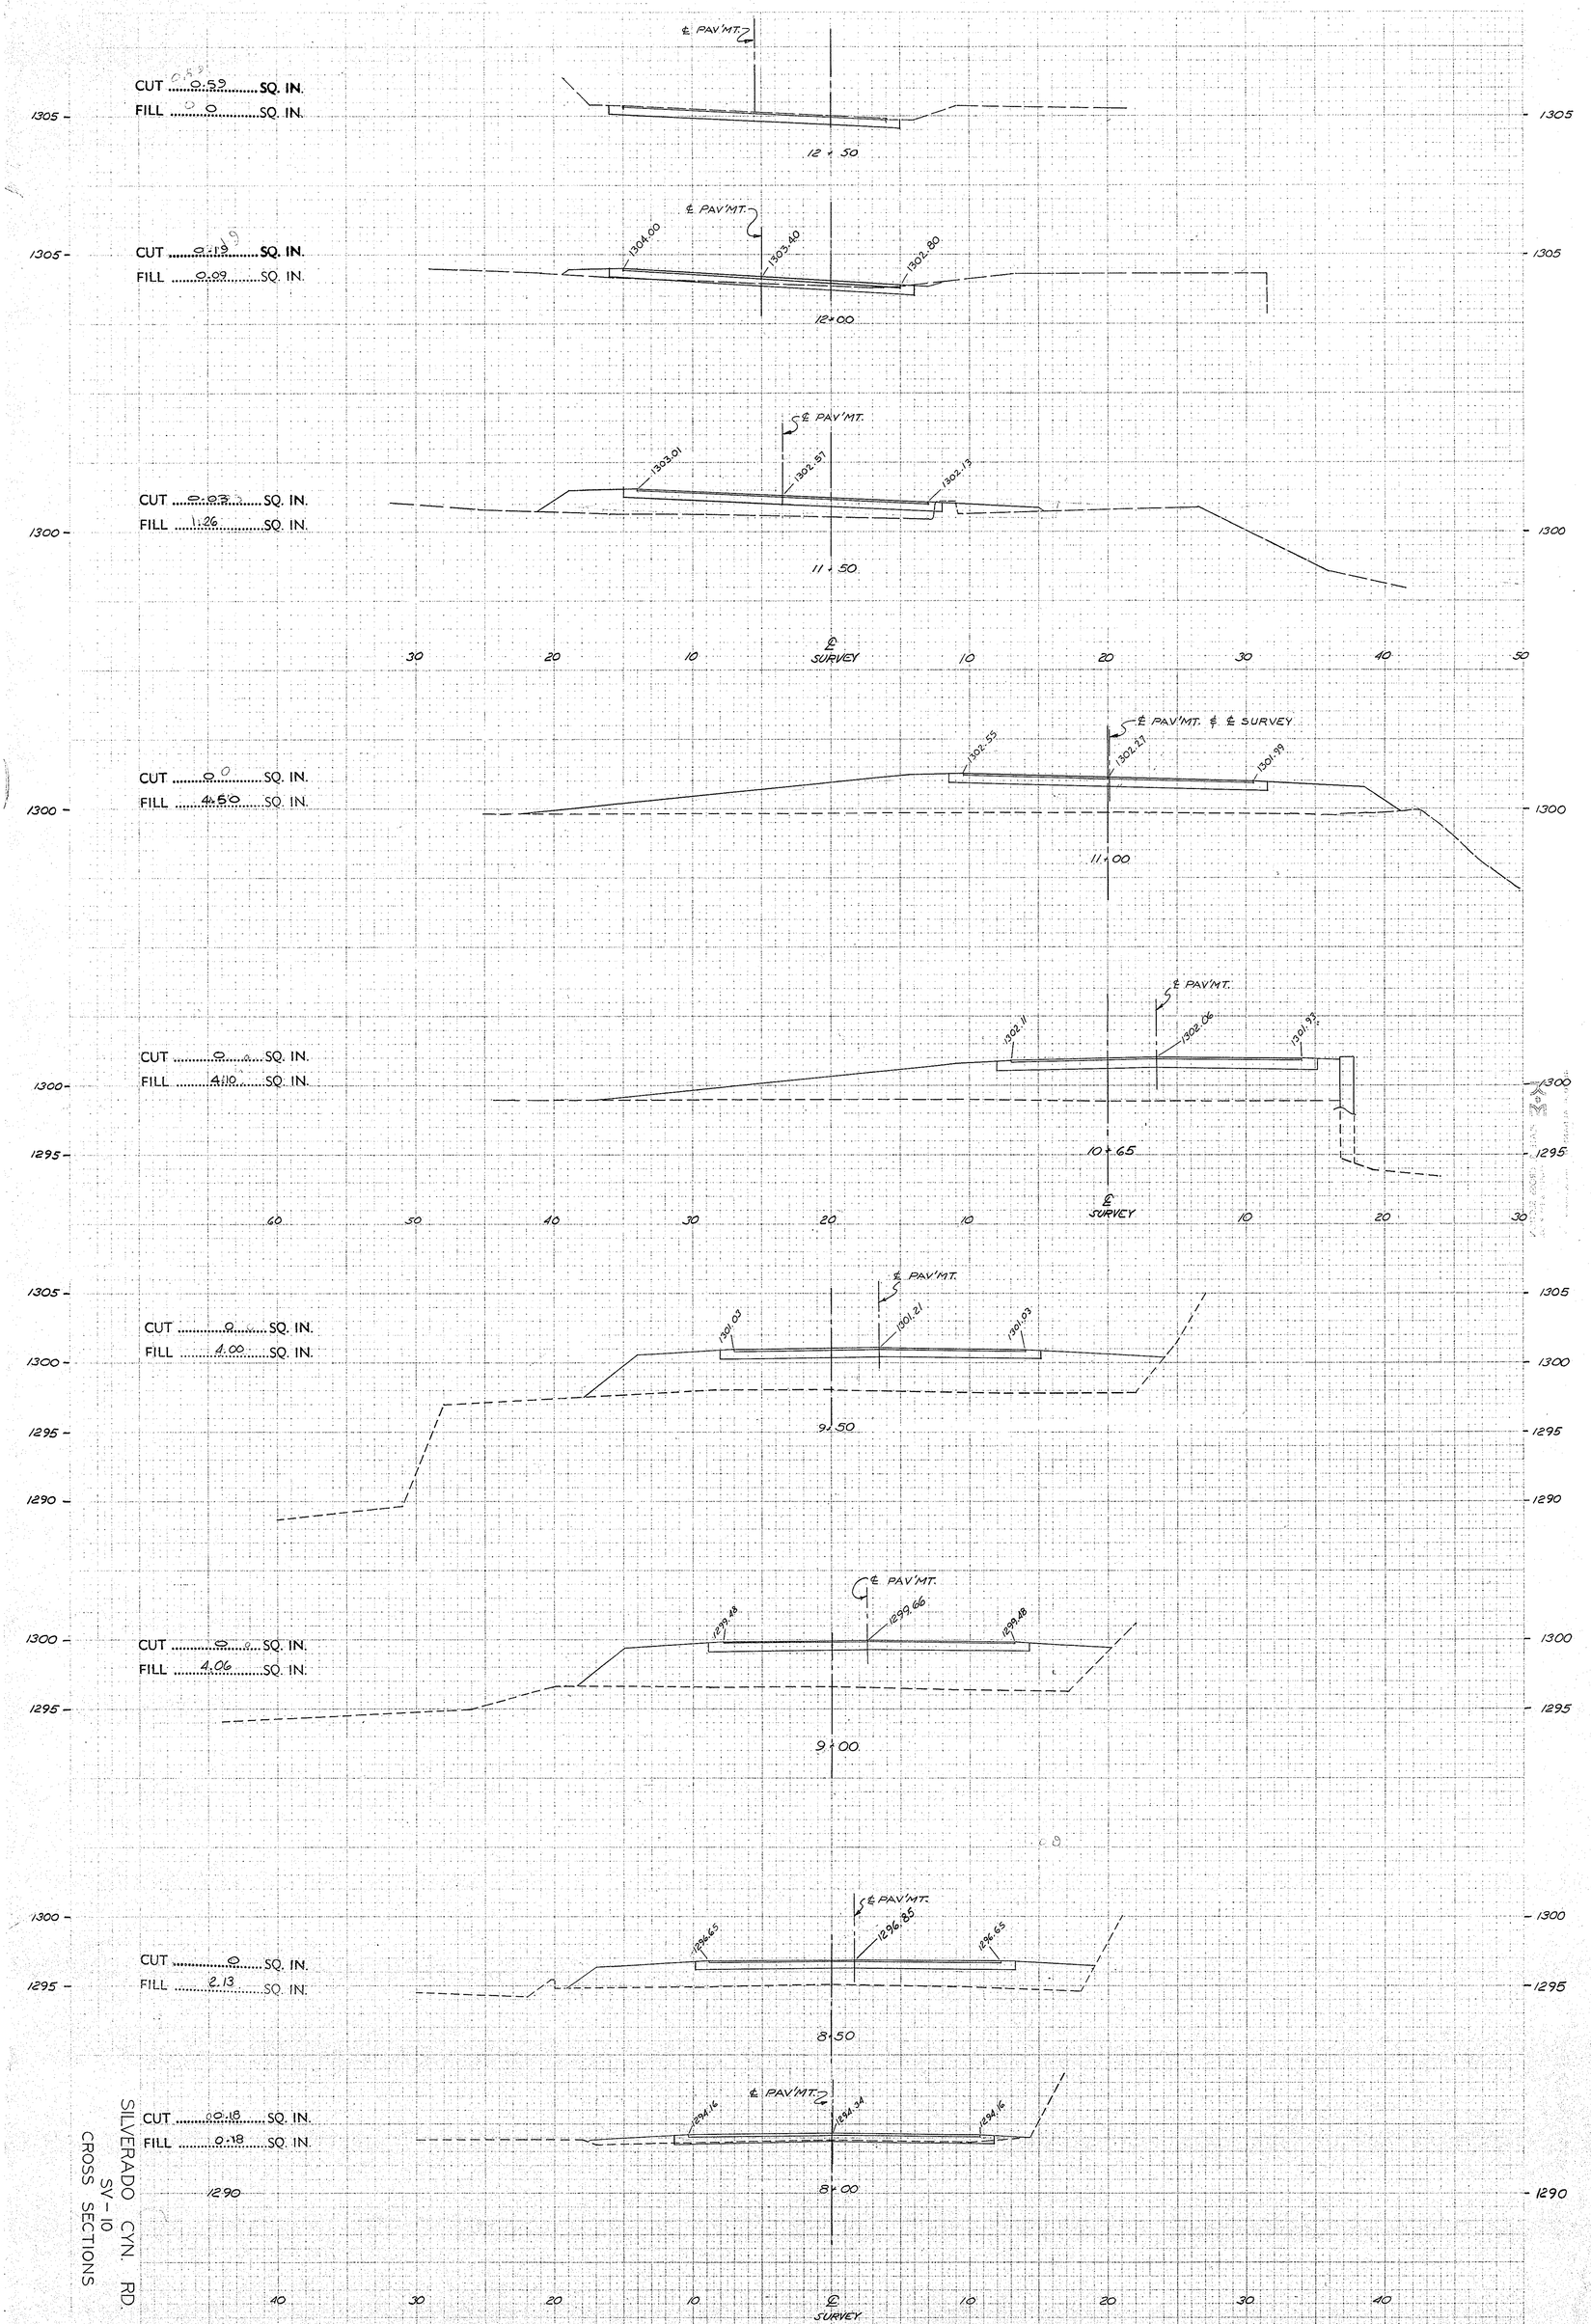

SILVERADO CYN. RD.
SV – 10
CROSS SECTIONS