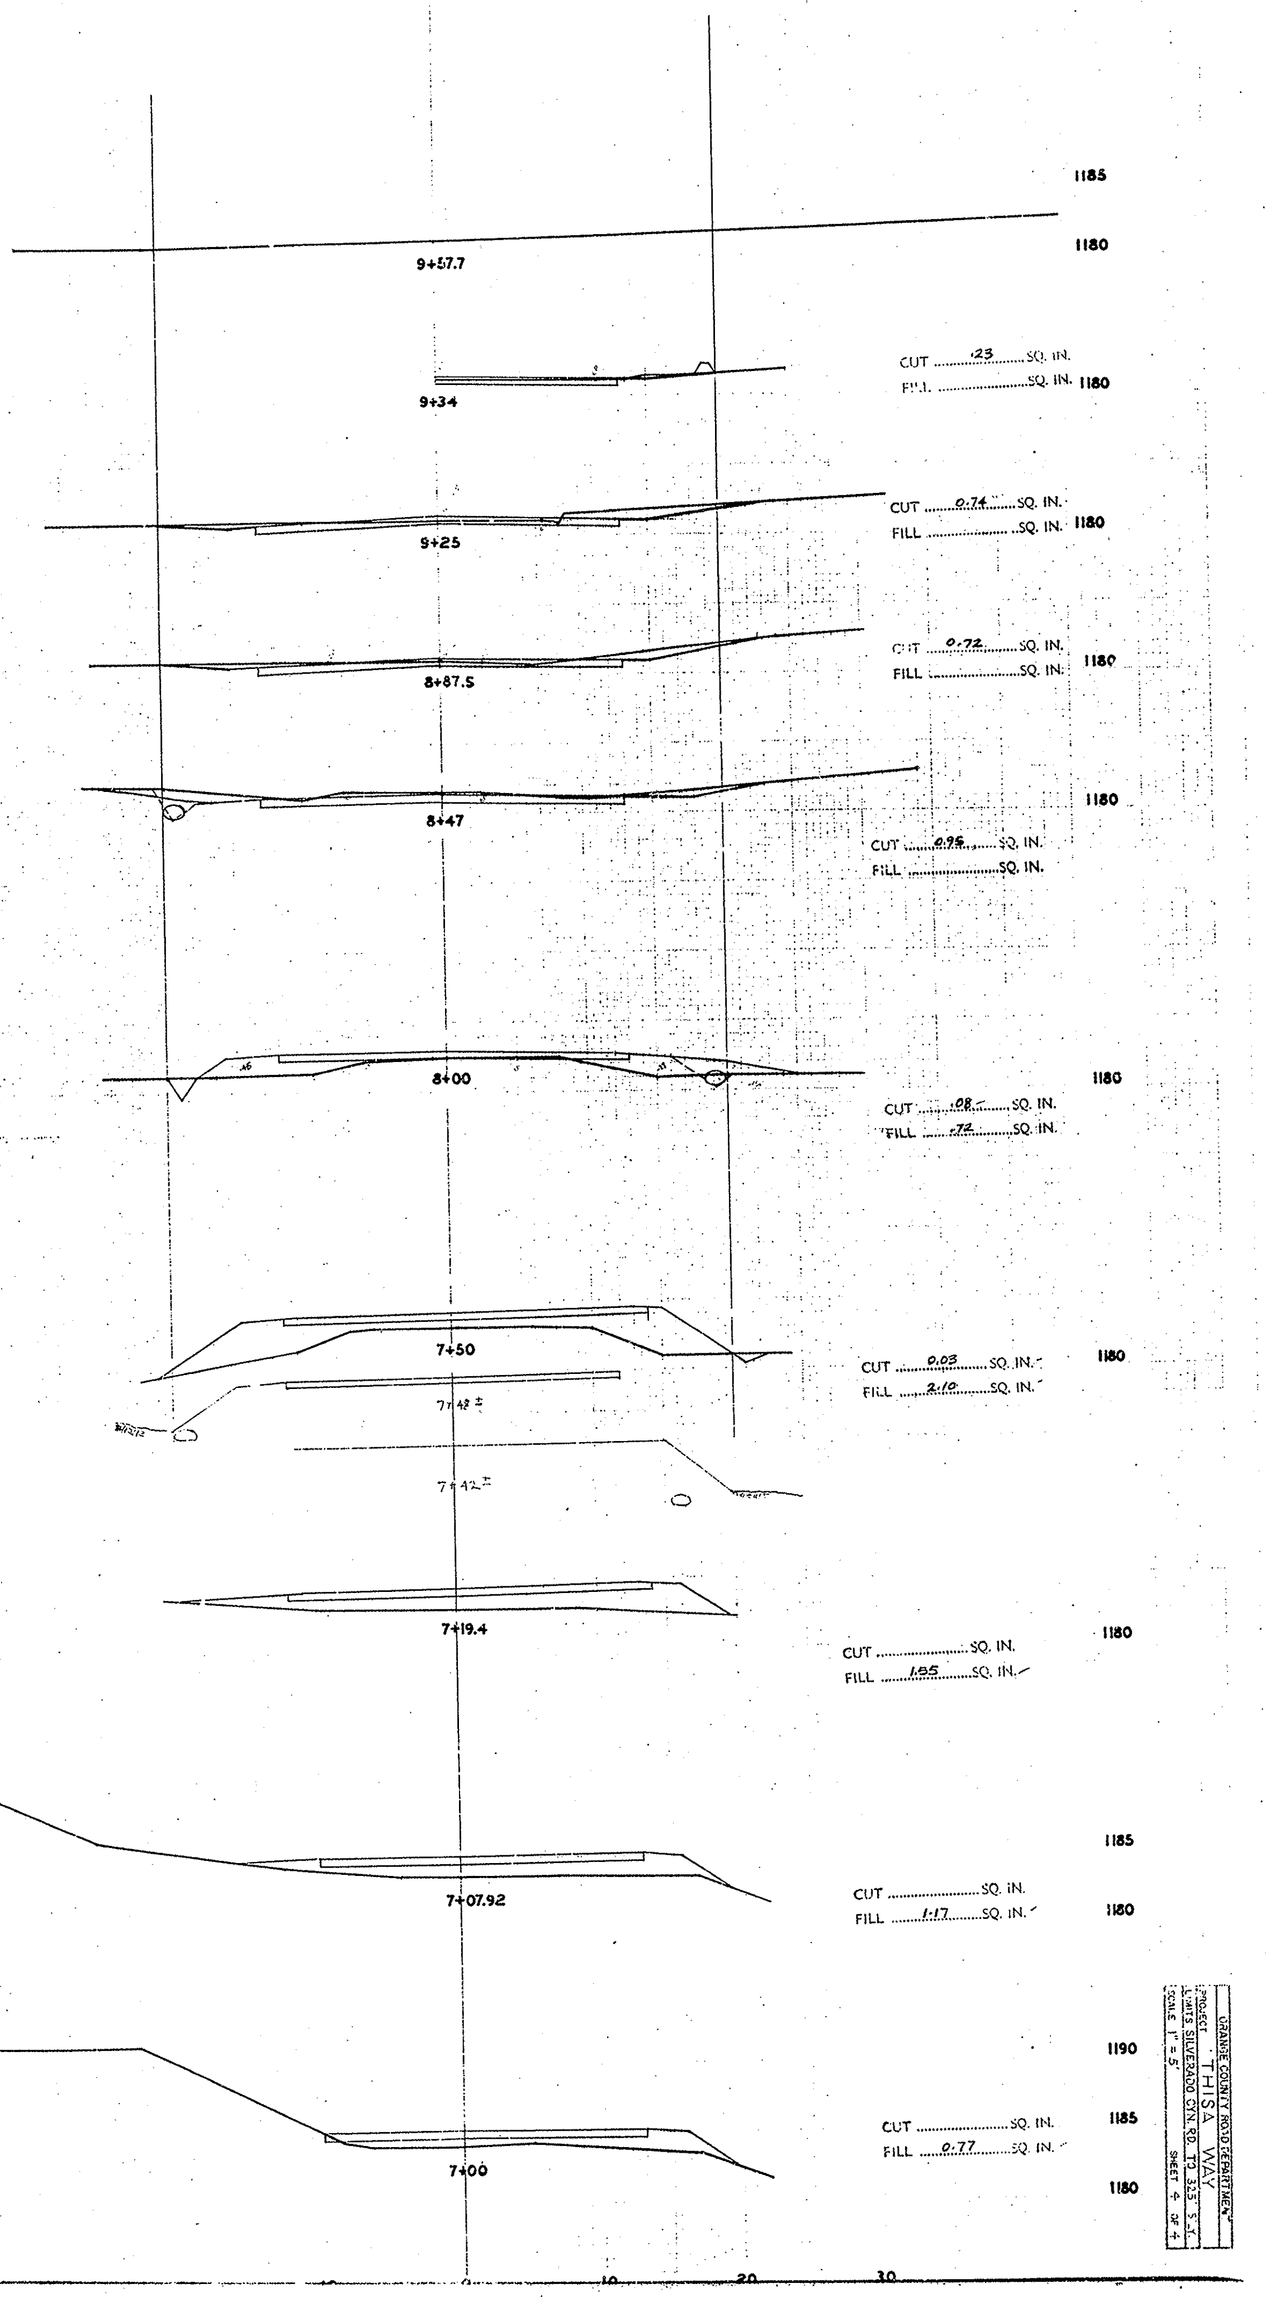
1185
1180
9+57.7
CUT .23 SQ. IN.
FILL SQ. IN.
1180
9+34
CUT 0.74 SQ. IN.
FILL SQ. IN.
1180
9+25
CUT 0.72 SQ. IN.
FILL SQ. IN.
1180
8+87.5
1180
8+47
CUT 0.95 SQ. IN.
FILL SQ. IN.
1180
8+00
CUT .08 SQ. IN.
FILL .72 SQ. IN.
1180
7+50
CUT 0.03 SQ. IN.
FILL 2.10 SQ. IN.
7+42±
7+42±
1180
7+19.4
CUT SQ. IN.
FILL 1.85 SQ. IN.
1185
7+07.92
CUT SQ. IN.
FILL 1.17 SQ. IN.
1180
1190
7+00
CUT SQ. IN.
FILL 0.77 SQ. IN.
1185
1180
AS BUILT
ORANGE COUNTY ROAD DEPARTMENT
PROJECT THISA WAY
LIMITS SILVERADO CYN. RD. TO 325' S.-J.
SCALE 1" = 5'
SHEET 4 OF 4