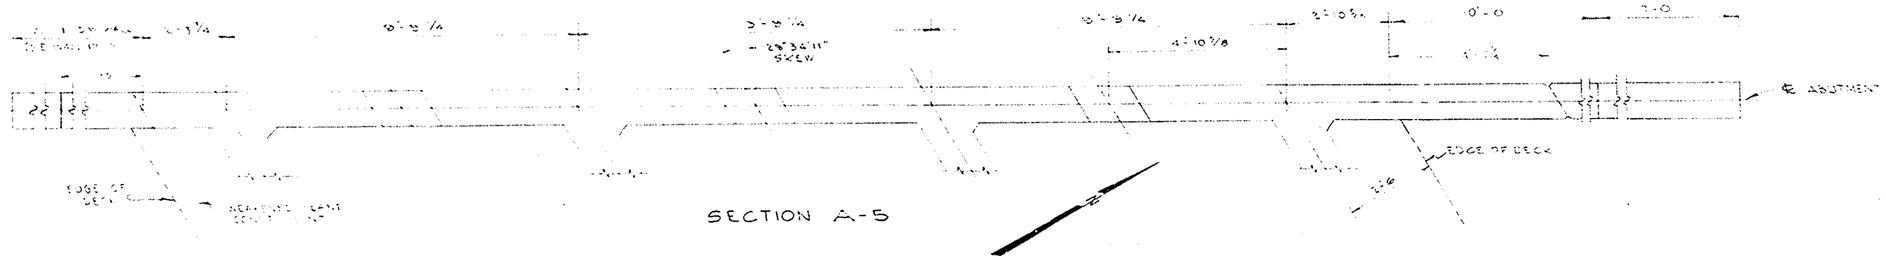

SECTION A-5

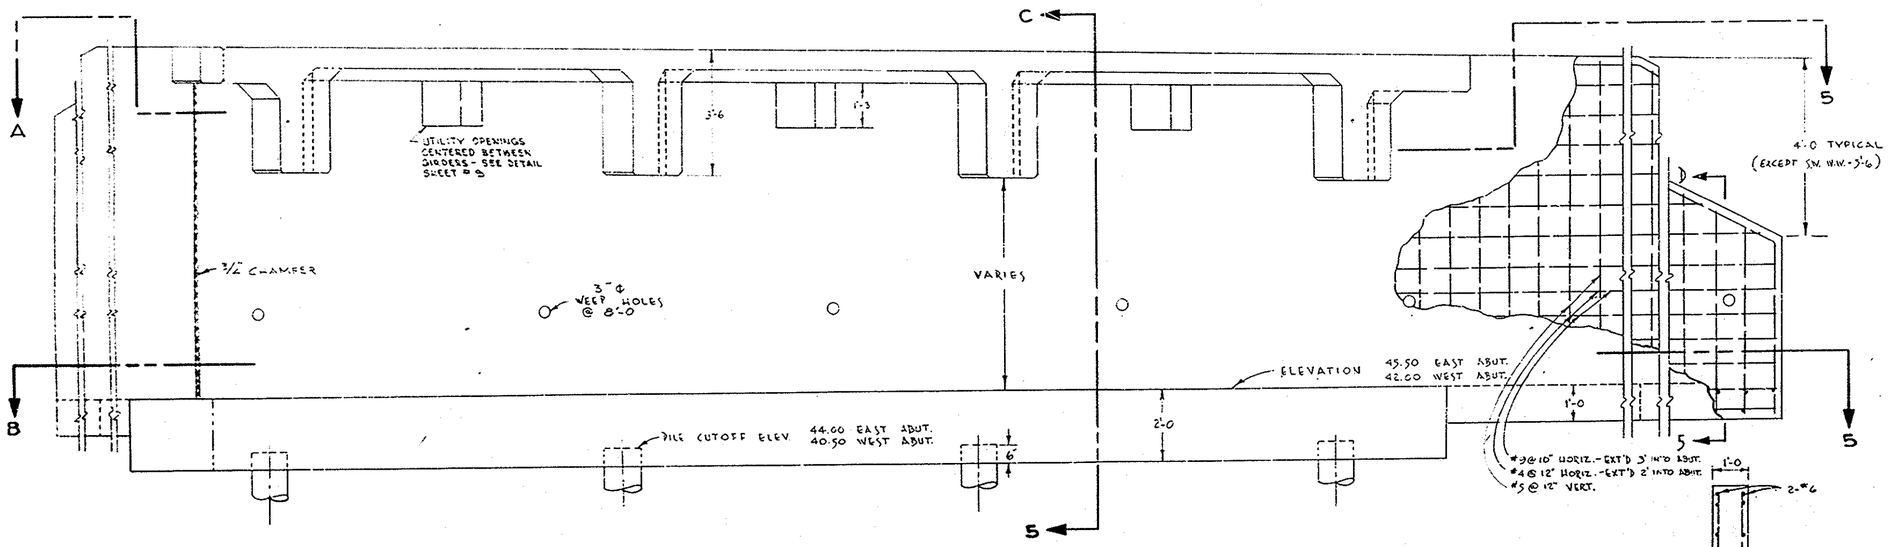

TYPICAL ABUTMENT DETAIL

(WEST ABUTMENT LOOKING WEST)

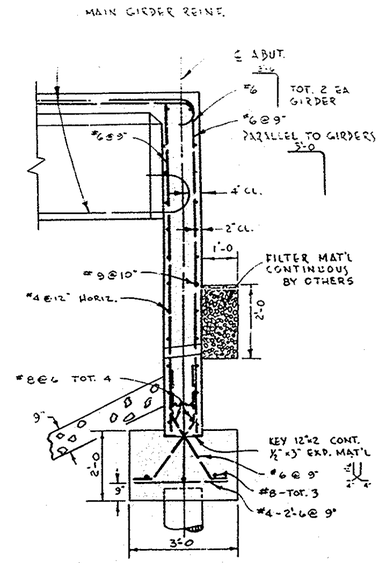

SECTION C-5

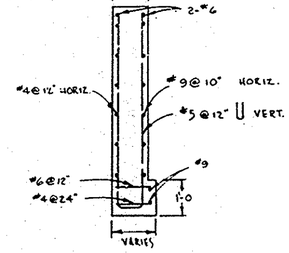

SECTION D-5

NOTE: BLOCK BACK OF UNUSED UTILITY OPENINGS WITH 2" MIN. REDWOOD. EDGE LAP MIN. 3" BY OTHERS

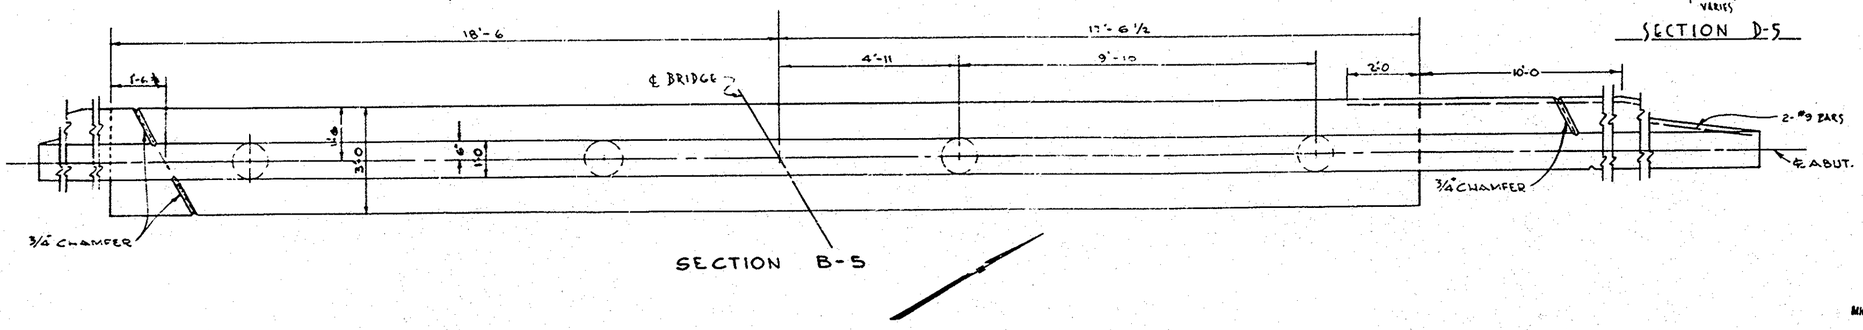

SECTION B-5

SA 32
P/P Talbert Ave. Bridge
Red. Ratio 22.5:1
Sheet 4 of 12
Scale 1/2" = 1'
Pencil Sketch

MICROFILMED
JUN 18 1982

ORANGE COUNTY HIGHWAY DEPARTMENT

TALBERT AVE. BRIDGE ACROSS SANTA ANA RIVER

ABUTMENT DETAIL

SCALE 1/2" = 1'-0" | SHEET 4 OF 12

SA 32

#14695