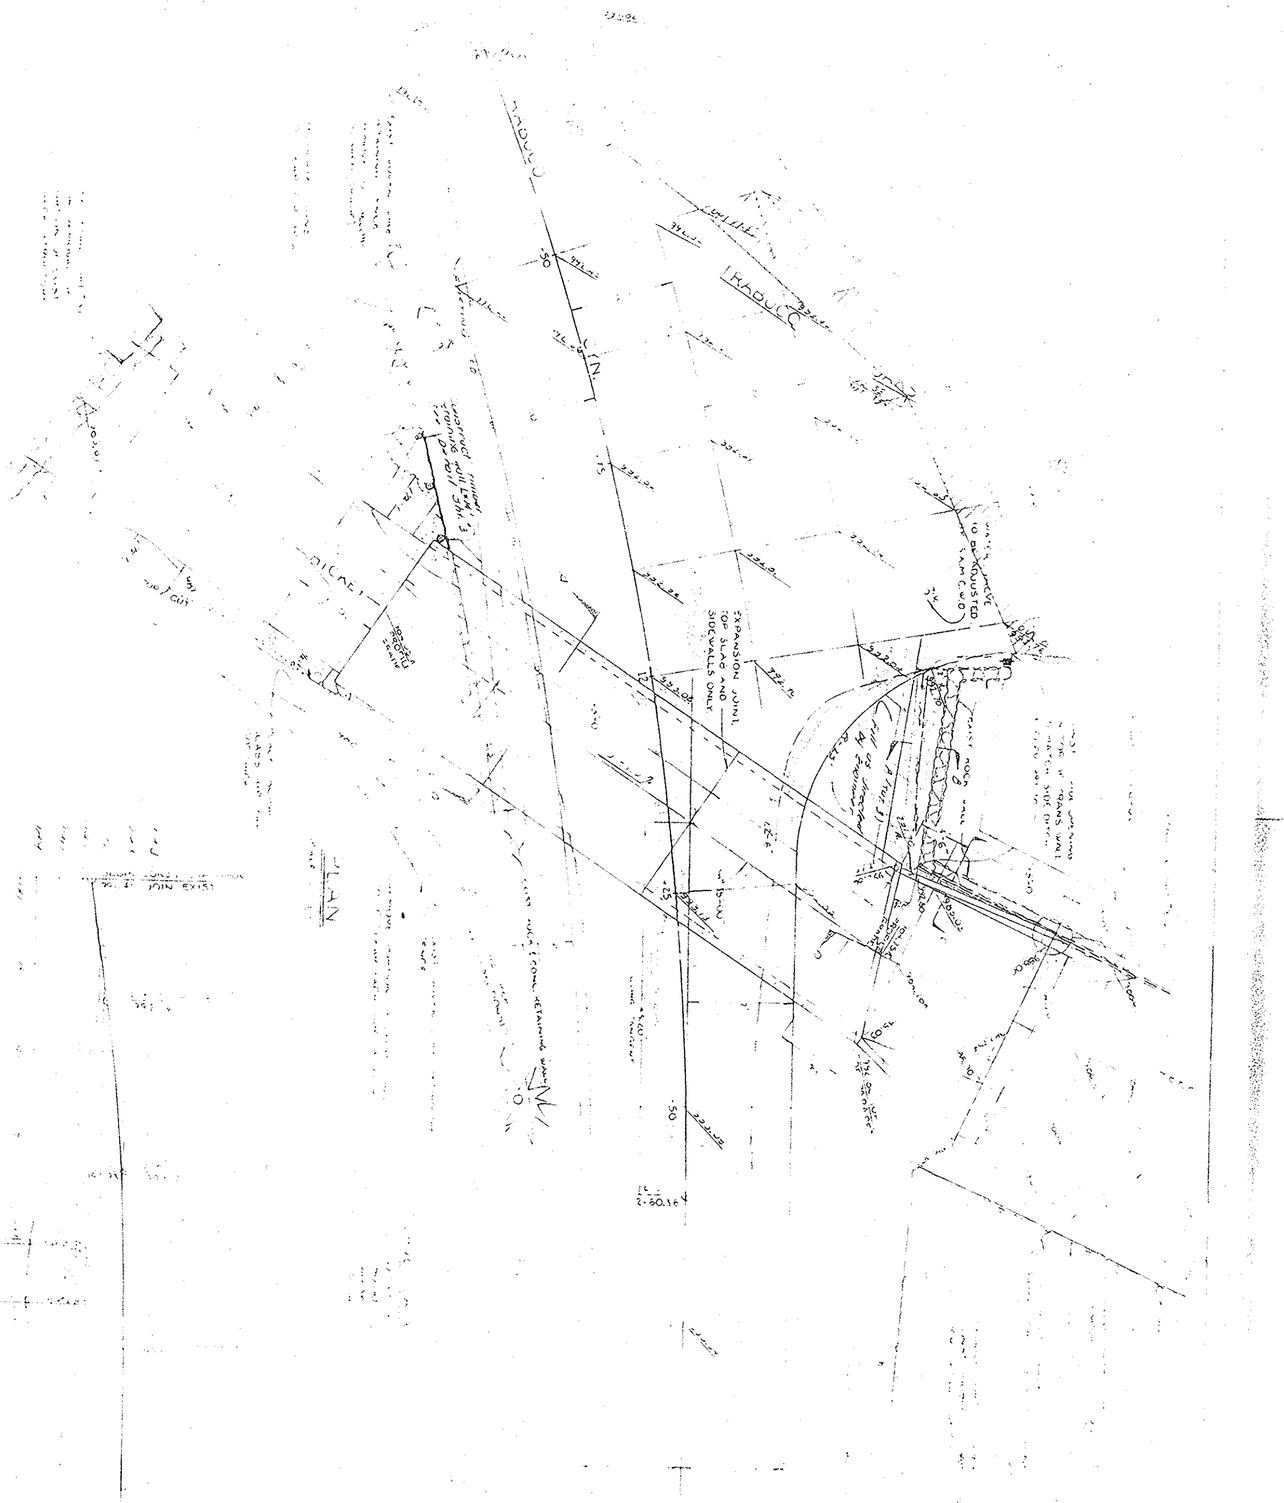
EXPANSION JOINT
TOP SLAB AND
SIDEWALLS ONLY
PLAN