Dist.	County	Route	Section	Sheet	Total Sheets
12	ORA	267	A1	1	11

Dist.	County	Route	Section	Sheet	Total Sheets
VII	ORA	45	A0Ra	1	11

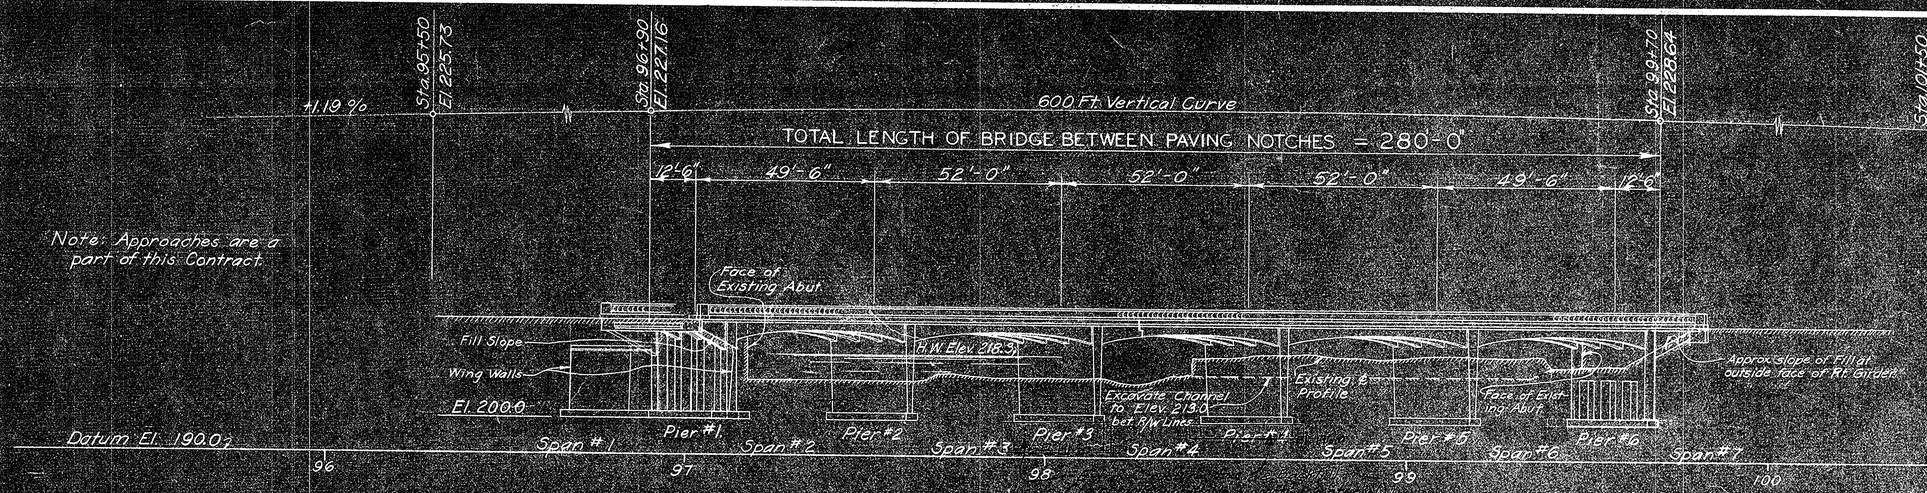

Note: Approaches are a part of this Contract.

ELEVATION
Scale: 1" = 20'-0"

INDEX TO SHEETS

Sht. No.	Title
1	General Plan
2	Foundation Plan
3	Piers No. 1 & 6
4	Piers No. 2, 3, 4 & 5
5	Deck Plan & Sections
6	Deck Plan Contd. & Exp. Joint Details
7	Girder Details
8	Girder Details Cont'd
9	Standard Retaining Wall
10	Miscellaneous Details
11	Railing Details

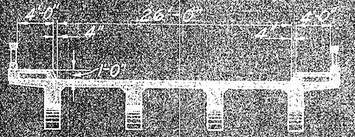

TYPICAL CROSS SECTION
Scale: 1/2"=1'-0"

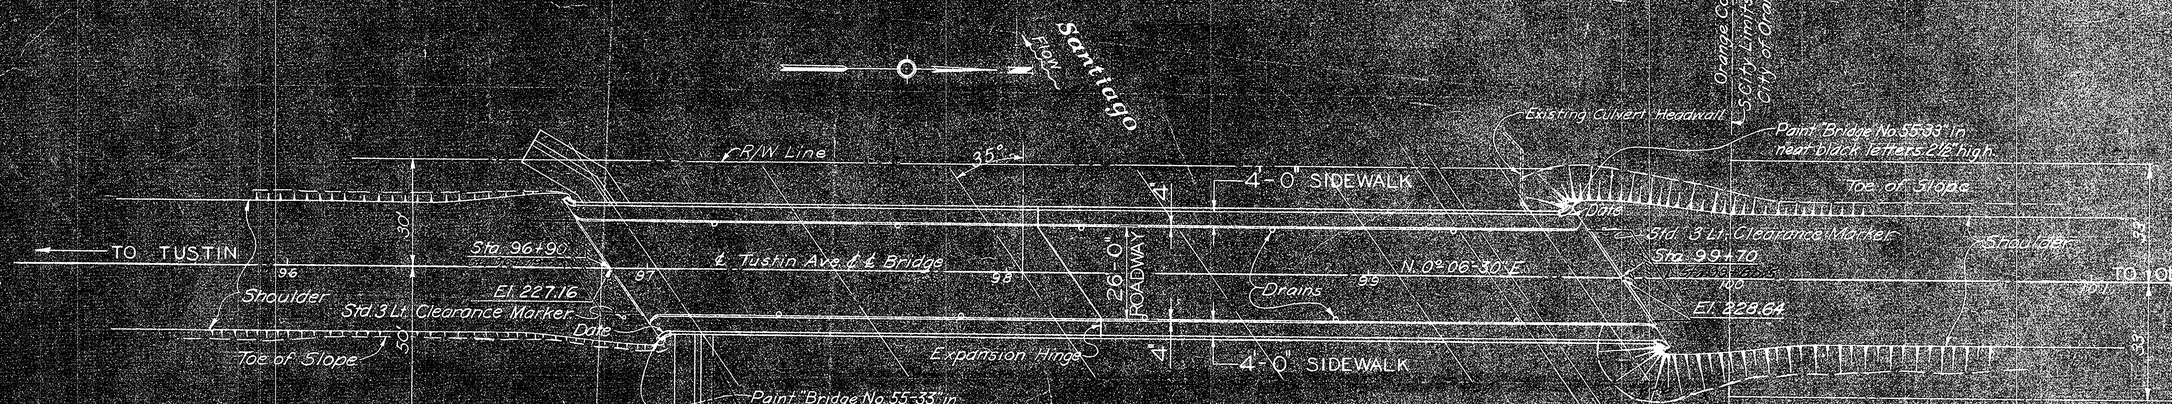

PLAN
Scale: 1"=20'-0"

B.M. No. 1
Cut Spike & Washer in No. Side of 24" Eucalyptus tree 3.5' above ground level, 80' Rt. Sta. 96+28
Elev. 225.13

(Bench Mark & Datum are U.S.G.S.)

Note: For GENERAL NOTES for this set of PLANS, see Sheet No. 2

55 C-43
State Highway Bridge
Sheet 1 of 12
Ped 29.5 Scale is Shown
Blueprint

AS BUILT
CORRECTIONS BY
DATE

STATE OF CALIFORNIA
DEPARTMENT OF PUBLIC WORKS
DIVISION OF HIGHWAYS

BRIDGE ACROSS SANTIAGO CREEK
NEAR ORANGE IN ORANGE COUNTY

GENERAL PLAN

SCALE: As Noted	FILE No.
BRIDGE No. 55-33	DRAWING No. C-1144-1

Approved Date	Expires	Date
2/7	6-46	
2/7	6-46	
6/7	6-46	
2/4	6-48	
10/4	6-48	
2/4	6-48	

R. E. Dolliston
Engineer of Bridges
and Chief Engineer

BRIDGE DEPARTMENT