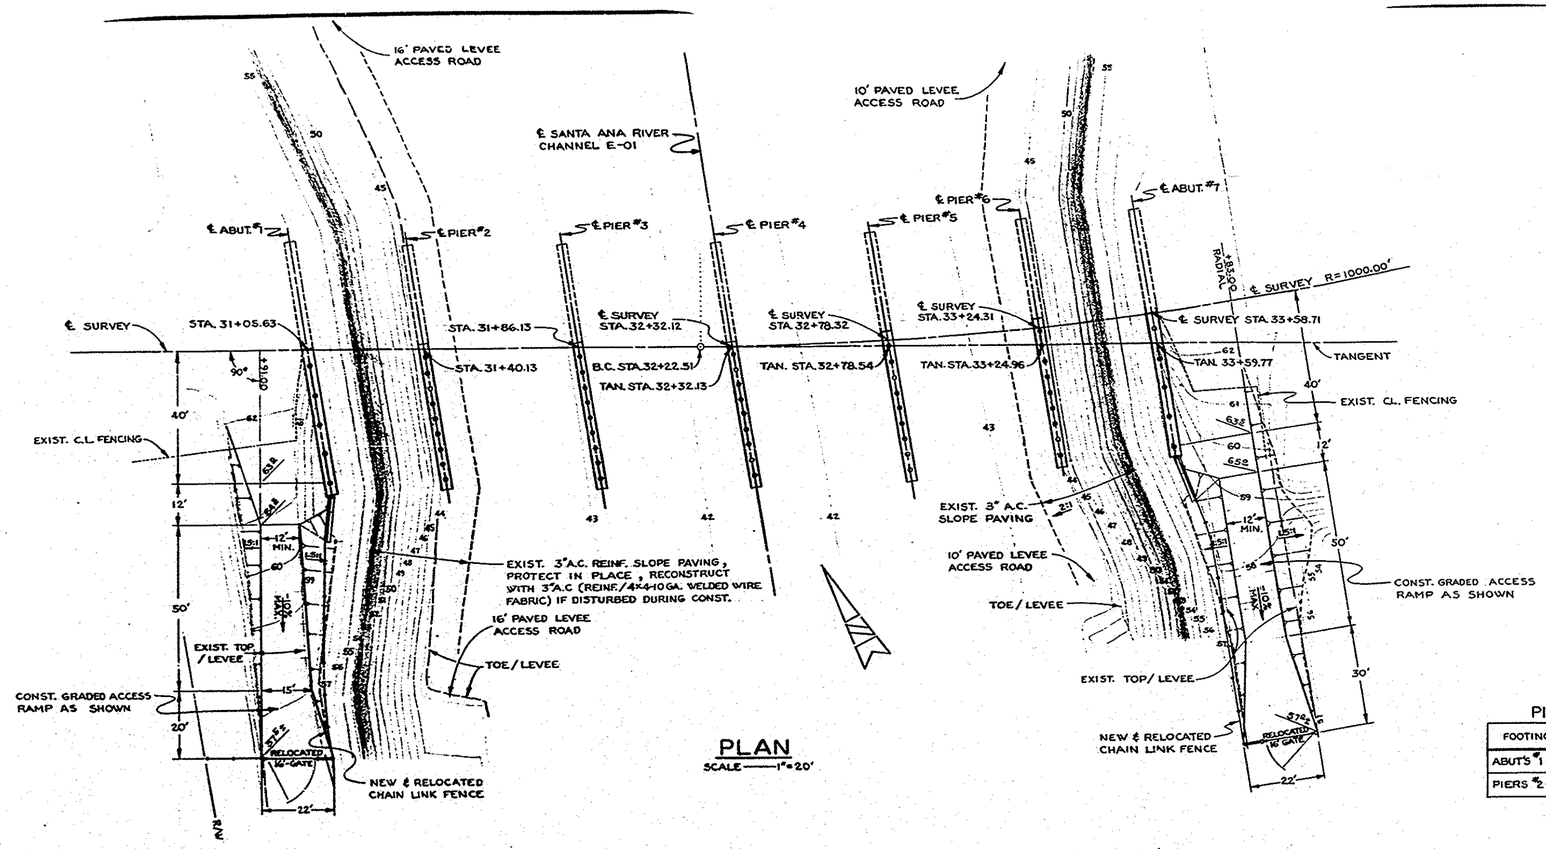

PLAN

SCALE — 1" = 20'

PILING DATA

FOOTING	SPEC. PILE TIP ELEV.	ELEV. PILE CUTOFF
ABUT'S #1 & 7	-34.00	55.75
PIERS #2-6	-34.00	37.15

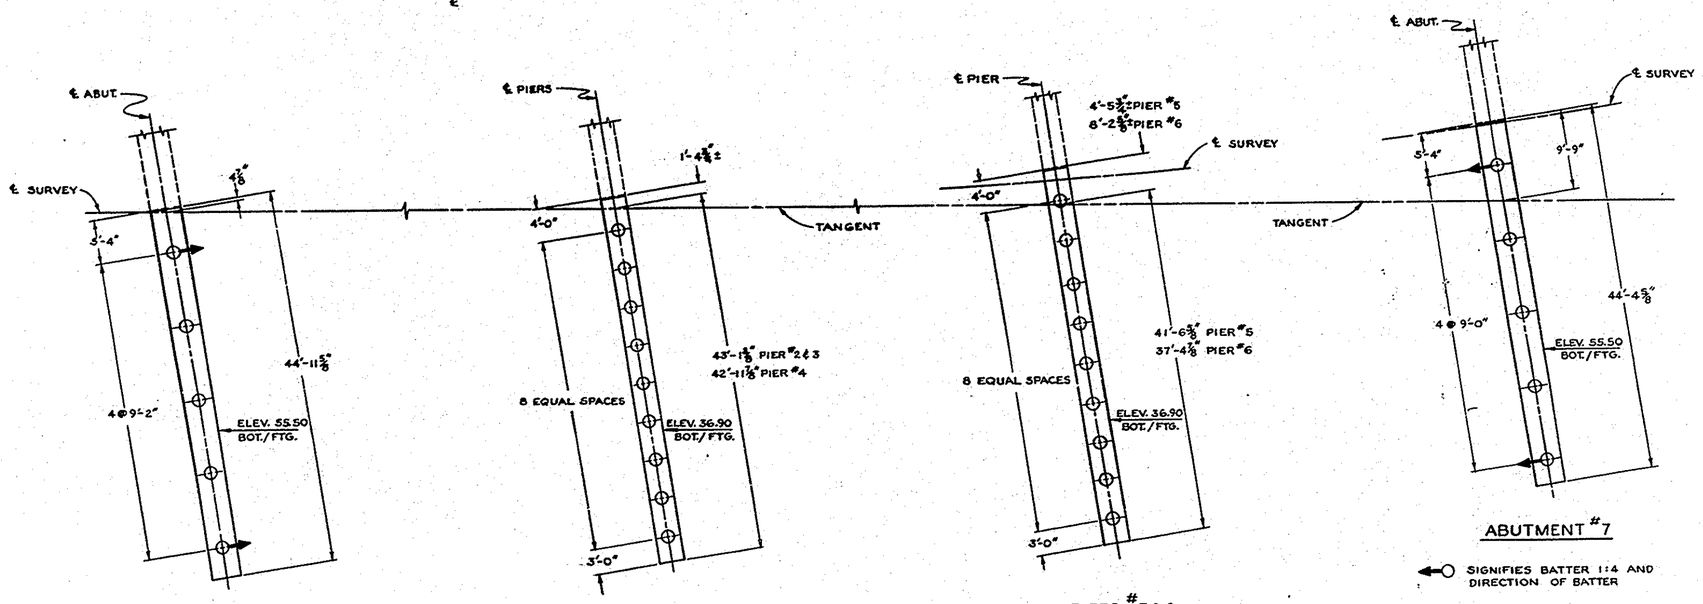

ABUTMENT #1

PIERS #2,3,& 4

PIERS #5 & 6

ABUTMENT #7

PILE LAYOUT

SCALE — ⅛" = 1'-0"

◄ SIGNIFIES BATTER 1:4 AND DIRECTION OF BATTER

NOTES:

1. PILE TYPE : REINF. CONC.
2. PILE BEARING VALUE : 45 TONS
3. RECONSTRUCTION OF LEVEES, SLOPE PAVING, ETC. SHALL BE TO THE SATISFACTION OF THE FLOOD CONTROL DISTRICT.
4. EXISTING CONTOURS SHOWN ARE APPROX. ONLY.

Plan #8002
Warner Ave. Bridge
Sheet: 3 of 12
Scale: as shown
Red: 22.5:1
Vellum

ORANGE COUNTY ROAD DEPARTMENT

WARNER AVE BRIDGE WIDENING SA-30A
ACROSS
SANTA ANA RIVER
FOUNDATION PLAN

DESIGNED J.R.L. DRAWN J.R.L. CHECKED E.H.K. DATE 3/62
SCALE NOTED

3 12