BEARING SEAT ELEVATIONS
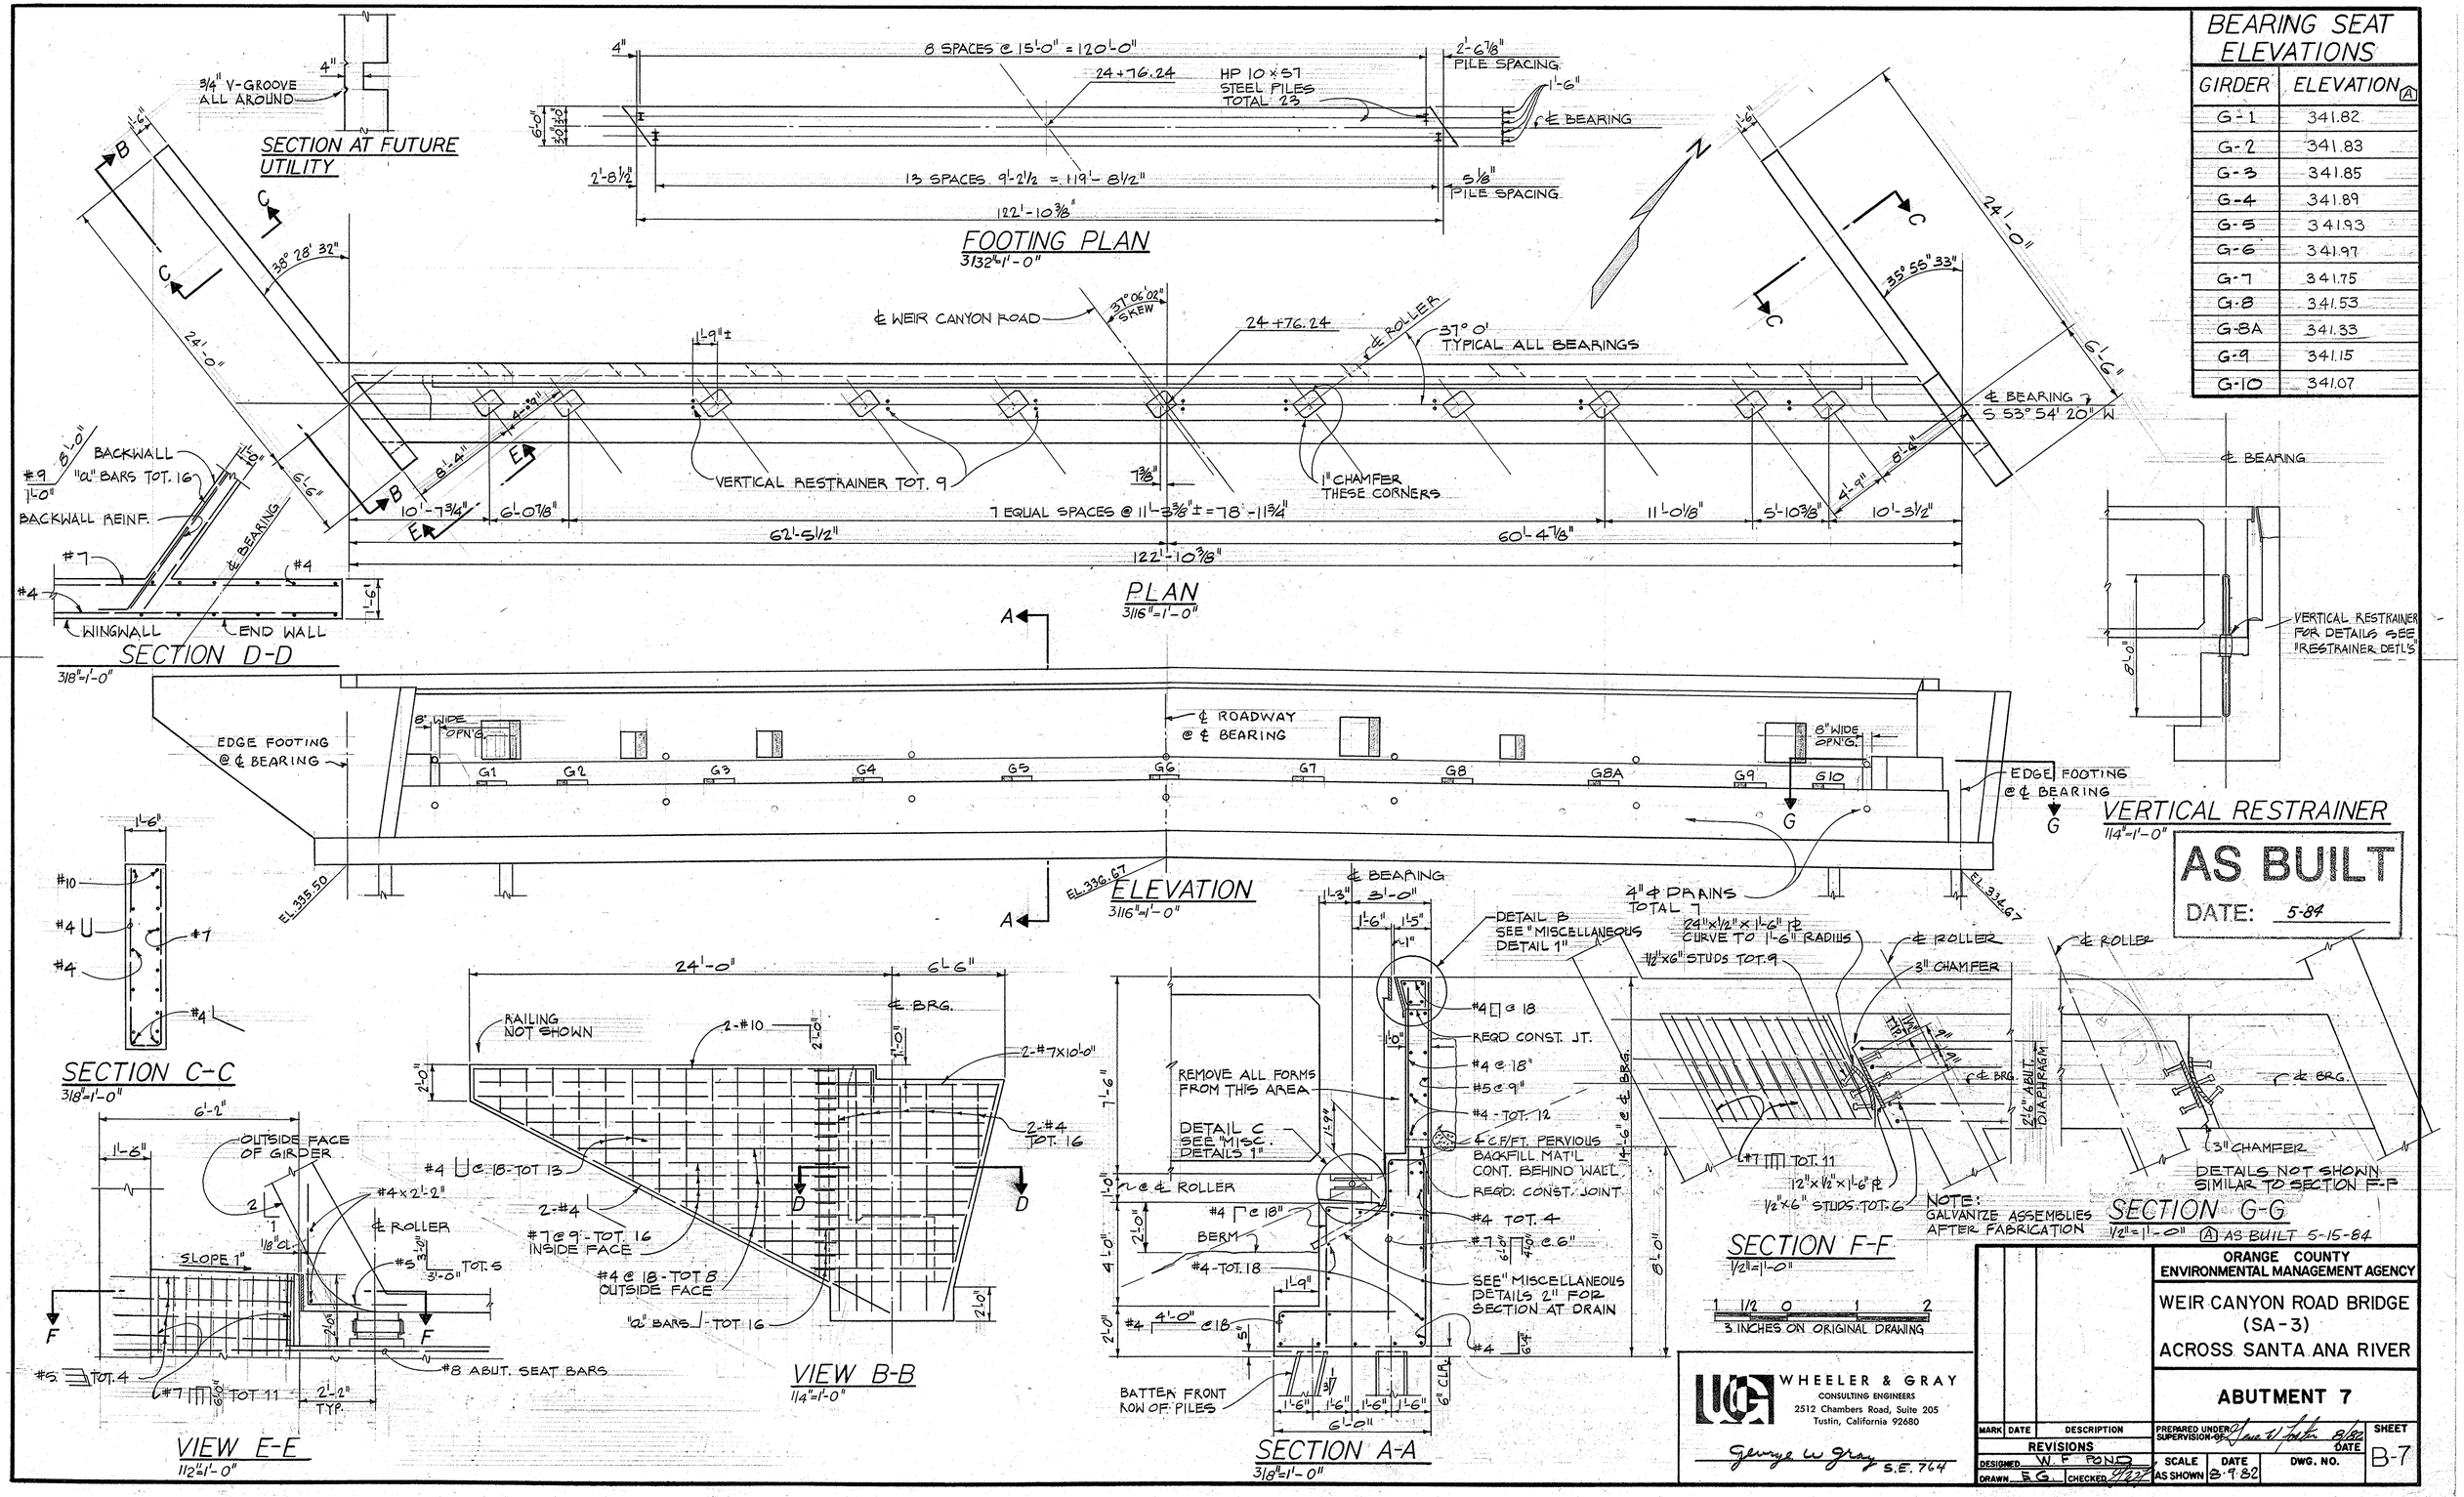
GIRDER	ELEVATION (A)
G-1	341.82
G-2	341.83
G-3	341.85
G-4	341.89
G-5	341.93
G-6	341.97
G-7	341.75
G-8	341.53
G-8A	341.33
G-9	341.15
G-10	341.07