


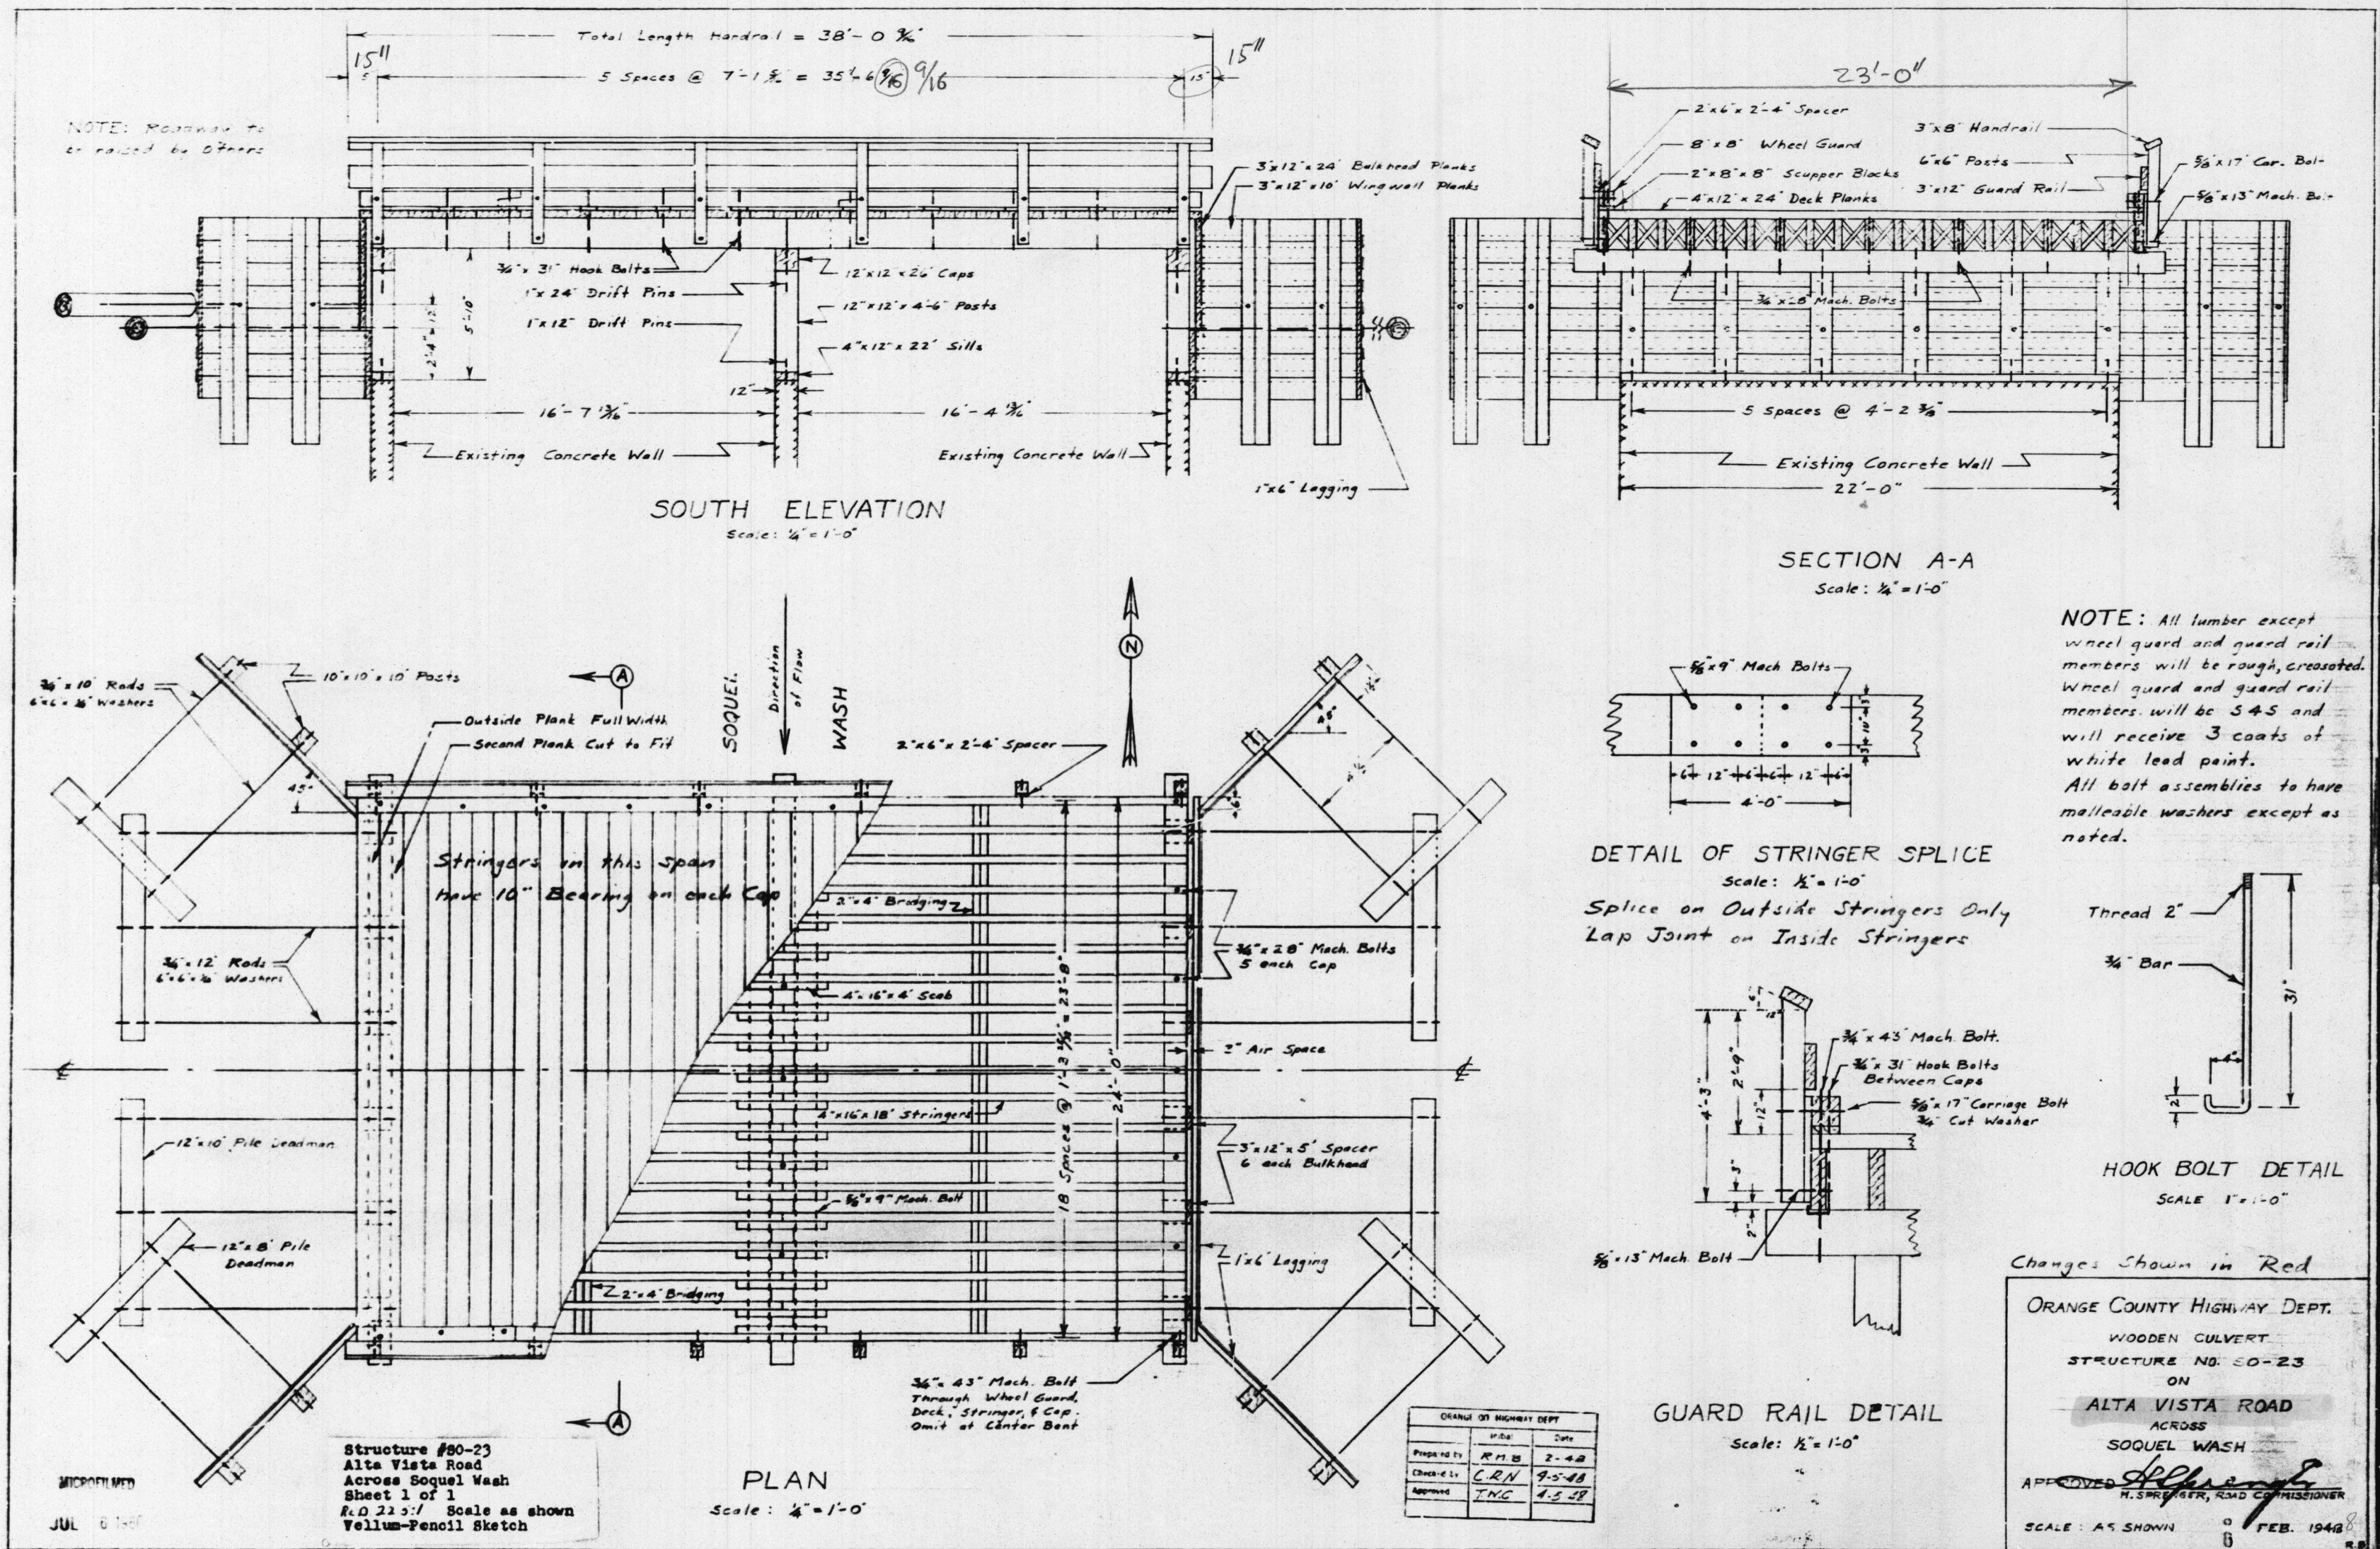

#14667
SO-23

1948
ALTA VISTA RD