EXACT® EXACT LEVEL & TOOL MFG. CO., Inc. HIGH BRIDGE, N. J., U. S. A. STRAIGHT EDGE RULE SE-48

S-14 BRIDGE BRYAN AVE.
3.25 MI. W.LY. CULVER RD.

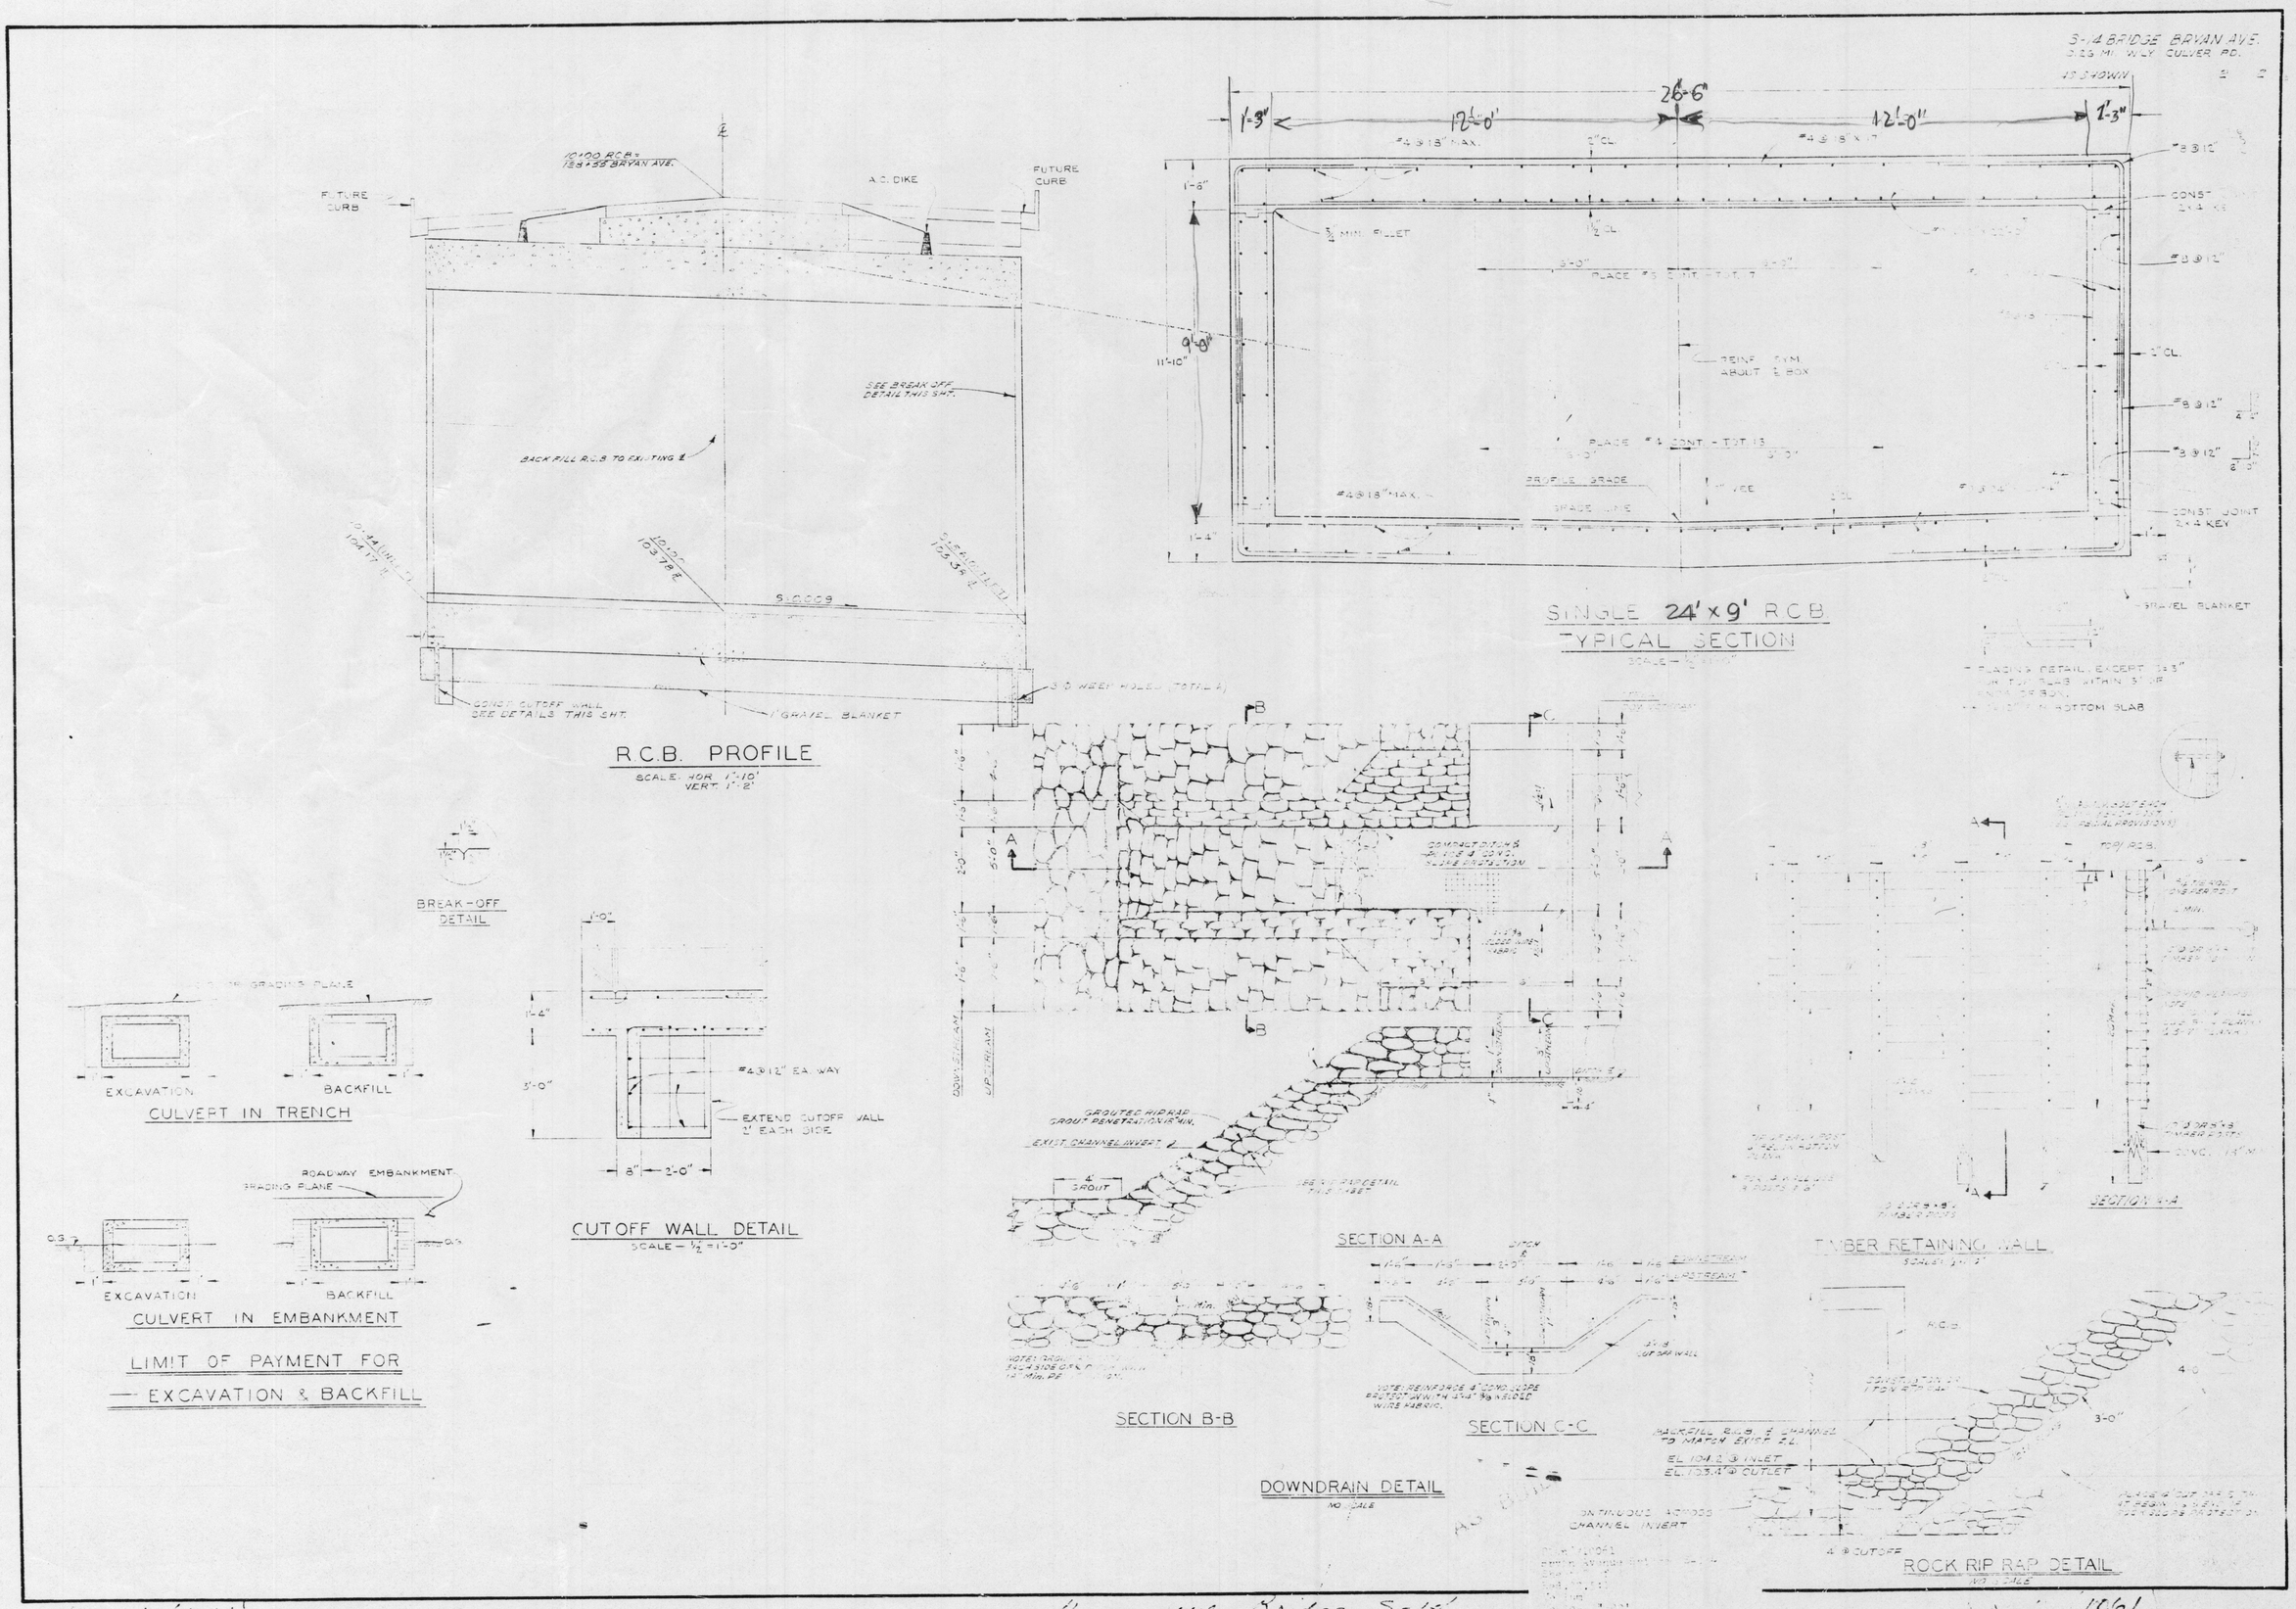

Div. 2 (1961)

Bryan Ave Bridge S-14

(1961)

SHT. 2/2