
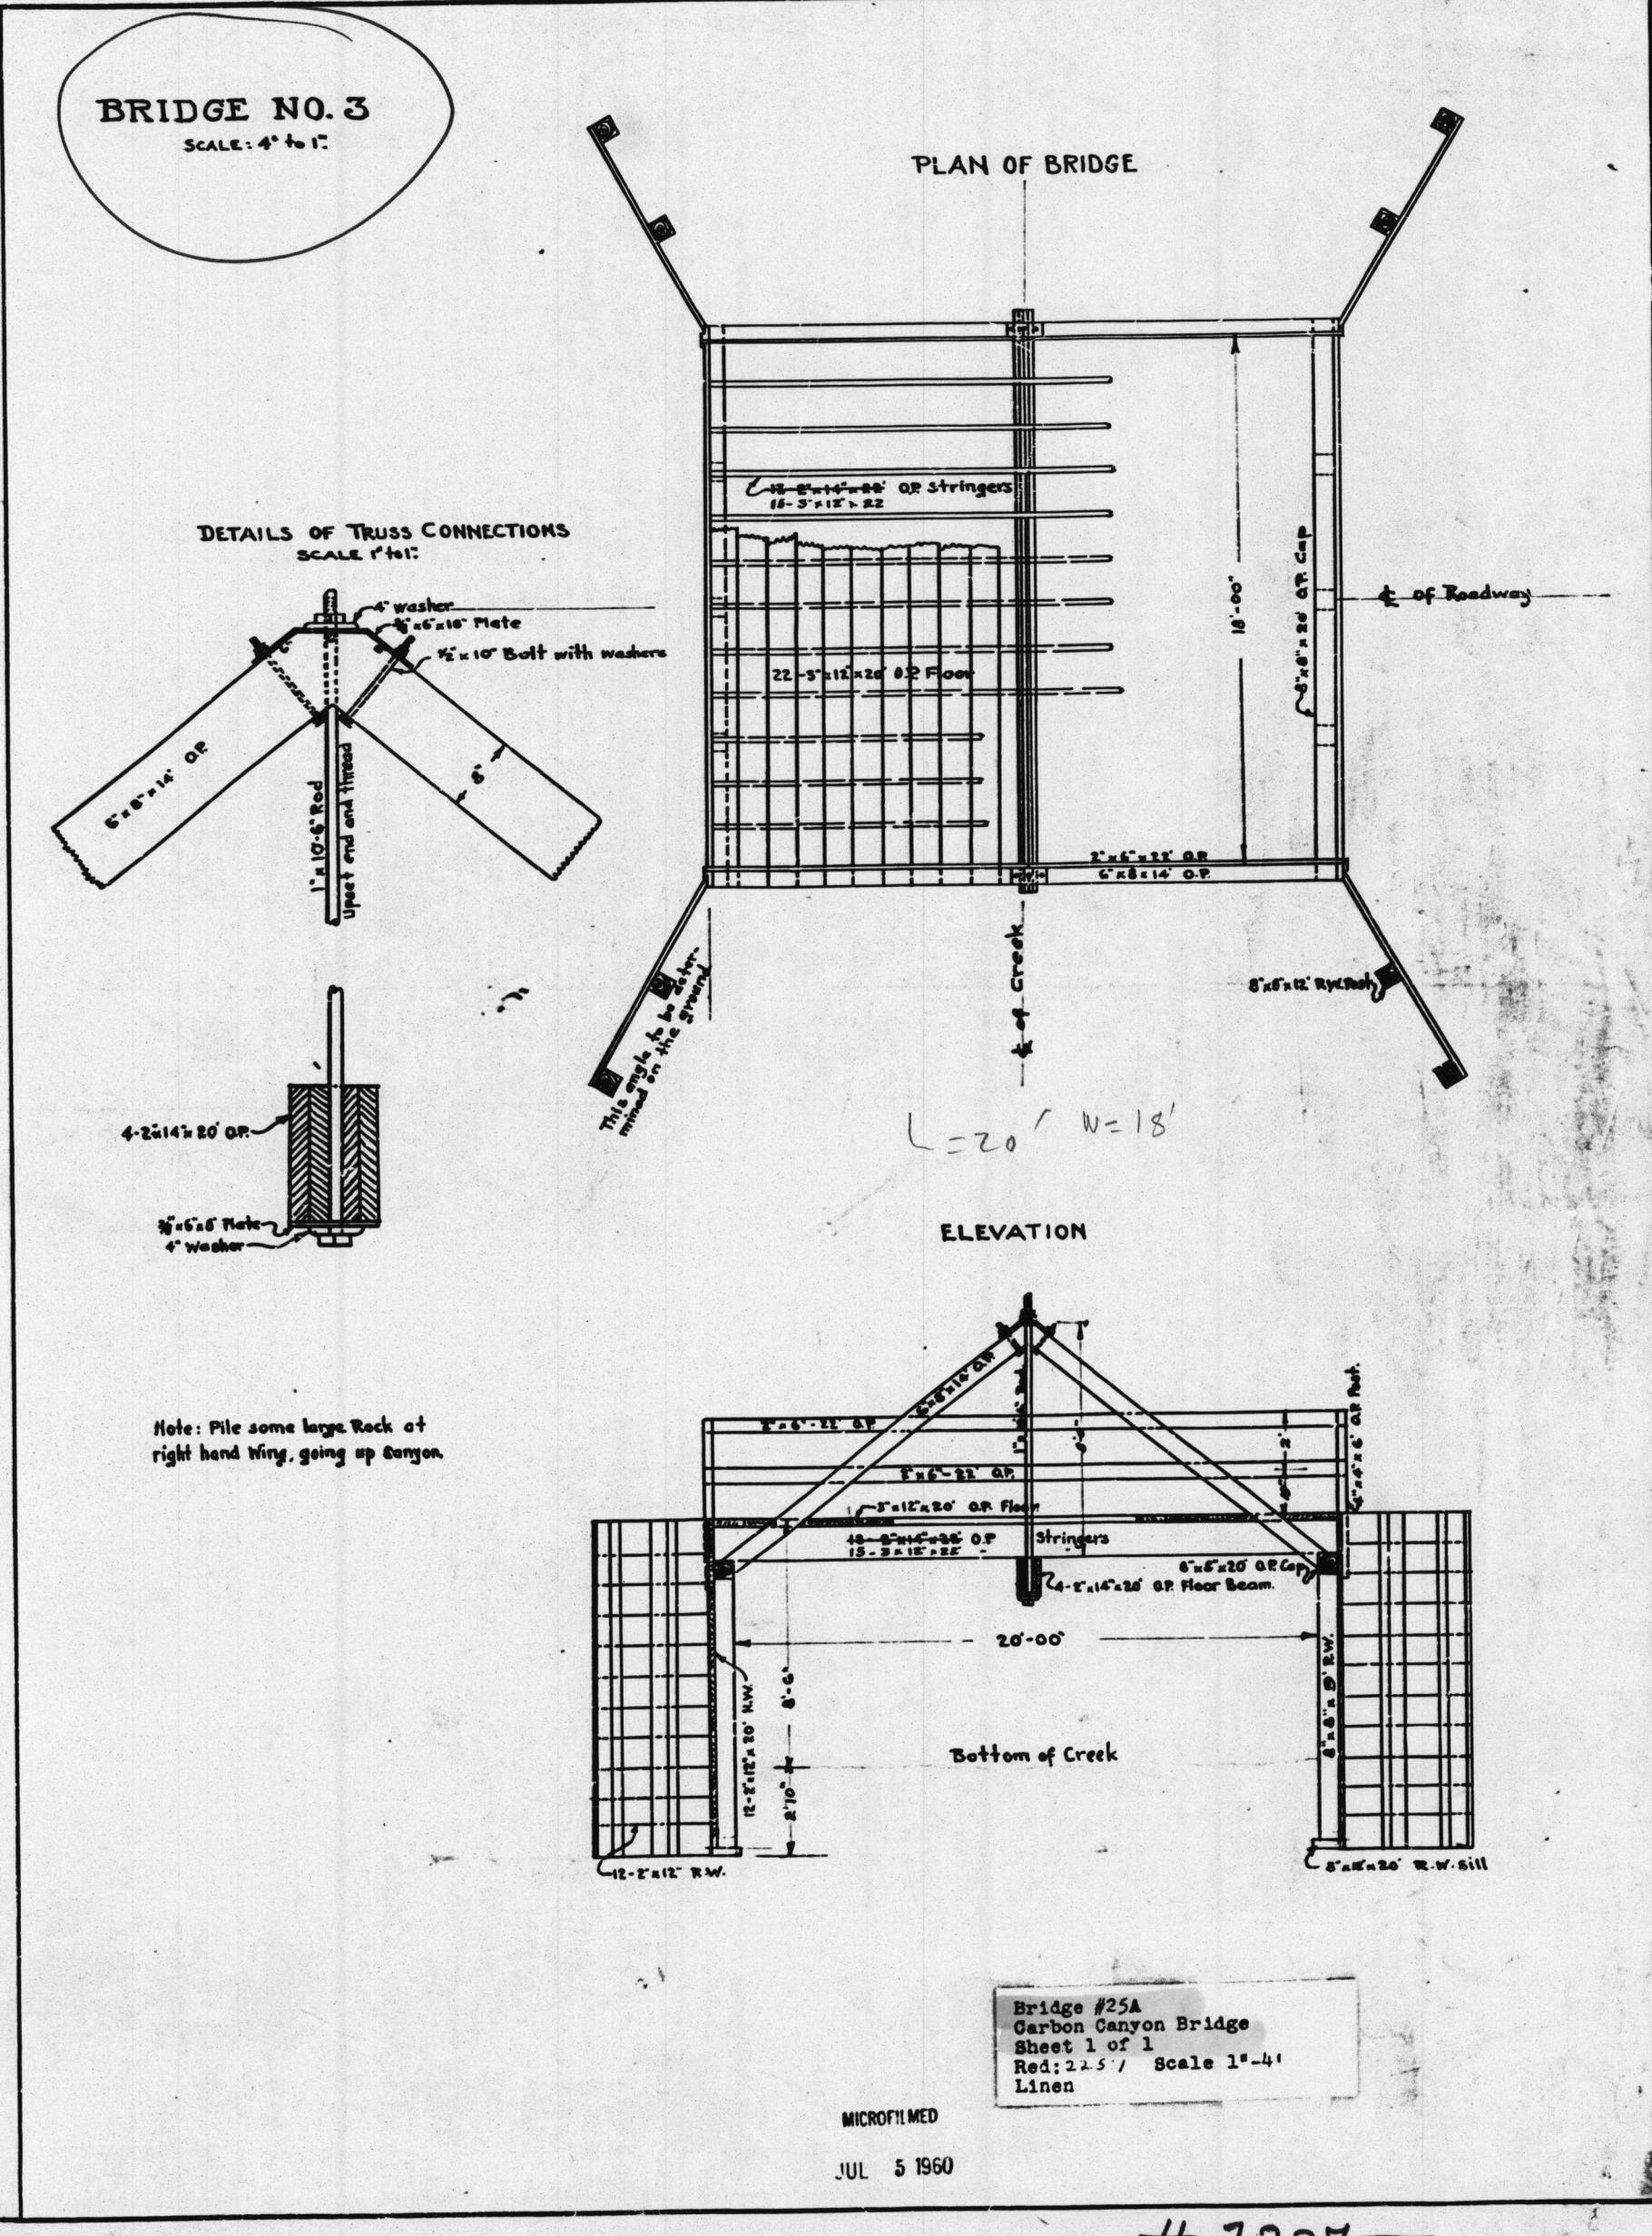


Carbon Canyon Br. 25A

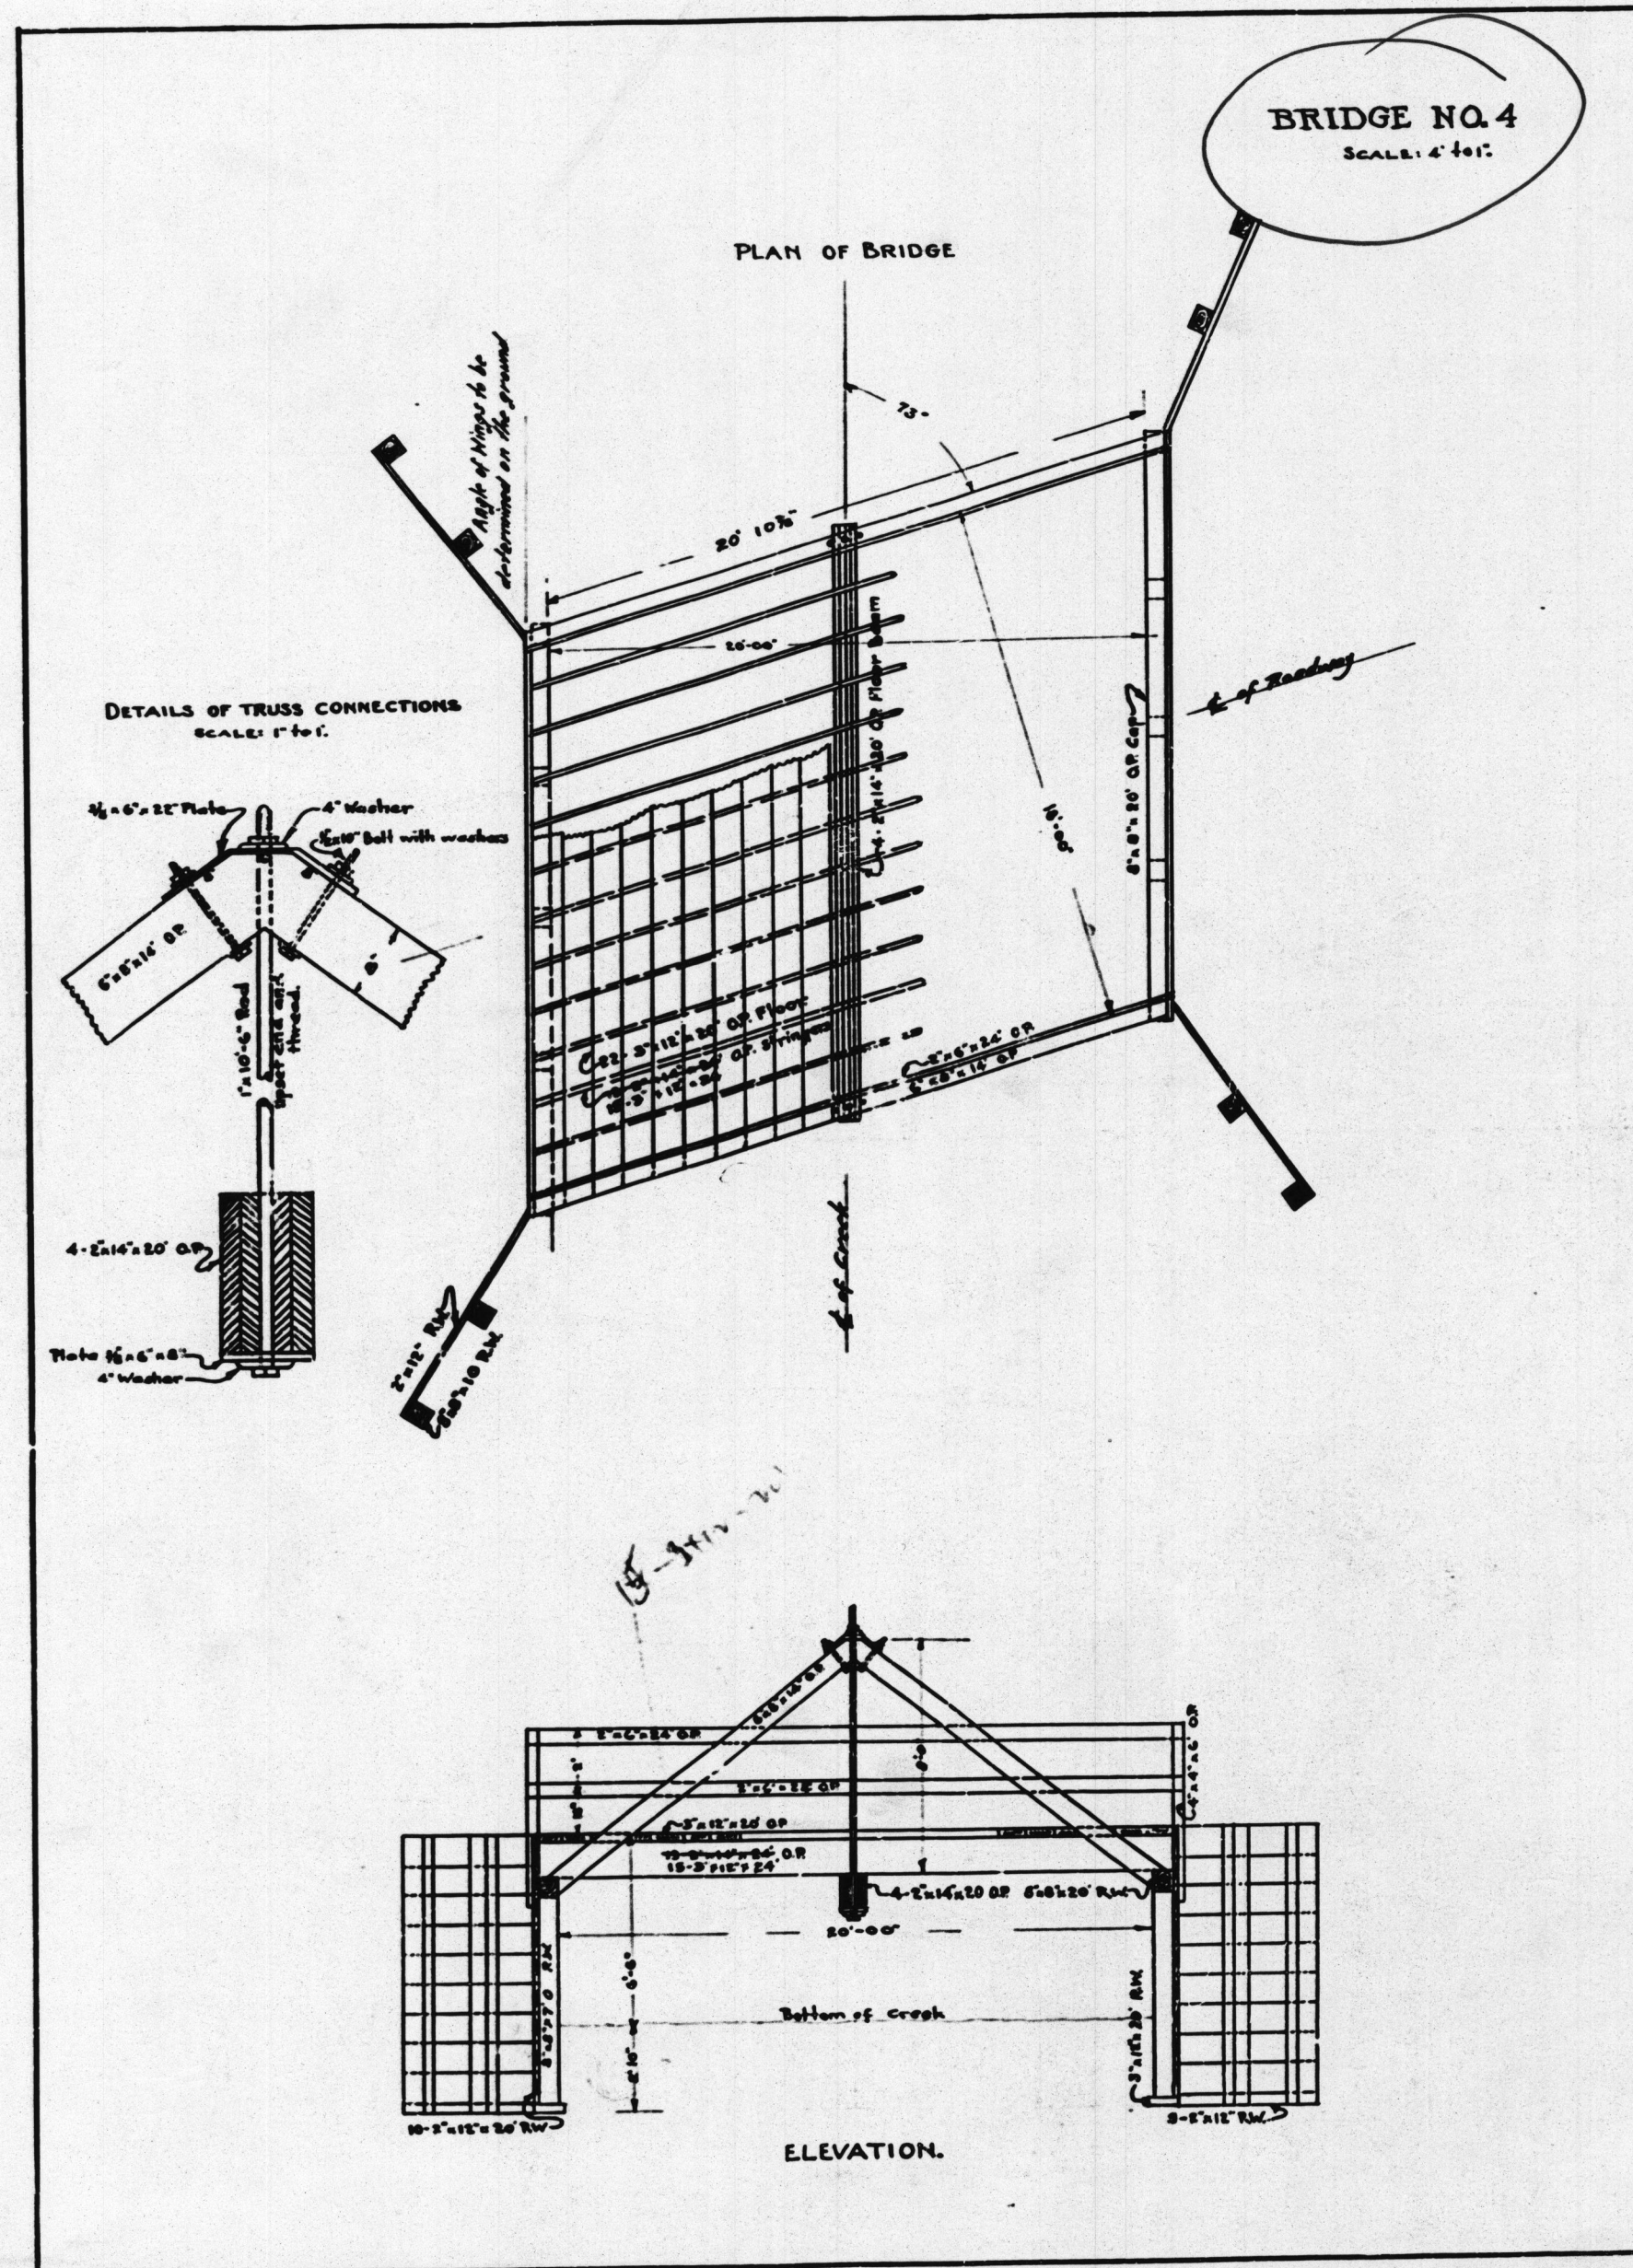

#7337
CARBON CYN BRs.
2 BRIDGES