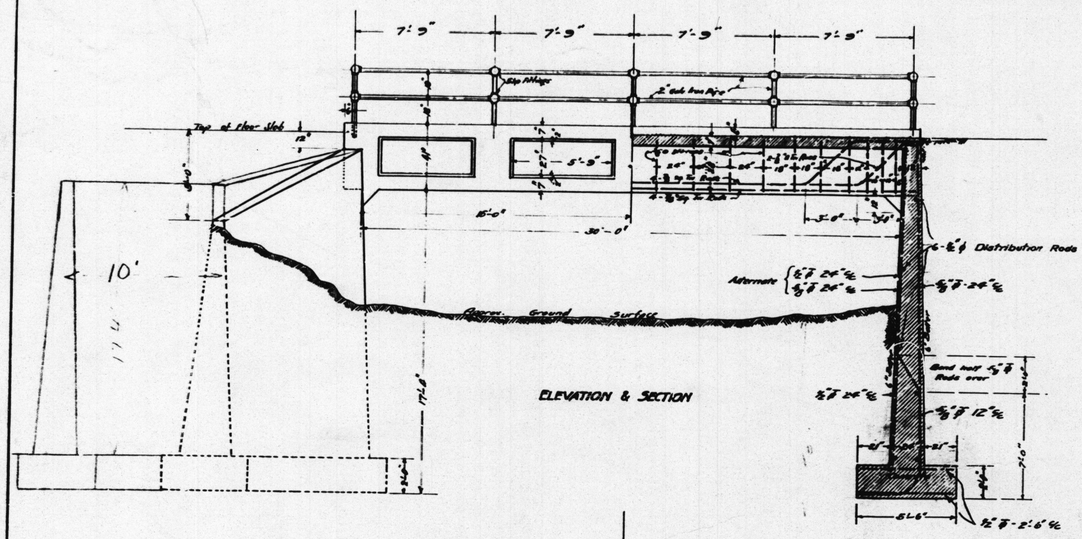

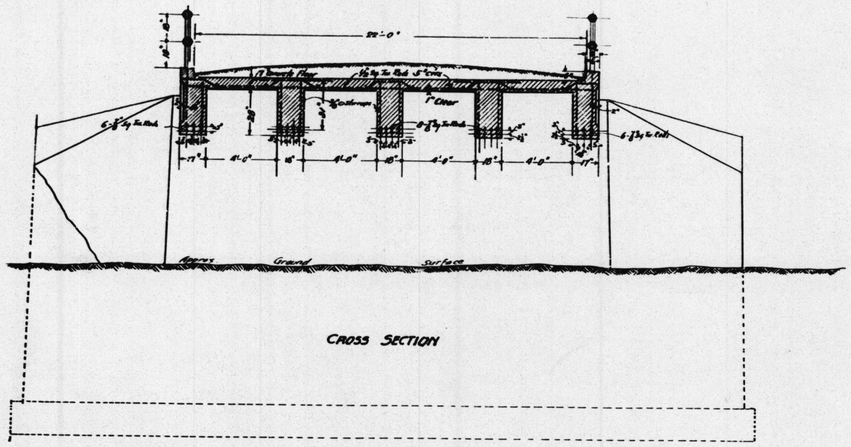

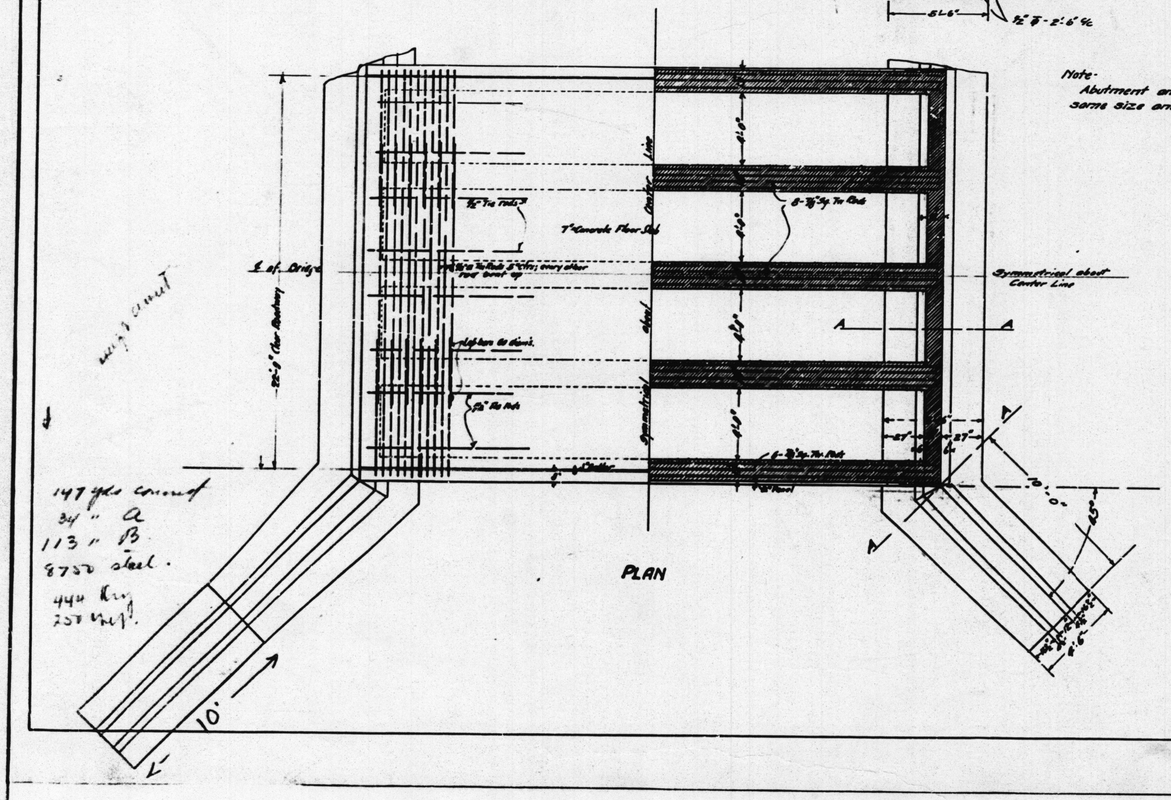

Note:
Abutment and Wing Wall Reinforcement to be same size and spacing, and 1 3/4" clear.

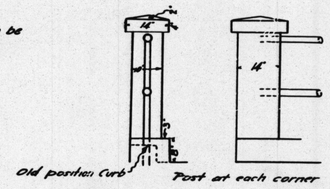

BRIDGE OVER BREA CANYON ON CENTRAL AVENUE

ONE MILE NORTH OF BREA, ORANGE COUNTY, CALIFORNIA

Scale: 1/4"=1'-0"

J. L. McBride - County Surveyor.

December 1, 1914.

Bridge BR-9
Central Ave Between
La Mirada Ave & Rd on
Co. Line
Sheet 2 of 4
Scale-As Shown
Linen

MICROFILMED
JUL 1 9 1991

SHT. 2 of 4

BR-9

L = 31'
W = 33'

#14505 1914
BR-9
CENTRAL AVE. BR.
OVER BREA CYN. Thomas: 709_B5