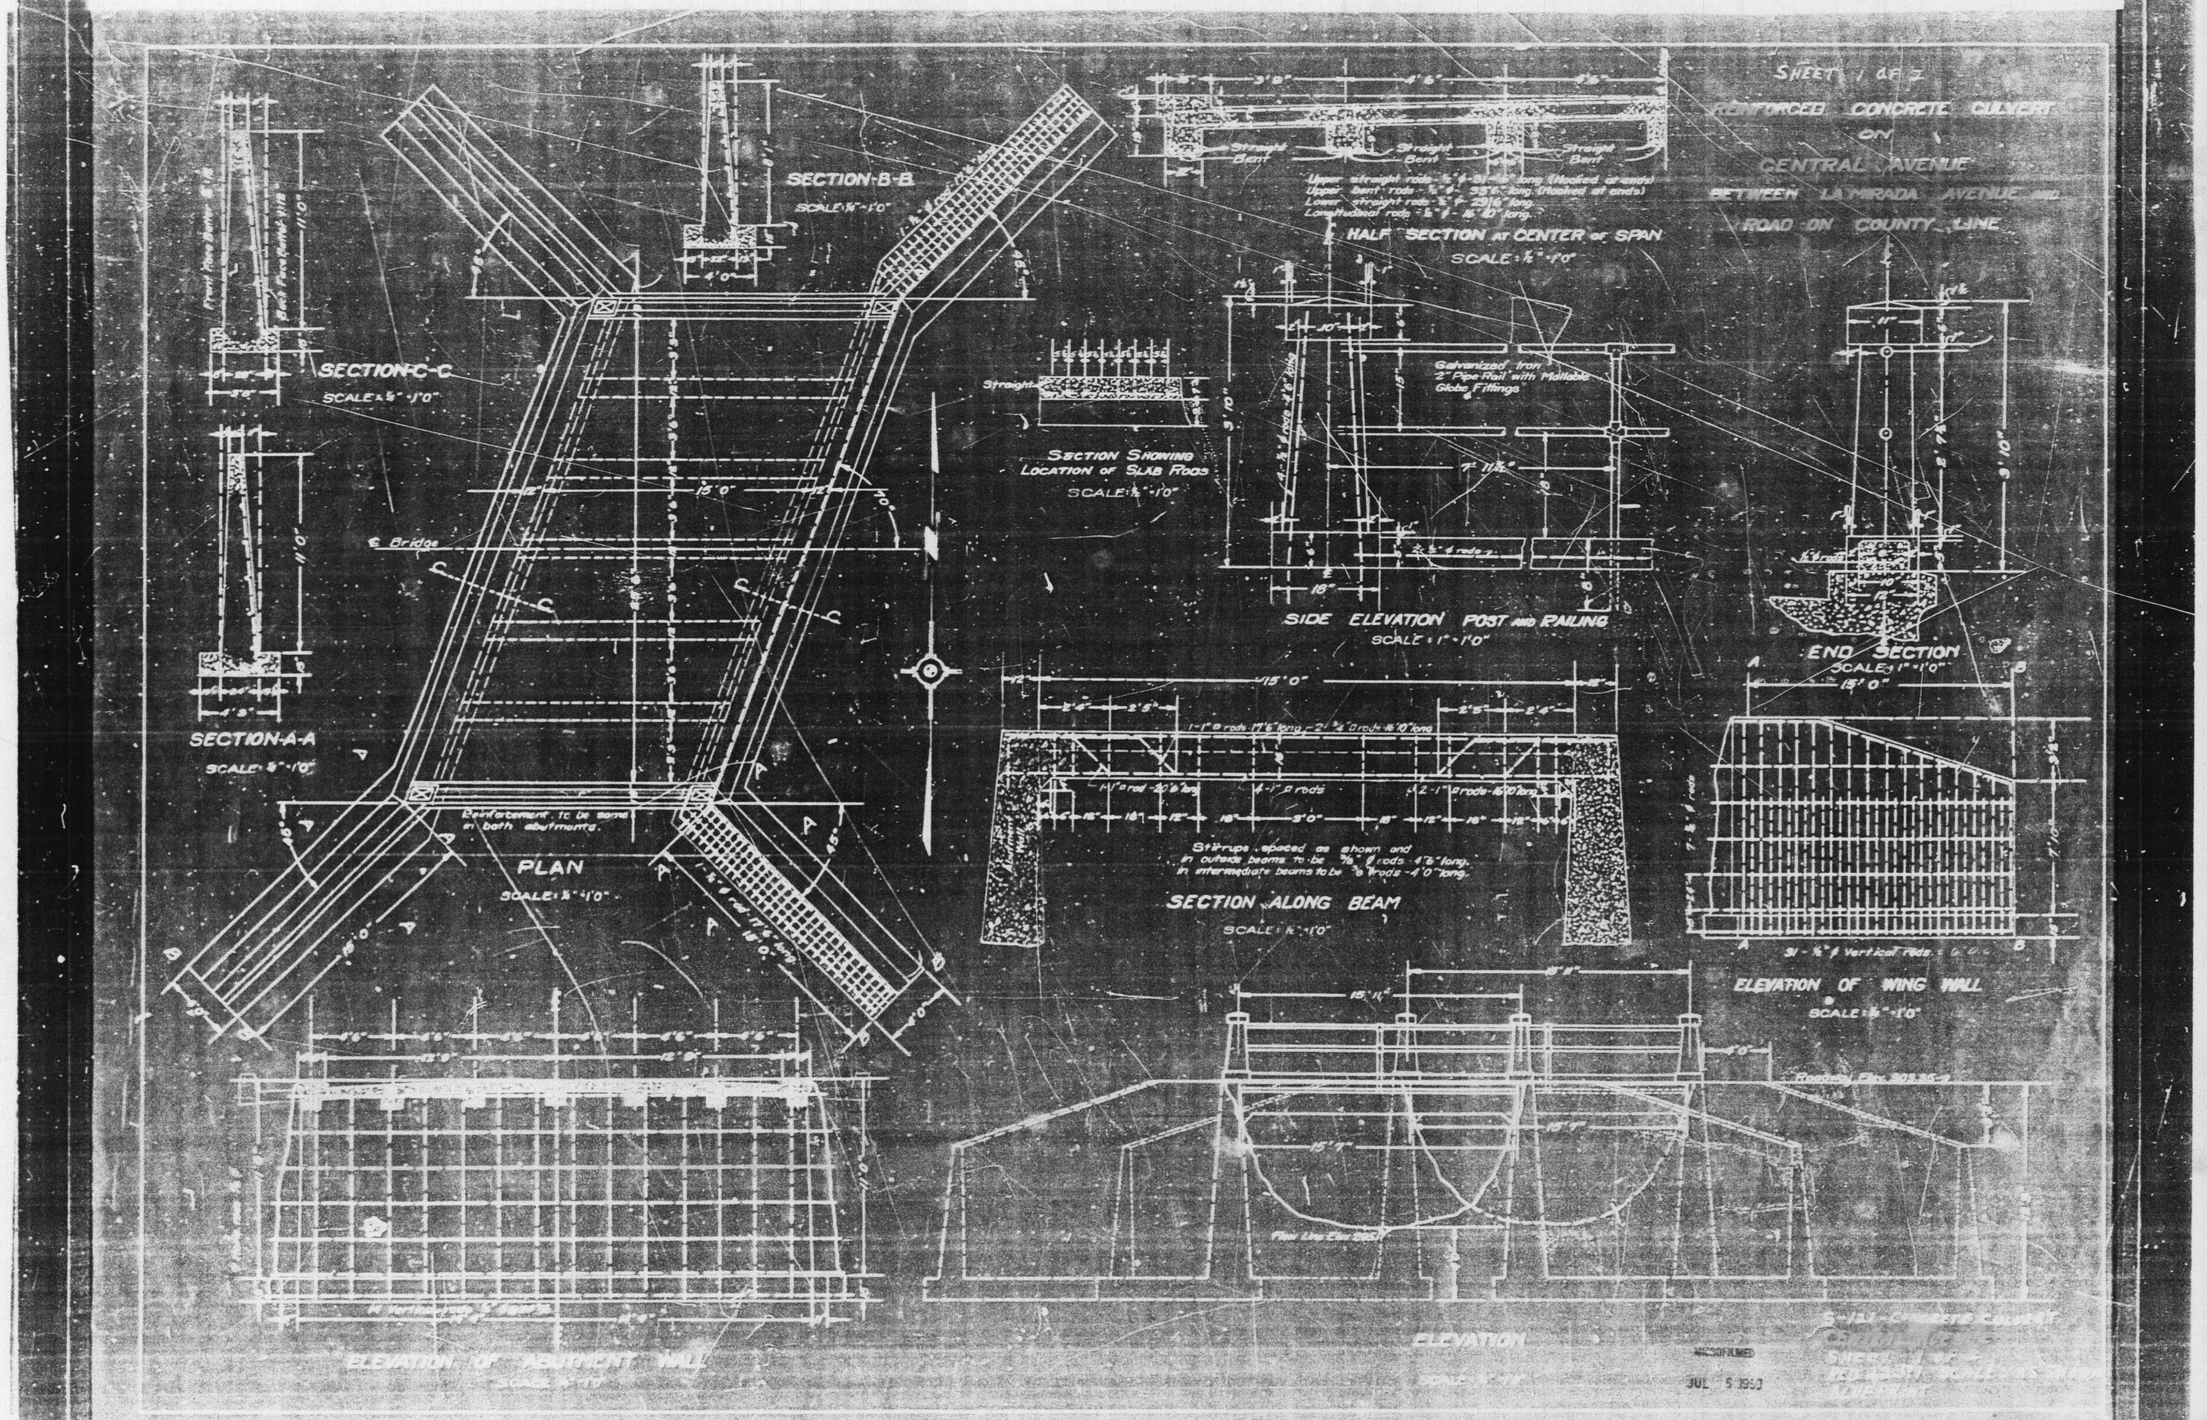

L = 20'

W { 28 + (3'8")2
28'

#14592 1949

S-121 CENTRAL AV.