


14 15

3 47 48

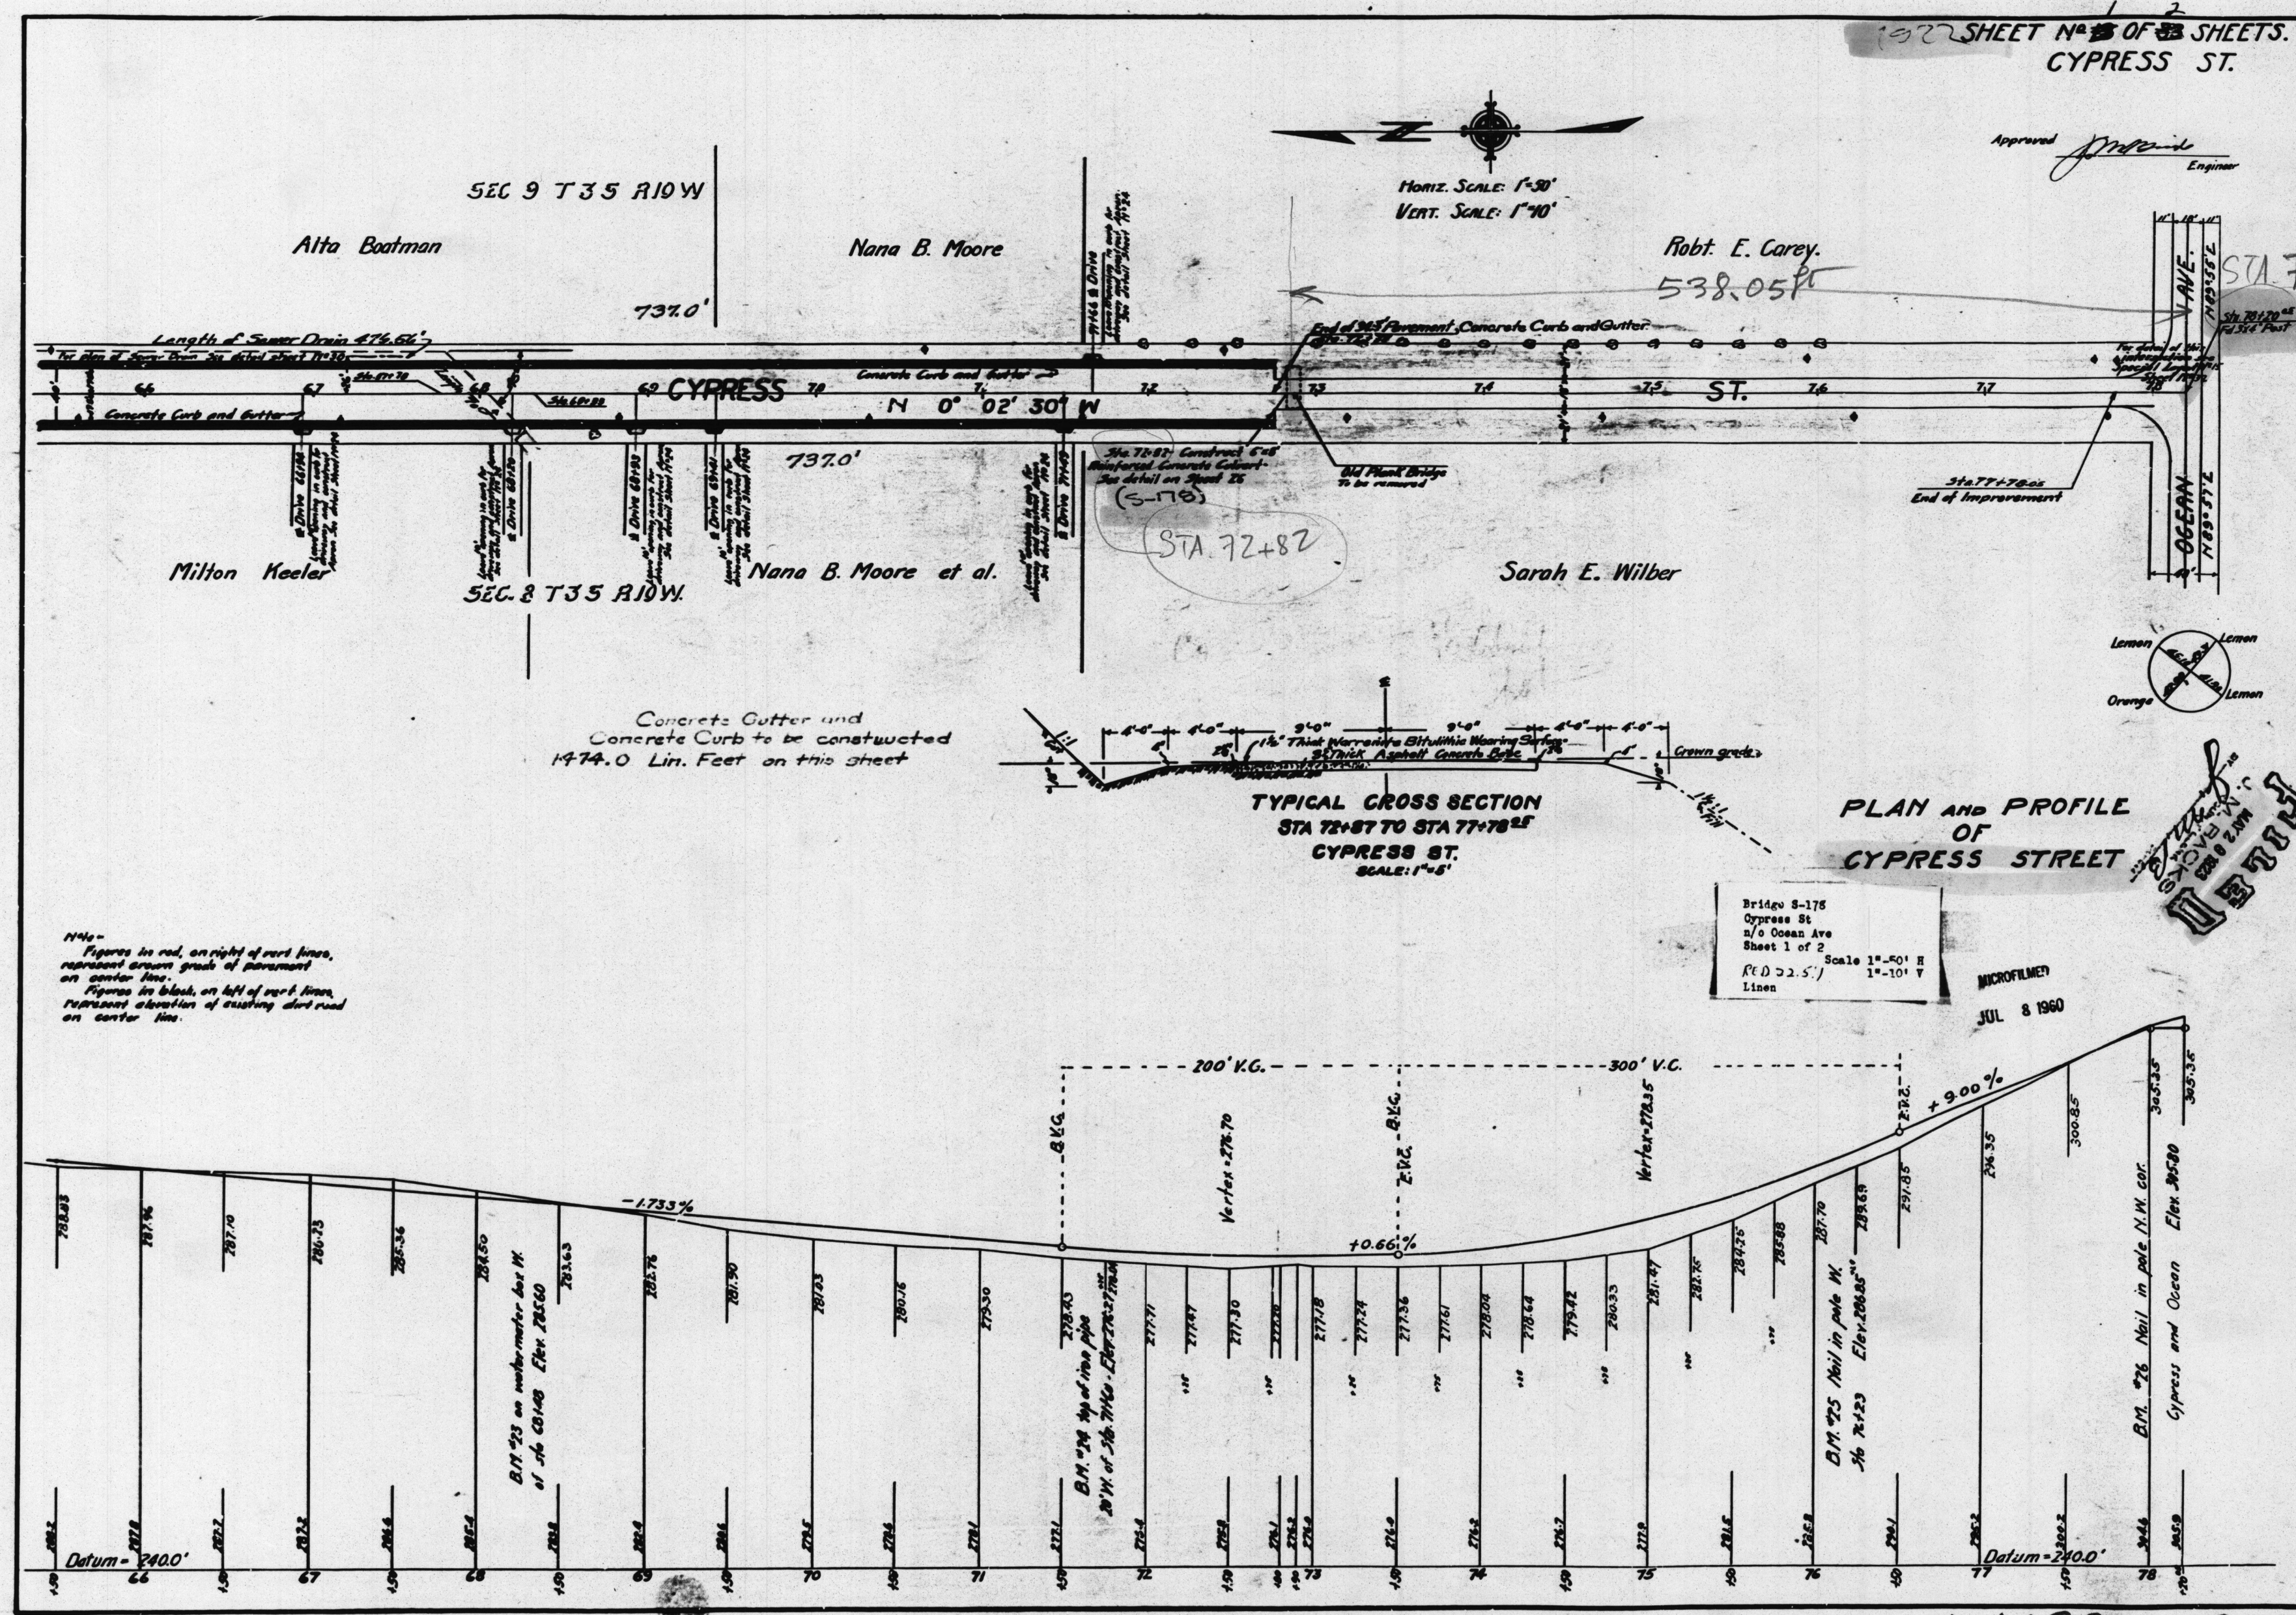

Notes -
Figures in red, on right of vert lines, represent proposed grade of pavement on center line.
Figures in black, on left of vert lines, represent elevation of existing street on center line.

6' x 8' RCB CULVERT
L = 40'

#14613 1922
S-178

CYPRESS ST. CULVERT
538.05ft N/O OCEAN AVE.