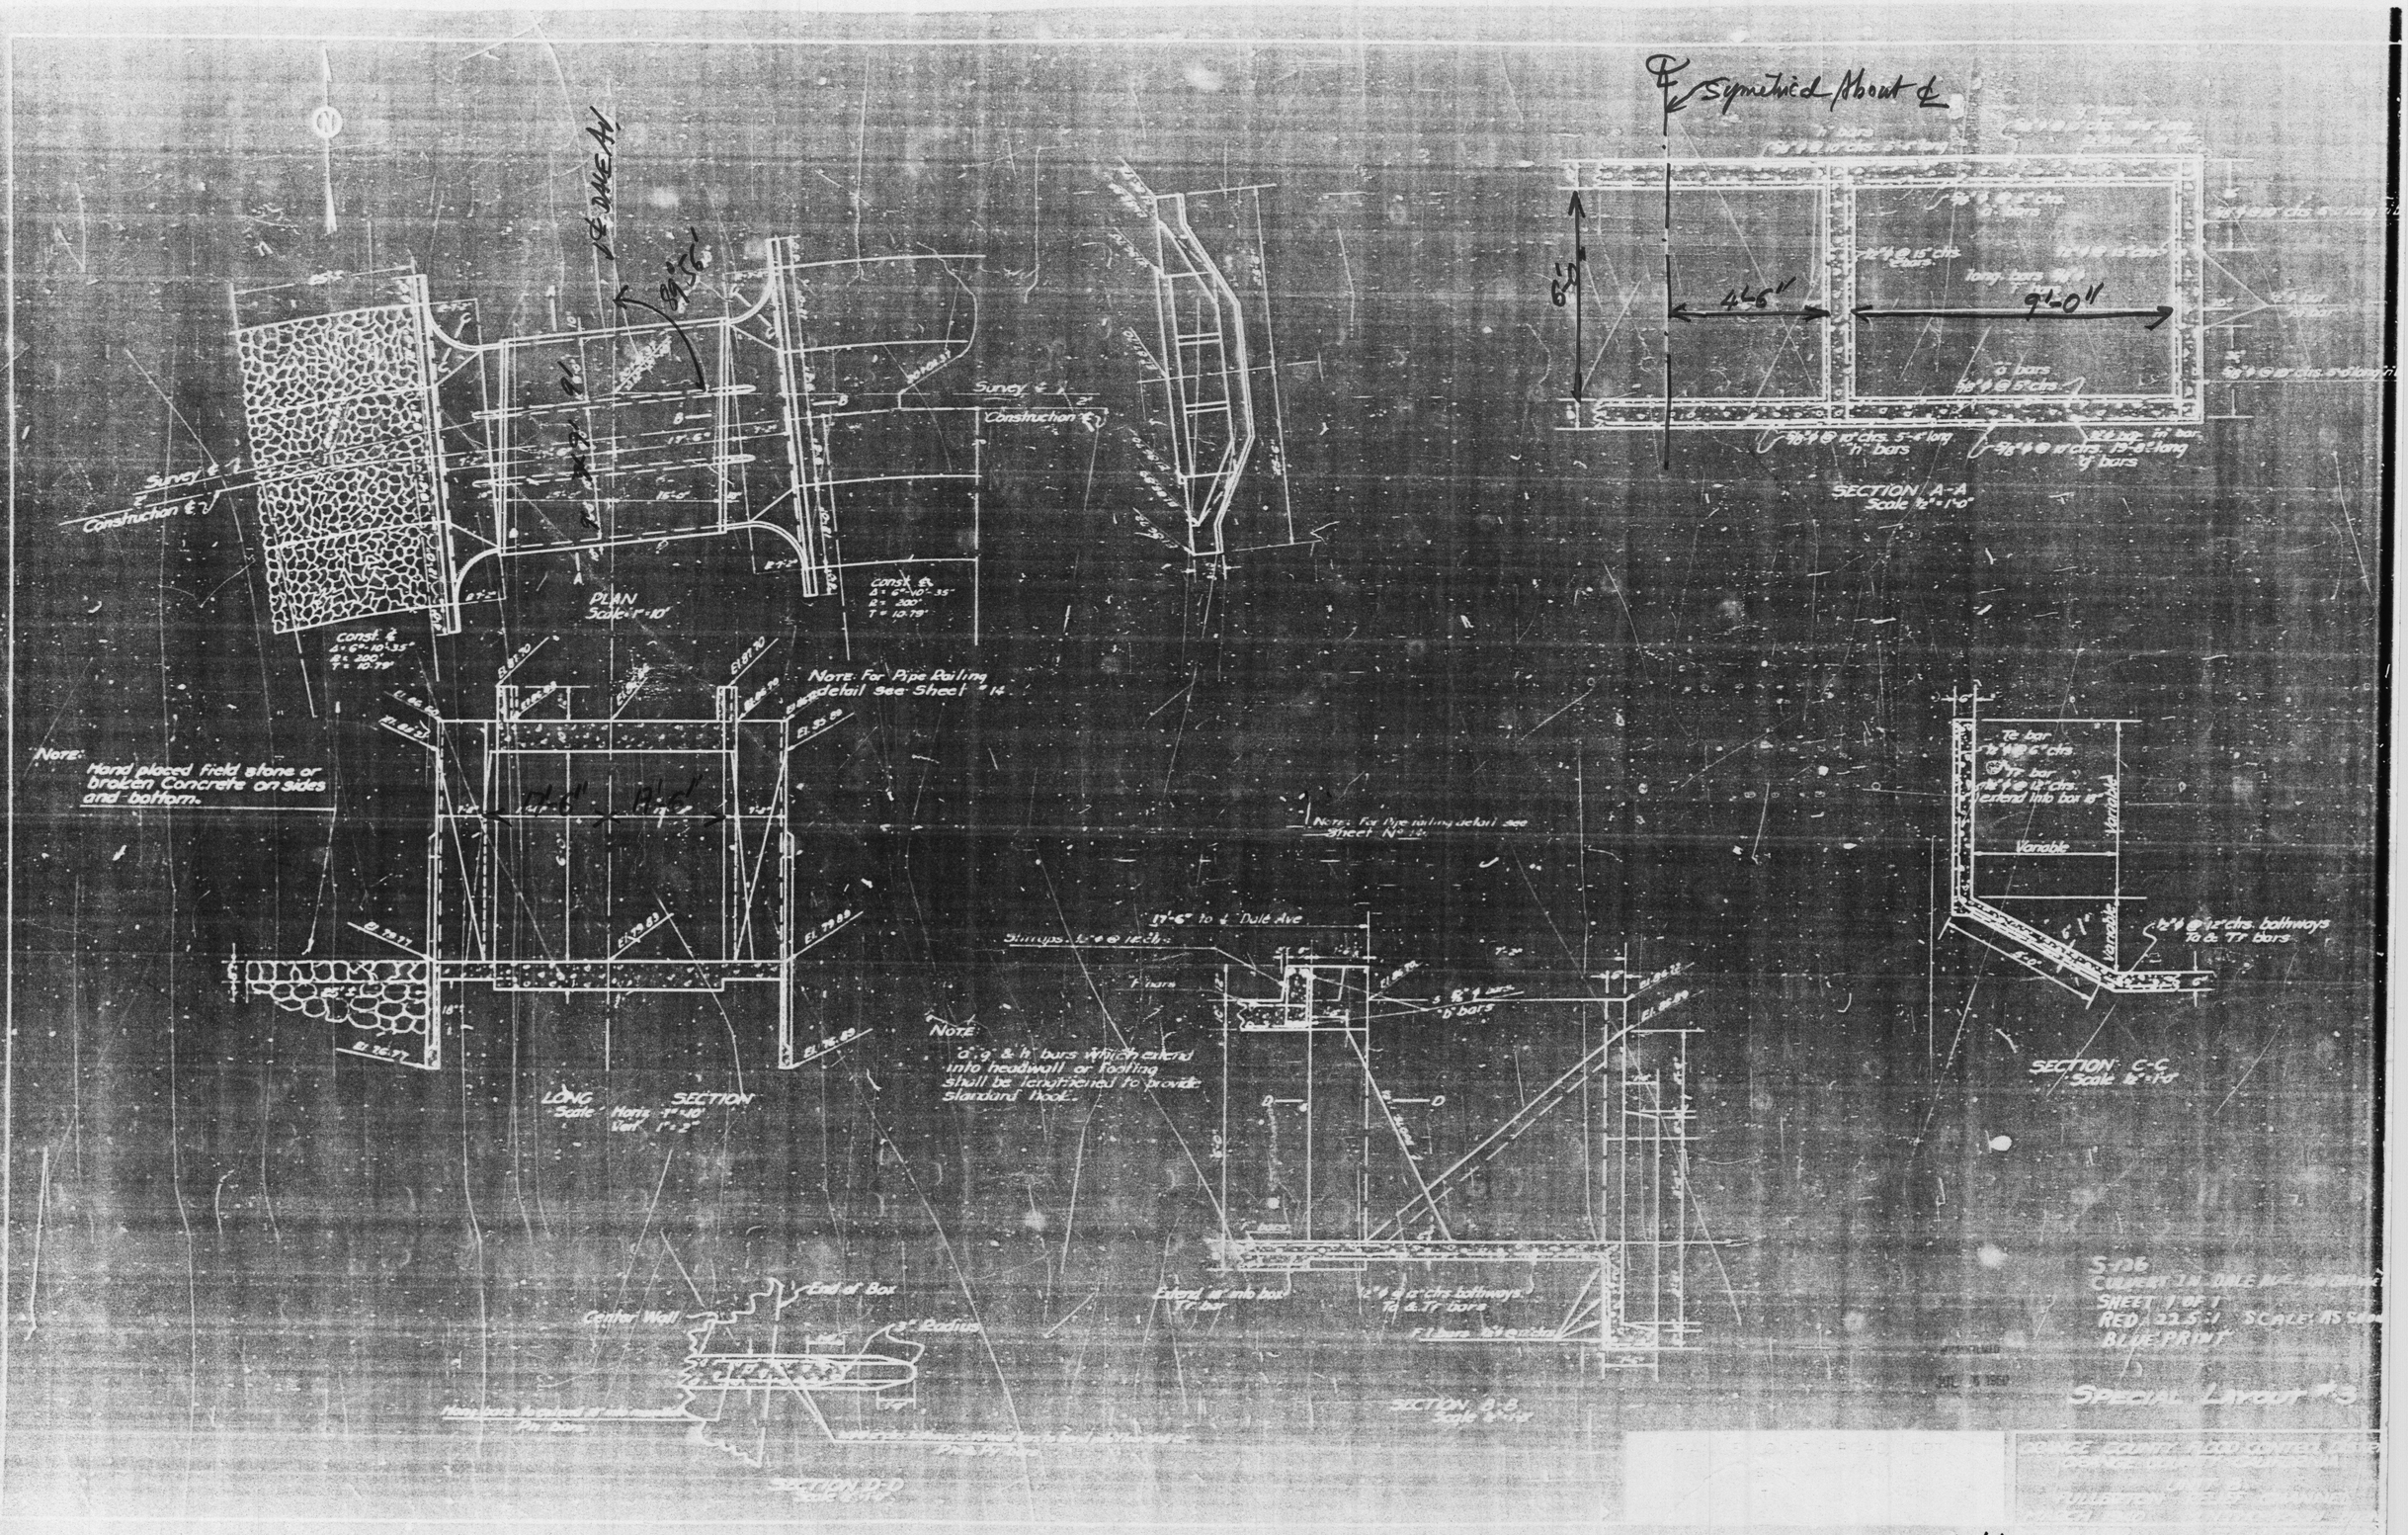

#14600 1940.
CULVERT IN DALE AVE.
N/O ORangethorpe.
S-136
Thomas: 768-A1