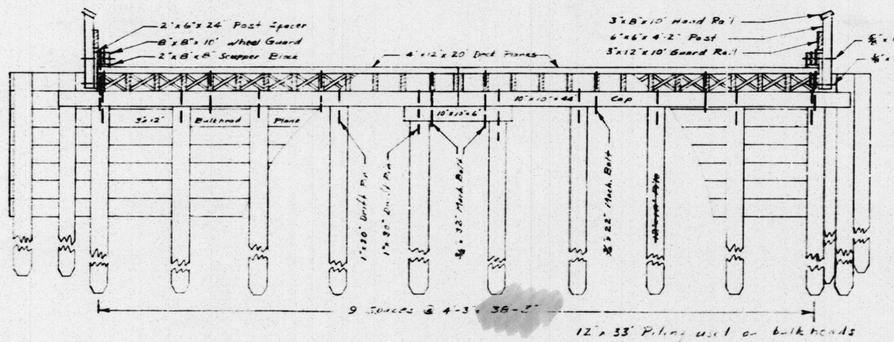

SECTION A-A
SCALE: ½"=1'-0"

NOTE: 1"x6" Lagging on fill side of all bulkhead and wingwalls. Bulkhead anchor rods at ⅓ point above ft. Wingwall anchors 1' above bulkhead anchors. Top 5 wingwall planks mitered to angle of bulkhead. Ends of wingwalls to set in 6" from end of bulkhead.

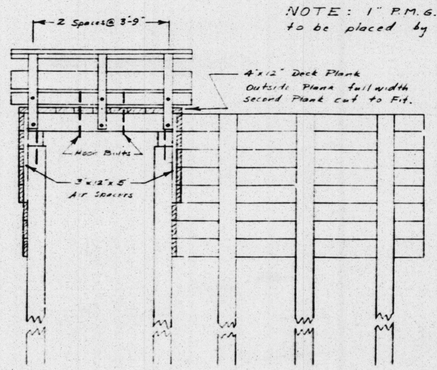

NOTE: 1" P.M.G. Deck Surfacing to be placed by others.

EAST ELEVATION
SCALE: ½"=1'-0"

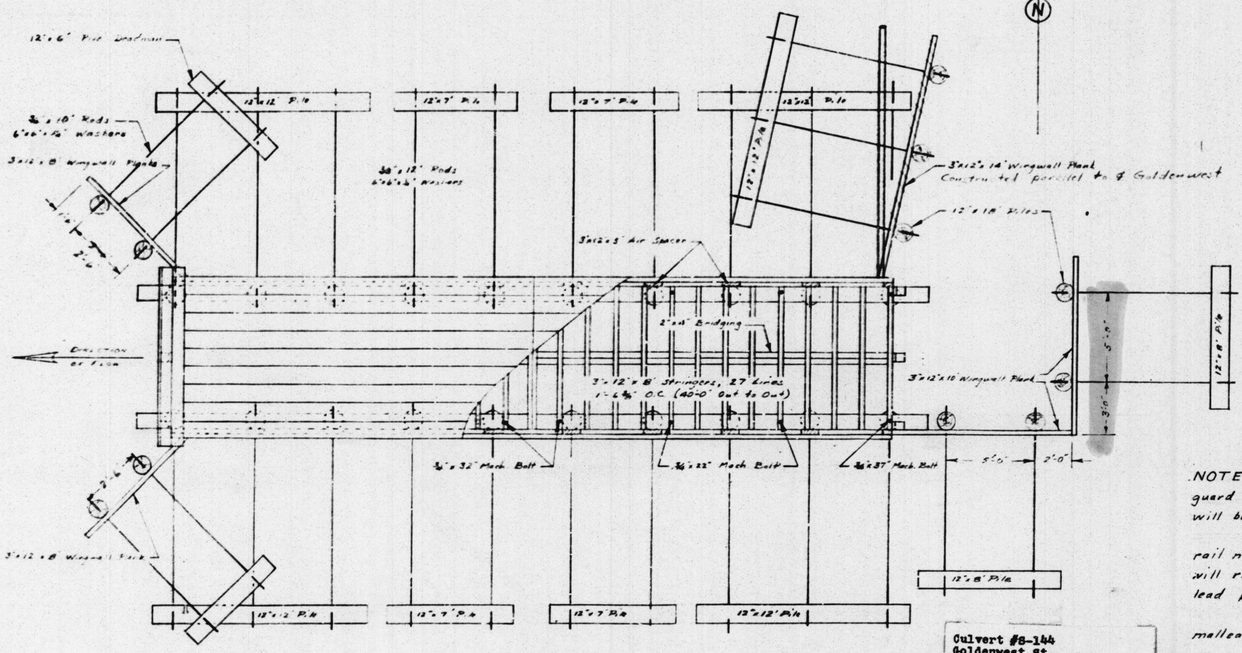

PLAN
SCALE: ½"=1'-0"

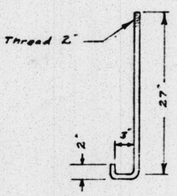

HOOK BOLT DETAIL
SCALE: 1"=1'-0"

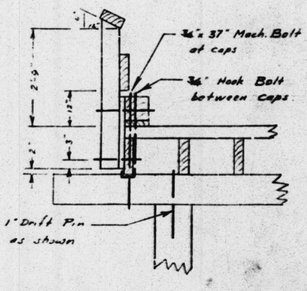

GUARD RAIL DETAIL
SCALE: ½"=1'-0"

ORANGE CO. HIGHWAY DEPT.		
	METAL	
TRACED BY	R.M.B.	4/21/43
	TMC	6/18/48
	TMC	6/18/48

Culvert #S-144
Goldenwest St
at Bolsa Avenue
Sheet 1 of 1
Red: 22.5.1 Scale as shown
Vellum-Pencil Sketch

NOTE: All lumber except wheel guard and guard rail members will be rough, creosoted.

Wheel guard and guard rail members will be S4S and will receive 3 coats of white lead paint.

All bolt assemblies to have malleable washers except as noted.

Changes shown in Red

MICROFILMED
JUL 5 1960

ORANGE COUNTY HIGHWAY DEPT.

WOODEN CULVERT
STRUCTURE NO. S-144
ON
GOLDENWEST STREET
AT BOLSA AVE.

APPROVED [signature]
H. SPRENGER, ROAD COMMISSIONER

SCALE: AS SHOWN APRIL 1948

#14603 1948
S-144
GOLDENWEST ST.
@ Bolsa Av.
Thomas 827-H3