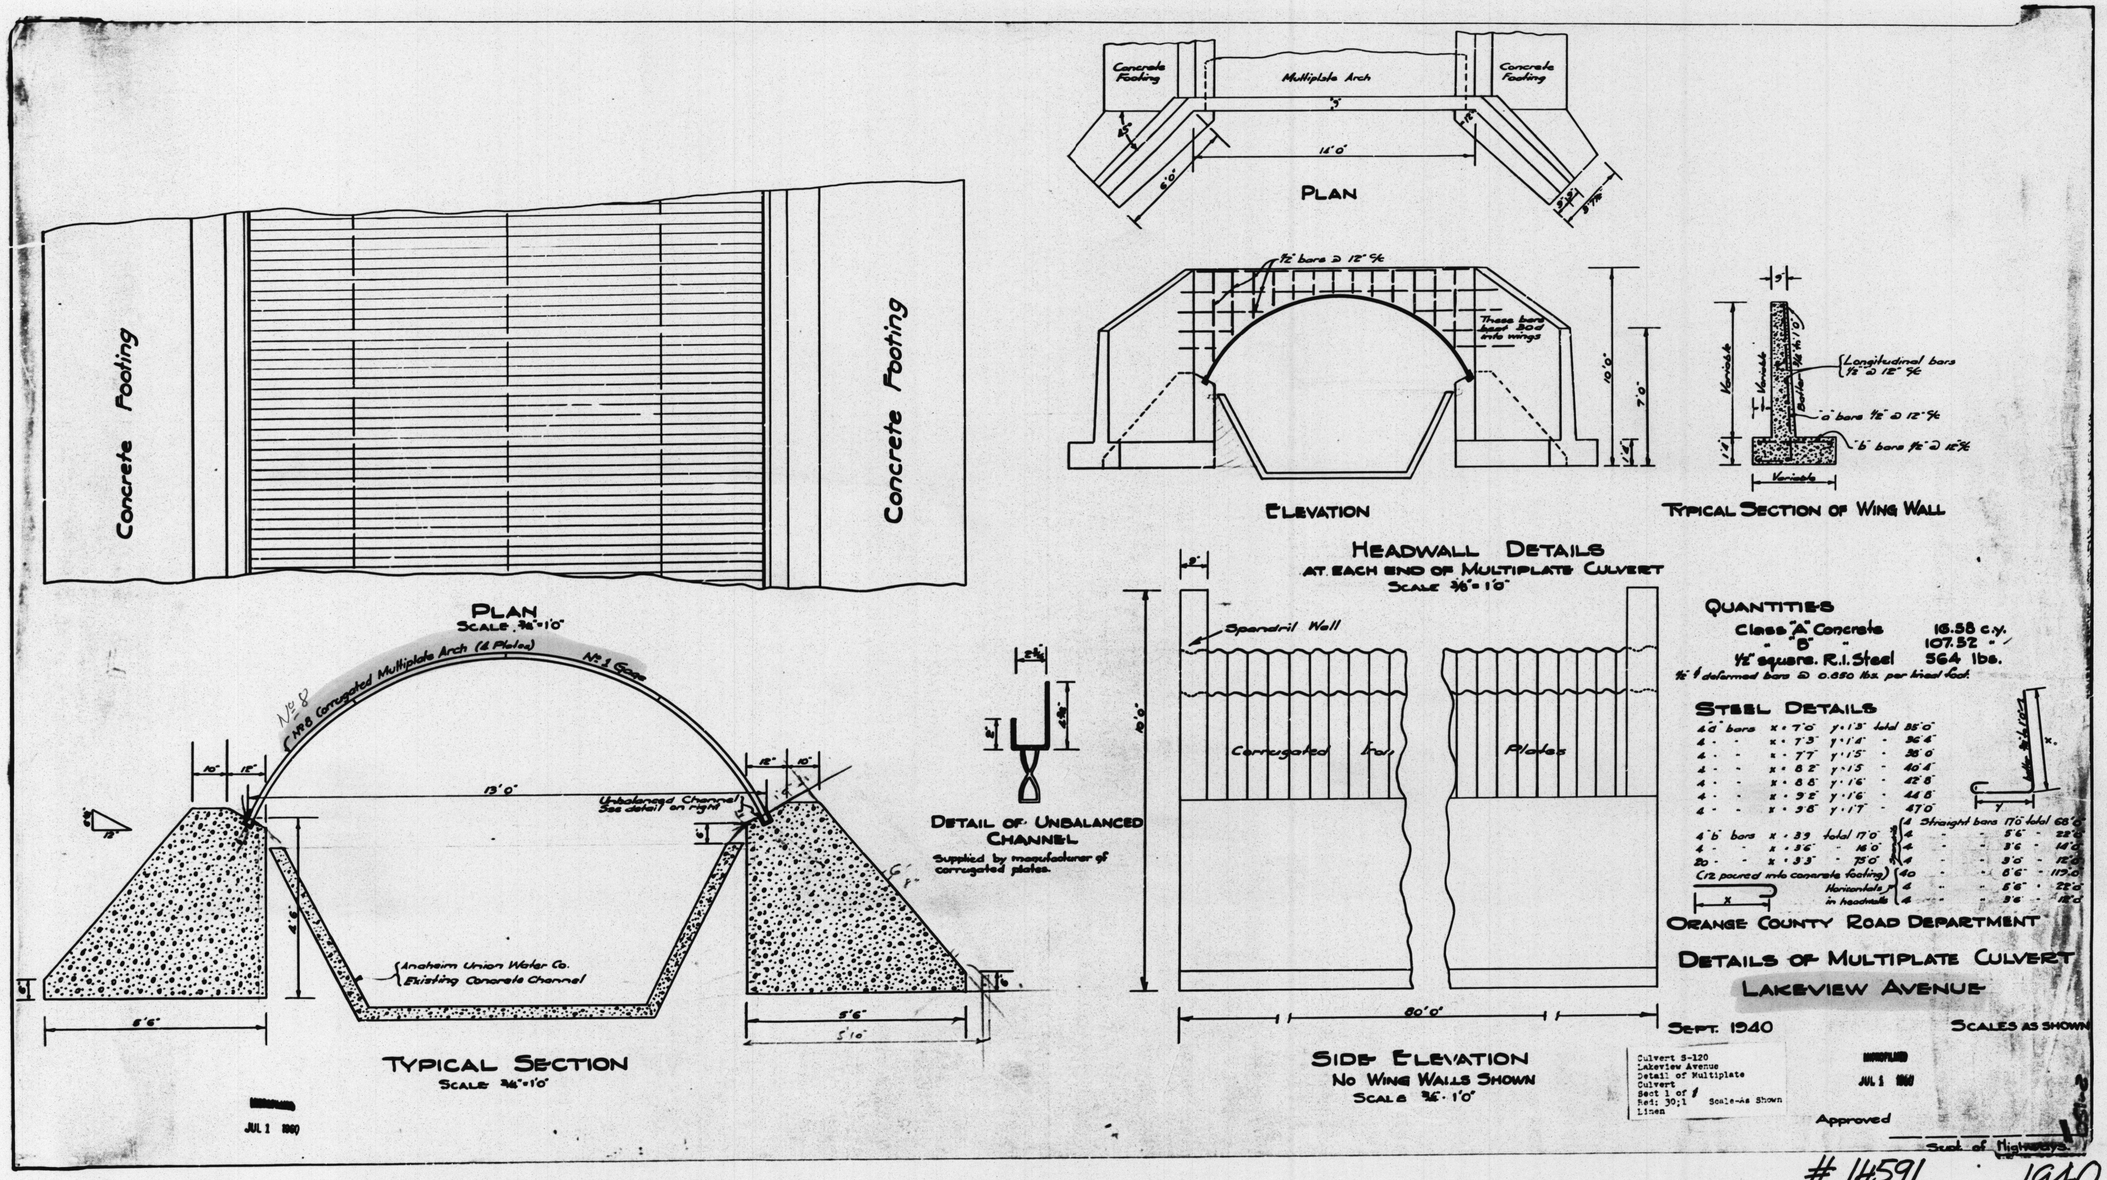

14591 1940
S-120
LAKEVIEW AV.
738-P1