SA-10
Anaheim-Olive Rd. Bridge
(Lincoln Ave) "AS BUILT"
over Santa Ana River
Sheet 1 of 14
Red 22.5:1 Scale 1"=50' H
1"=10' V
Blueline Print

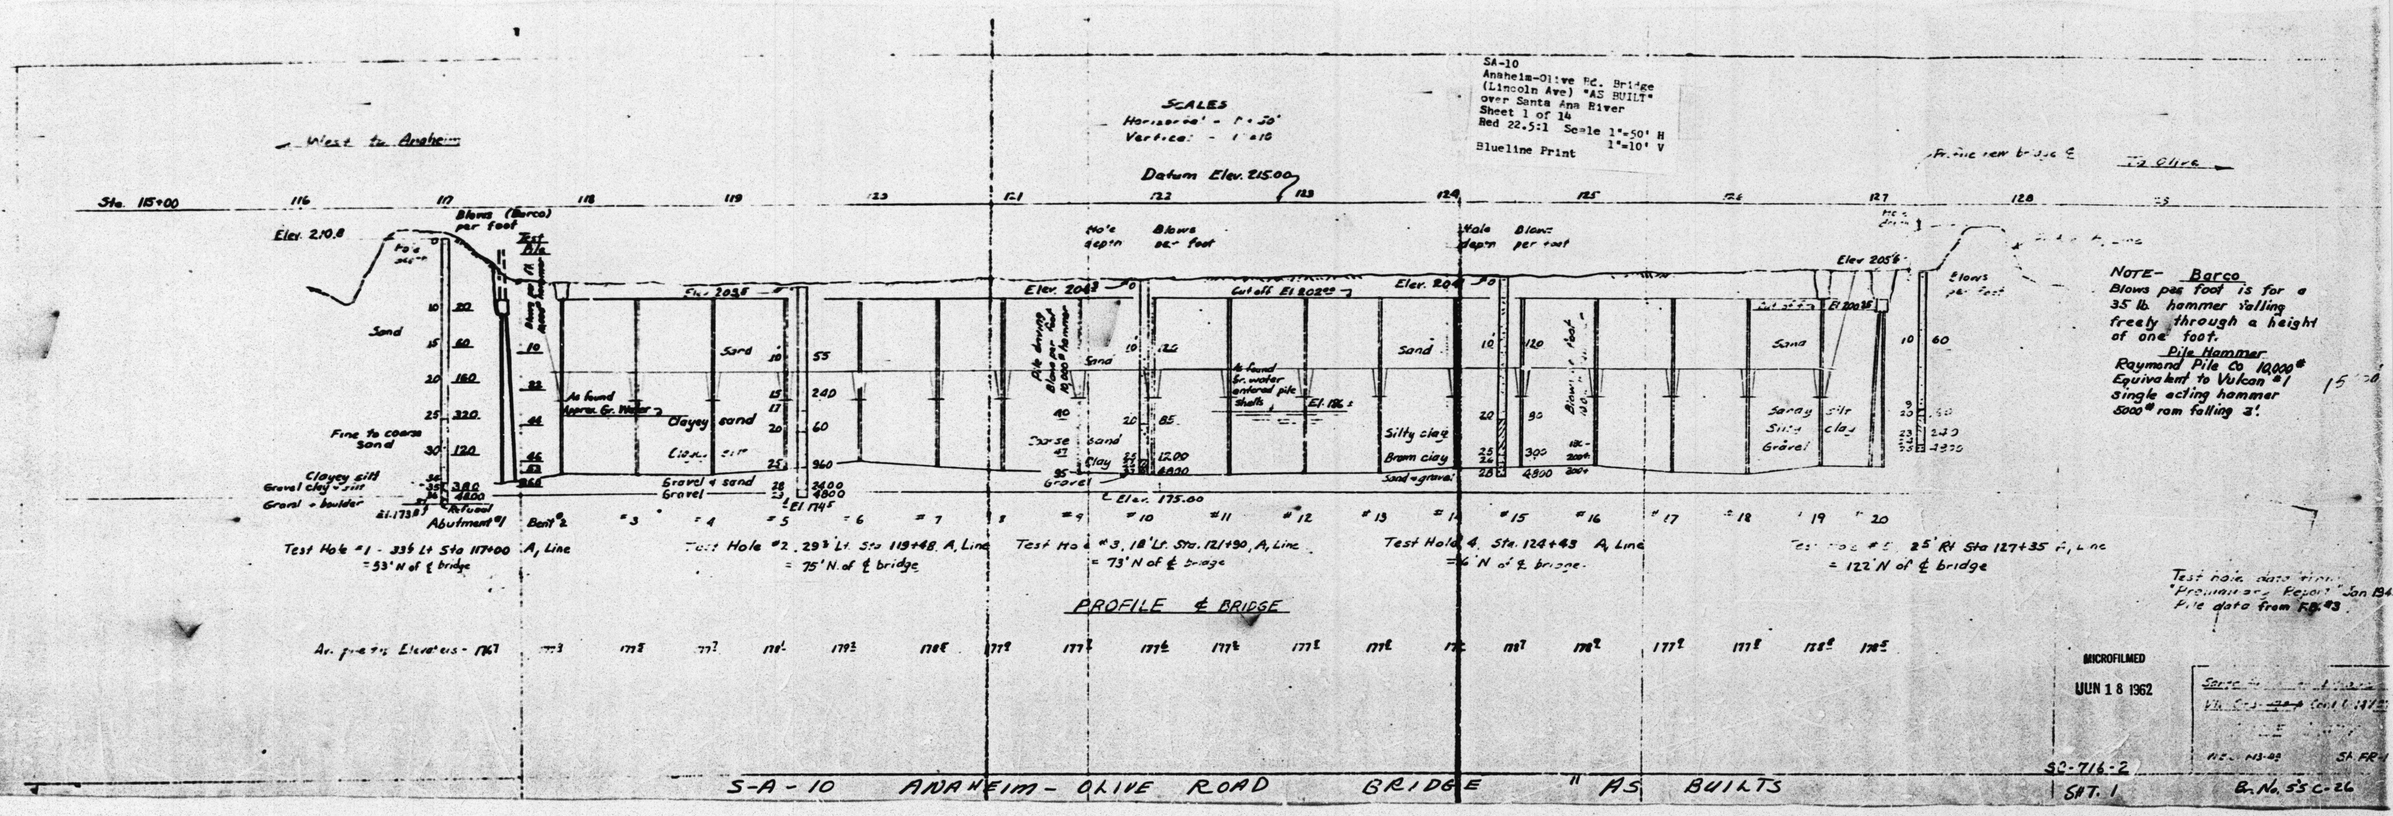

NOTE- Barco Blows per foot is for a 35 lb. hammer falling freely through a height of one foot.
Pile Hammer
Raymond Pile Co 10,000# Equivalent to Vulcan #1 single acting hammer 5000# ram falling 3'.

Test hole data from "Preliminary Report" Jan 194
Pile data from F.B. 43.

MICROFILMED
JUN 18 1962

S-A-10 ANAHEIM-OLIVE ROAD BRIDGE "AS BUILTS

SC-716-2
SHT. 1

Br. No. 55C-26

#14631
SA-10
Lincoln Ave (old: Anaheim-Olive Rd) over S.A.R.
Roaches Approaches & Retaining walls.
1949