


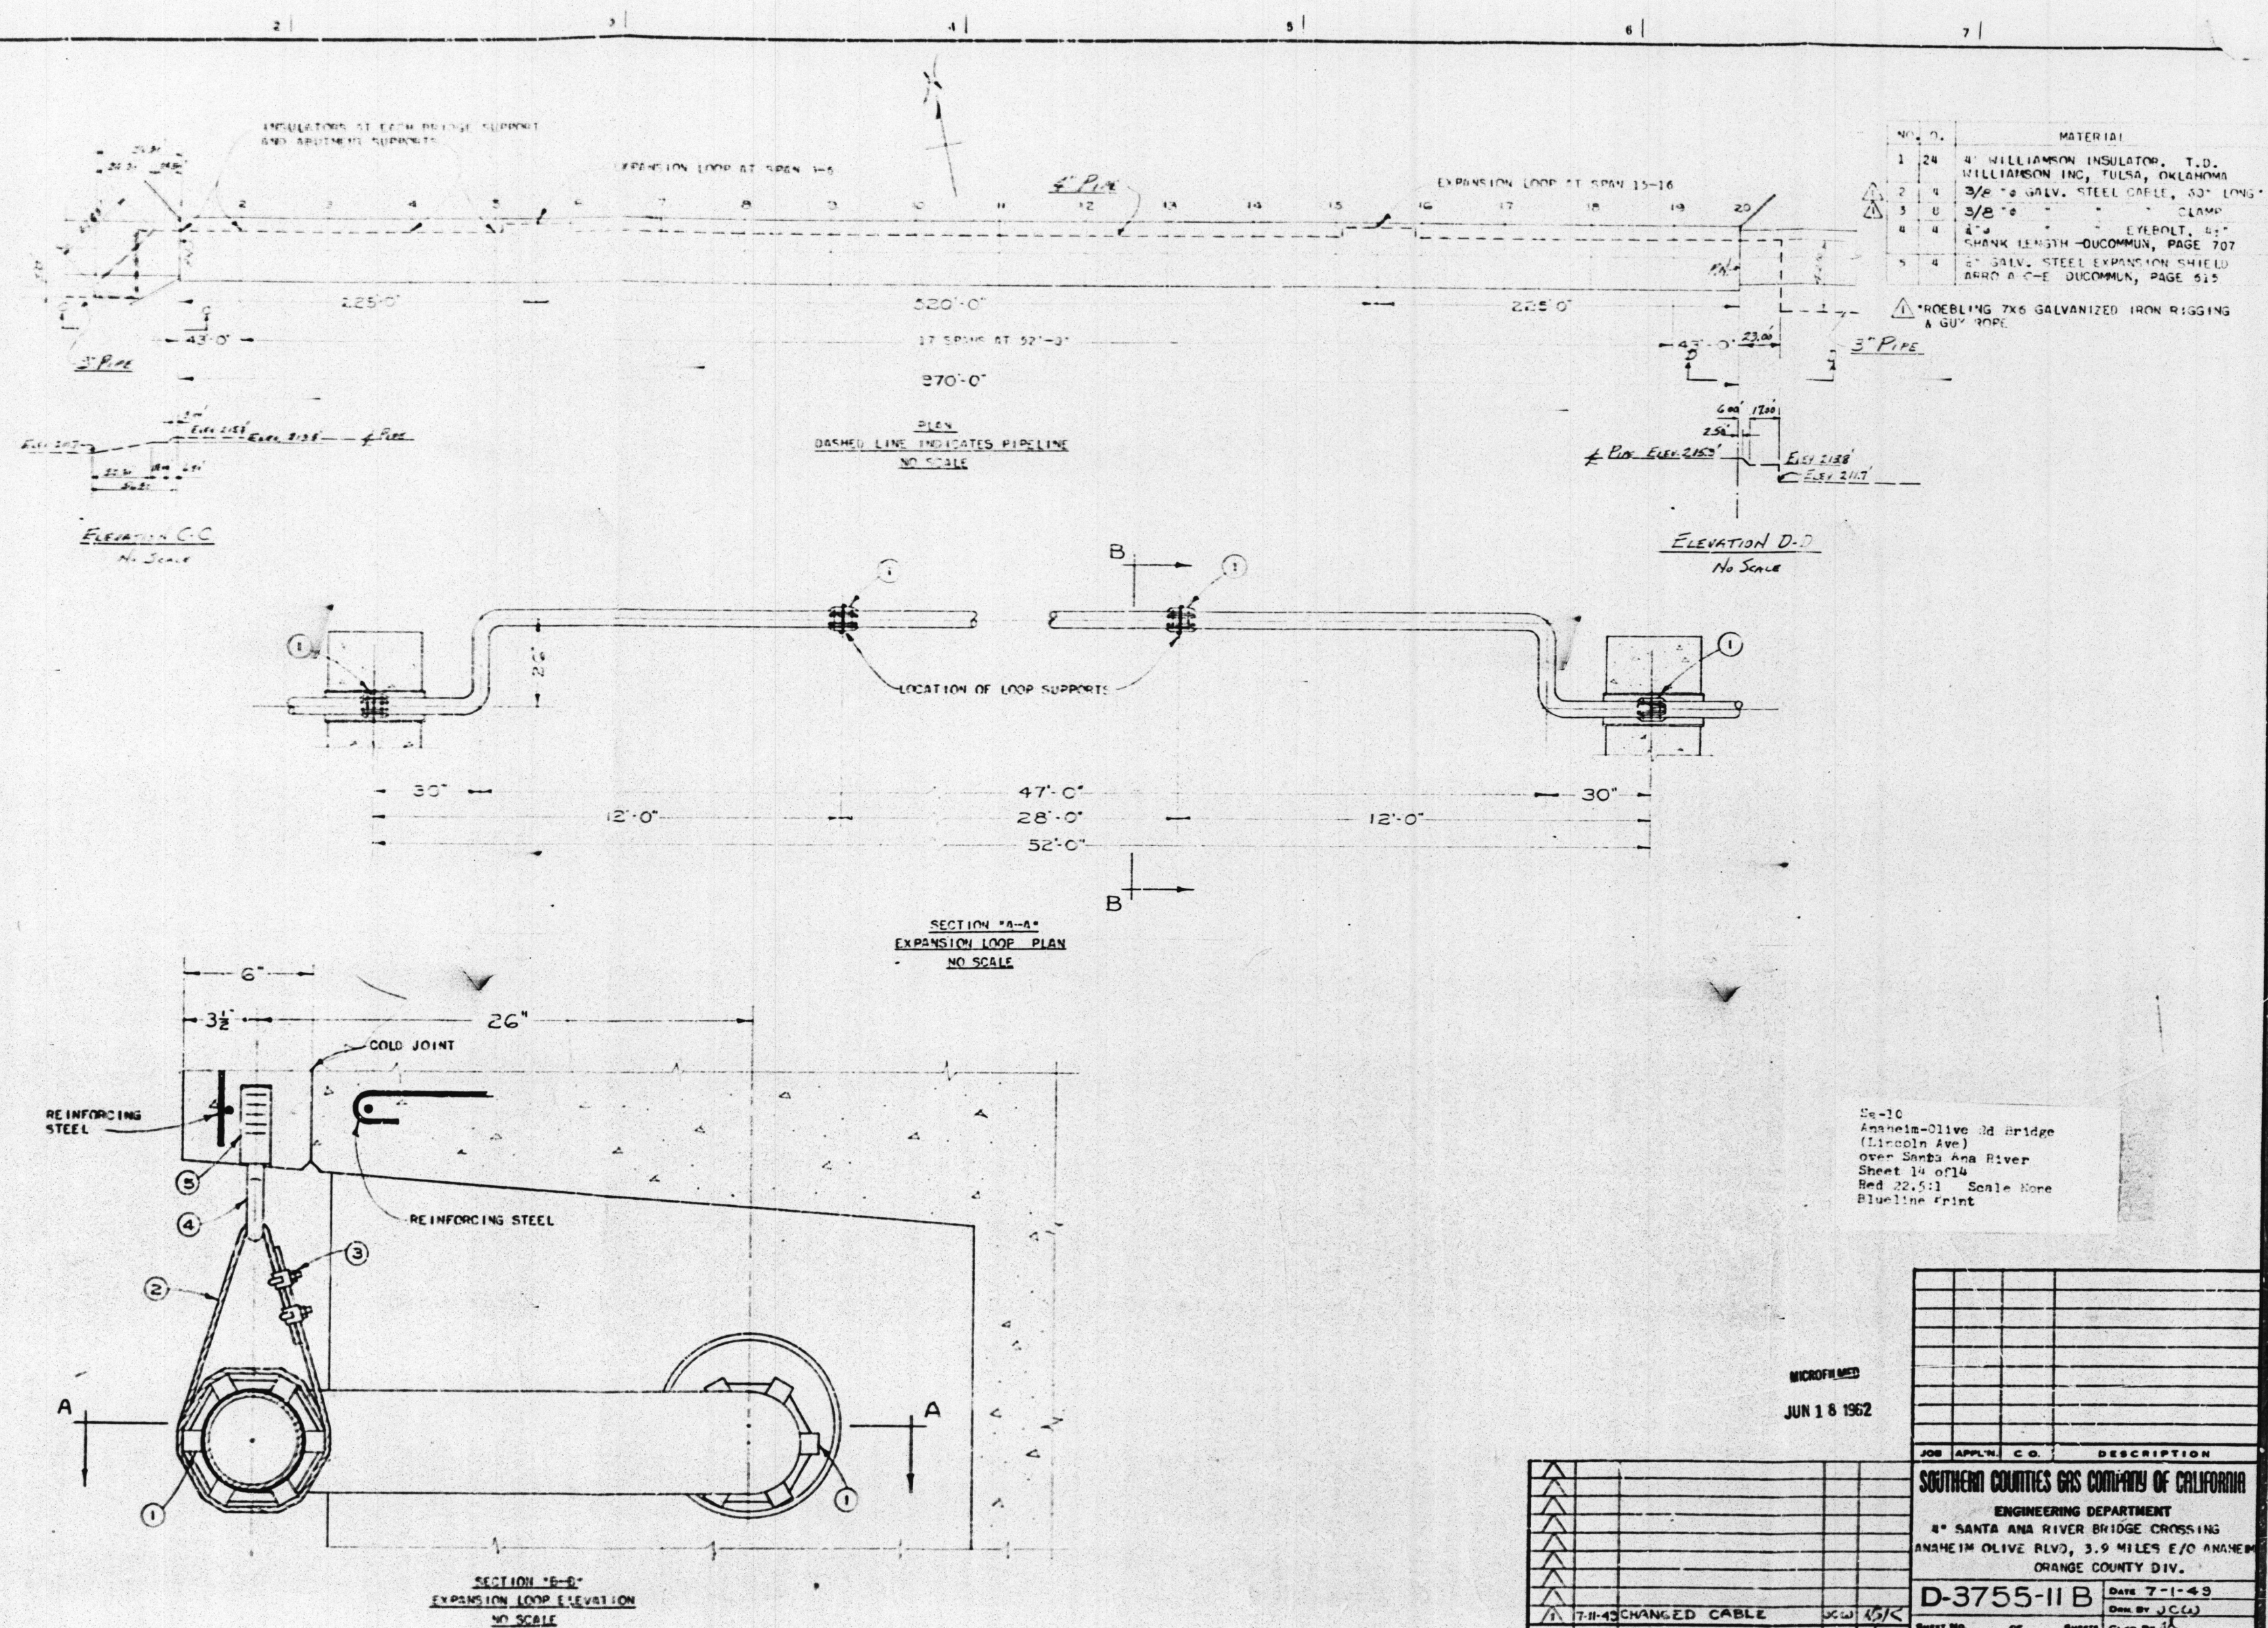

MICROFILMED
JUN 18 1962

JOB APPLN. C.O.		DESCRIPTION	
SOUTHERN COUNTIES GAS COMPANY OF CALIFORNIA		ENGINEERING DEPARTMENT	
4" SANTA ANA RIVER BRIDGE CROSSING		ANAHEIM OLIVE RD., 3.9 MILES E/O ANAHEIM	
ORANGE COUNTY DIV.		D-3755-II B	
DATE 7-1-49		Dwn. by J.C.C.	
7-11-49 CHANGED CABLE		J.C.C. 4/5/C	
MARK	DATE	REVISIONS	BY
			CHALLENGE
SHEET NO. OF SHEETS		Cwd. by J.C.C.	
APPROVED J.C.C.		Cwd. by J.C.C.	

SHT. 14 61 SA - 10

71DJ 2491