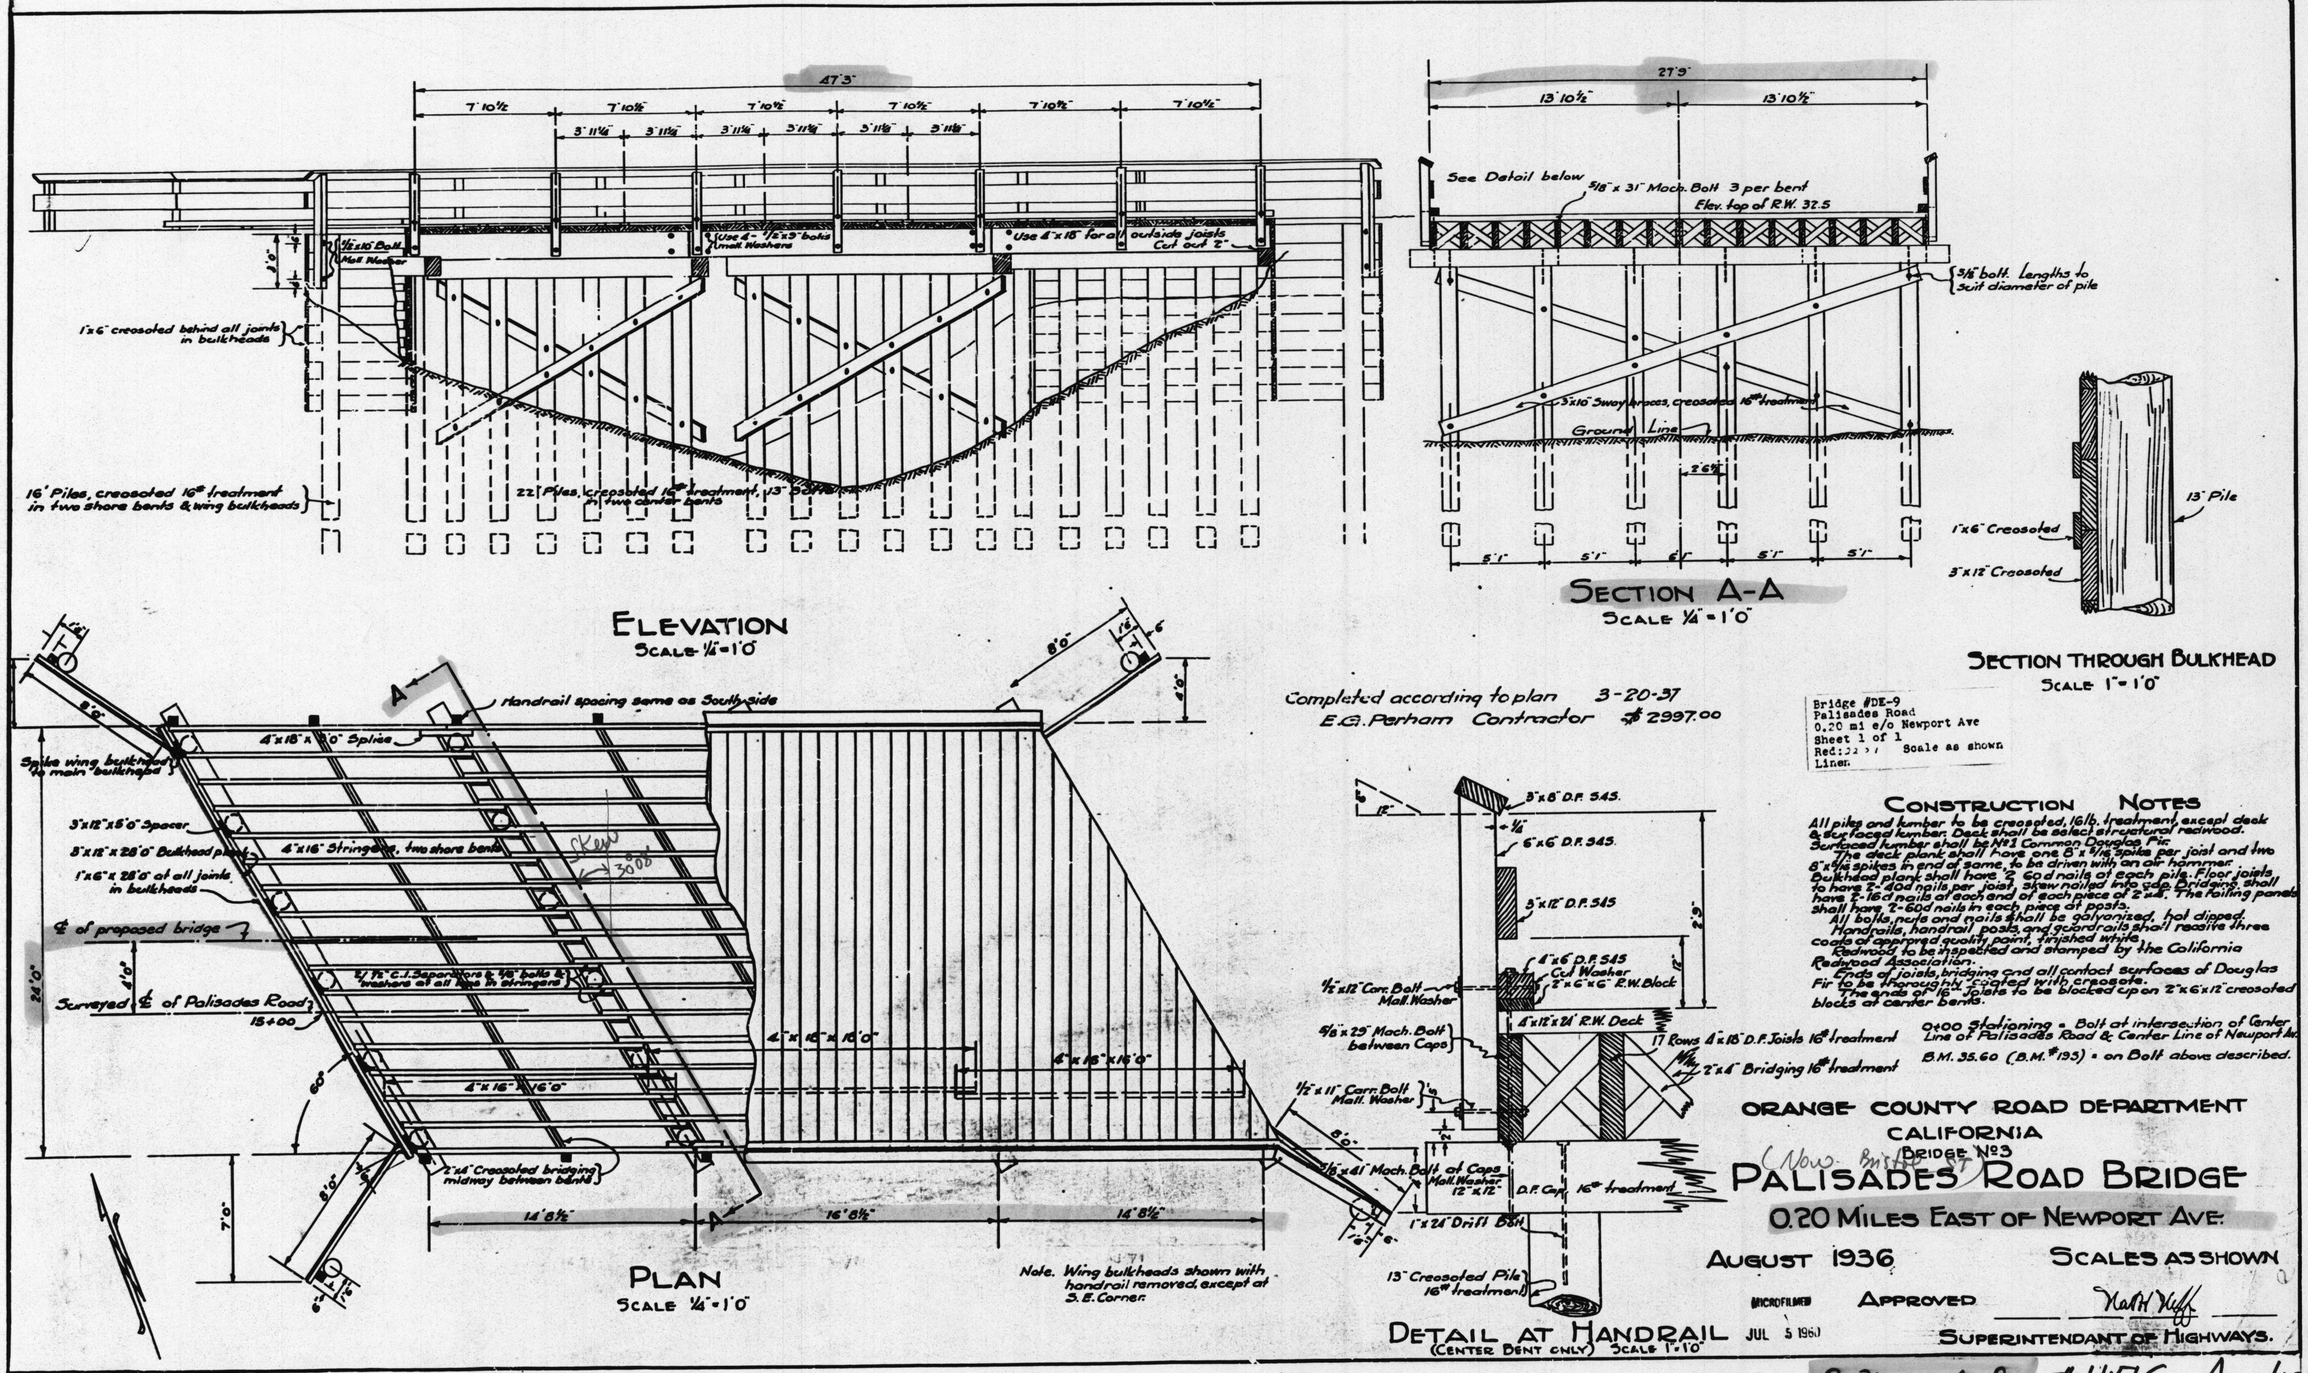

W = 24'0"
L = 47'3" 2@14'8½"
1@16'8½"
Skew: 30°08'

Now: BRISTOL ST. #14676 Aug/1936
(Now: Bristol) DE-9
PALISADES RD BR.
over DELHI CHANNEL
Th. 859-D6