S-1182(1)

SHEET 9 OF 13 SHEETS

VII CAL. 1182(1) 1952 2 6

W. B. Curro
DISTRICT ENGINEER

Reference
ROAD COMMISSIONER

June 16, 1952

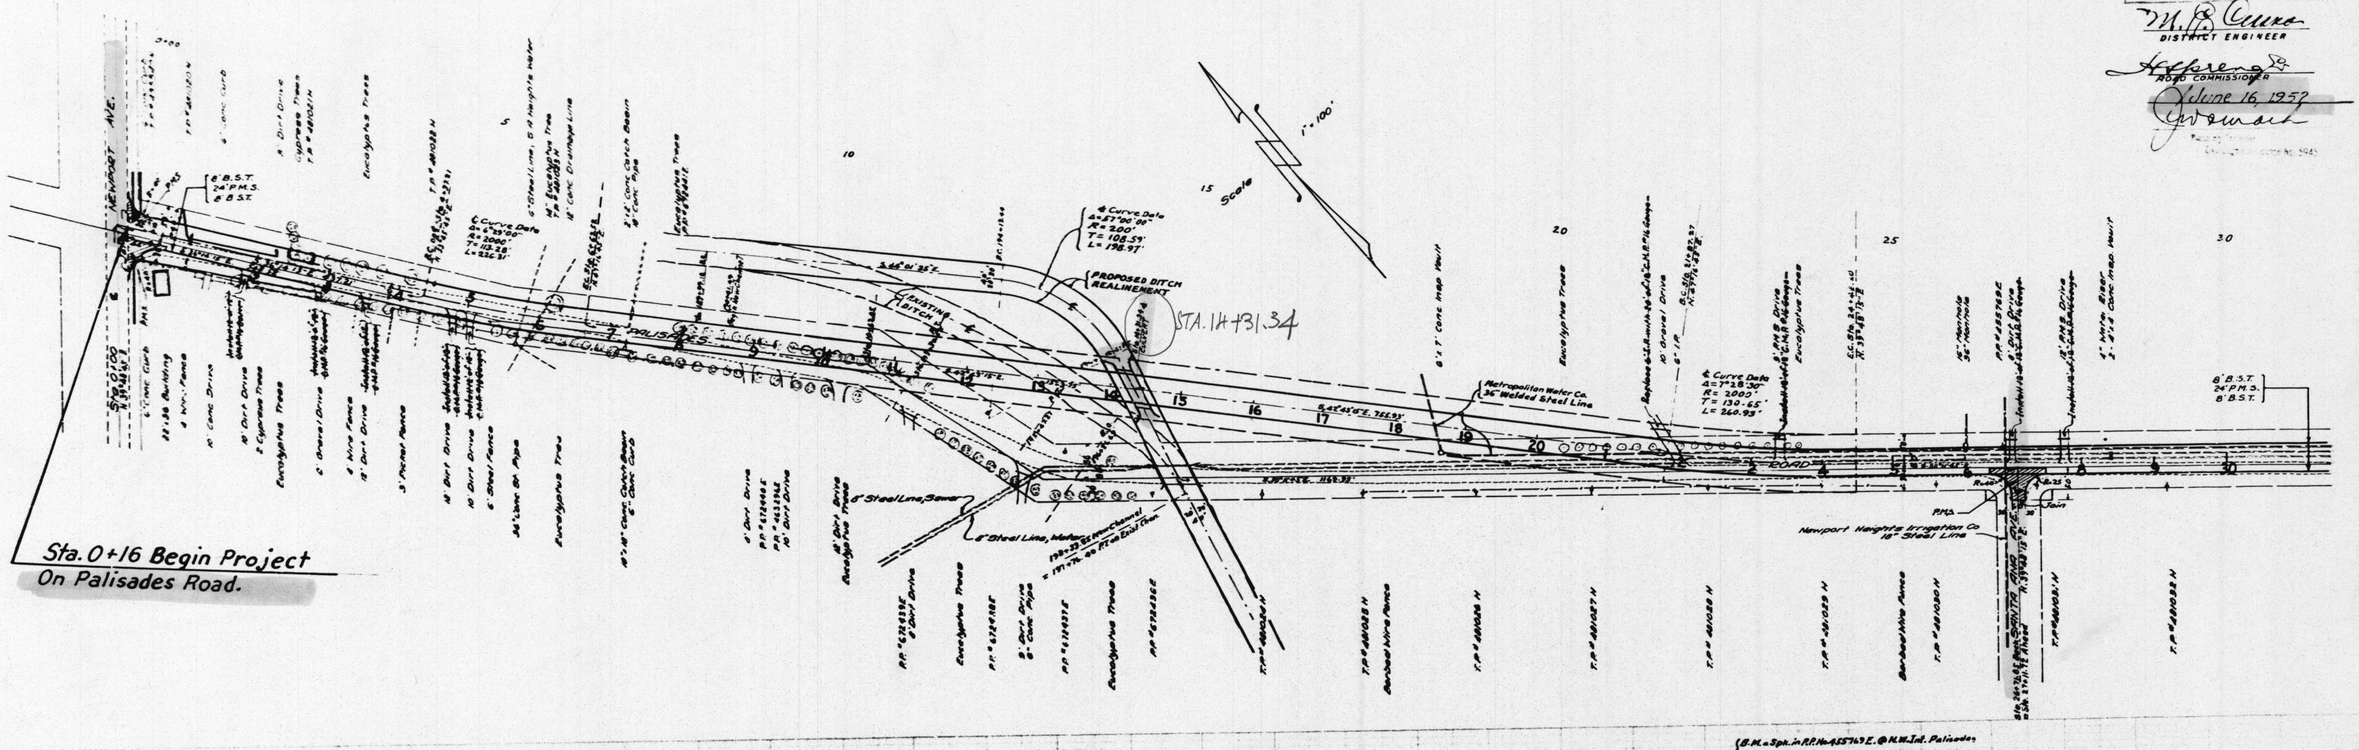

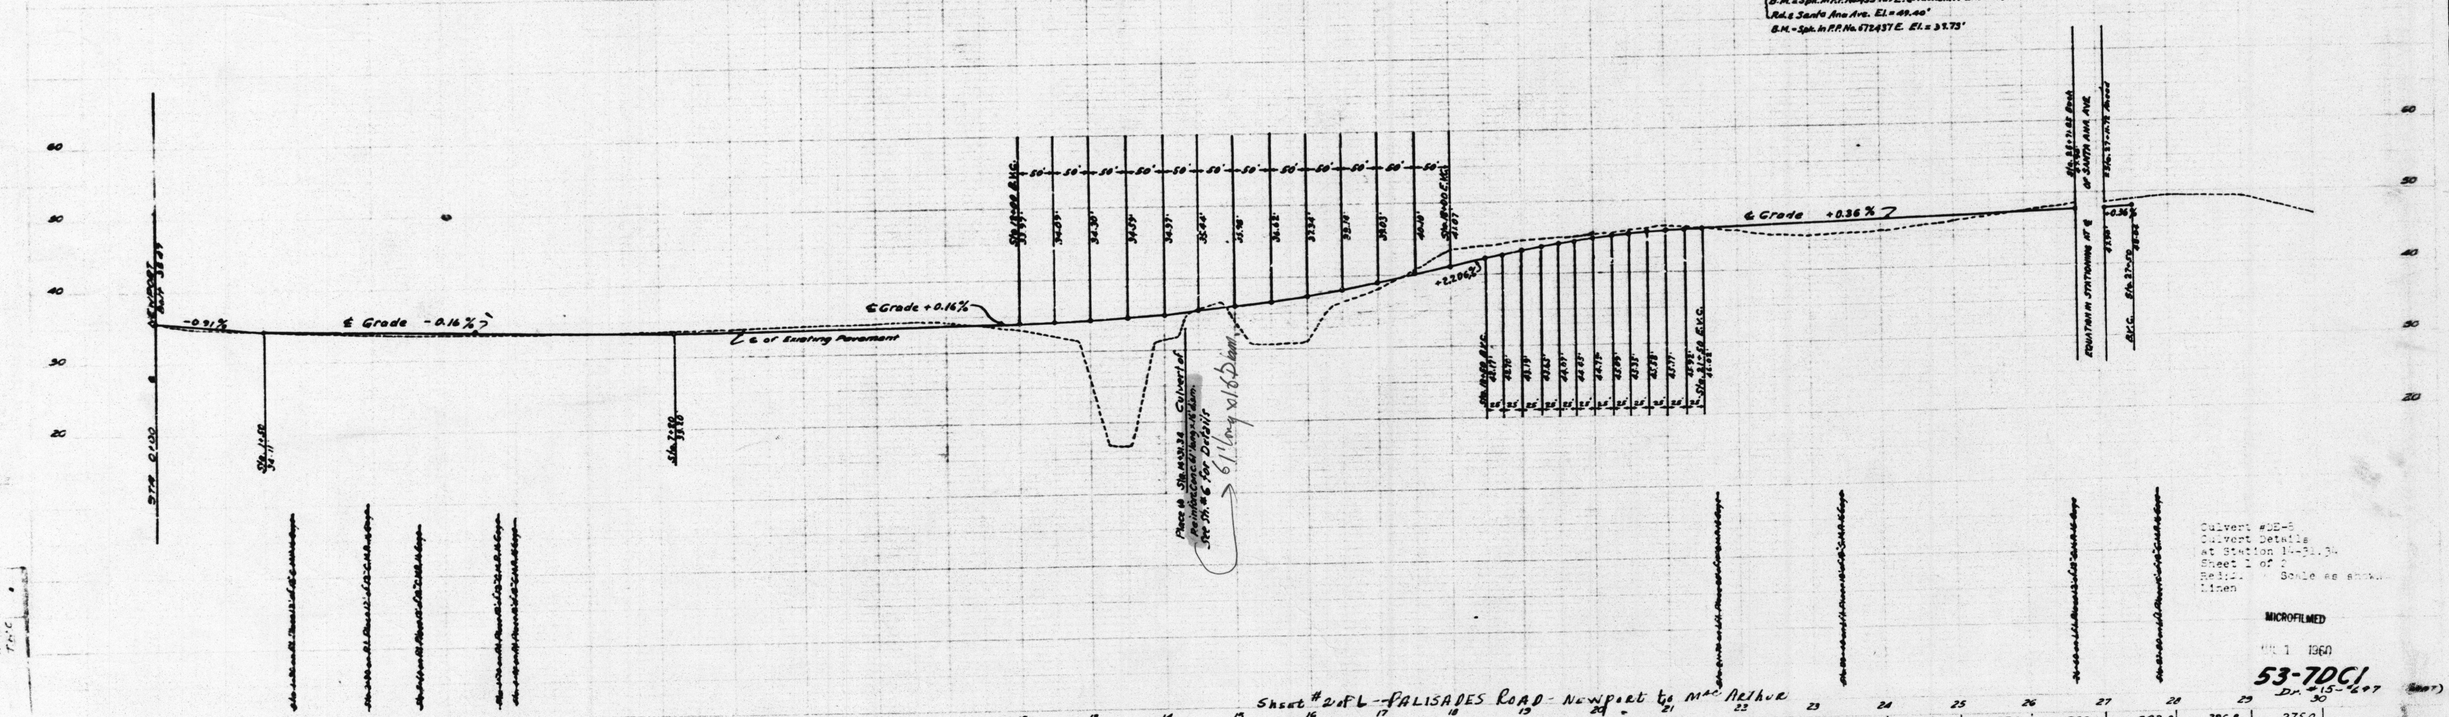

Culvert #DE-8
Culvert Details
At Station 14+31.34
Sheet 1 of 1
Reduced to Scale as shown
Linen

MICROFILMED
JUL 1 1960

53-7DC1
Dr. #15-297

Sheet #2 of L - PALISADES ROAD - Newport to Mac Arthur

	0	1	2	3	4	5	6	7	8	9	10	11	12	13	14	15	16	17	18	19	20	21	22	23	24	25	26	27	28	29	30
EXCAVATION CU YD		47.7	137.0	137.8	145.8	160.3	197.7	206.5	218.1	312.0	361.0	355.3	147.2	13.5	15.3	106.6	27.4	22.6	407.4	645.4	455.1	281.0	103.0	11.4	4.8	24.0	177.3	283.0	282.0	396.8	275.0
EMBANKMENT CU YD		0.8	2.0	4.8	2.0	0.5	2.4	0.9	0.9	0	0	0	17.1	238.5	494.2	302.0	920.0	410.5	29.6	0	0	16.7	44.4	101.8	181.4	109.1	22.2	0	0	0	0

Now: BRISTOL ST. # 14515 June/1952

(Now: Bristol St.) (DE-8)
PALISADES RD CULVERT Thom: 859-D7
(@ STA. 14+31.34)
(BetWEEN Newport Av. & SANTA ANA AV.)