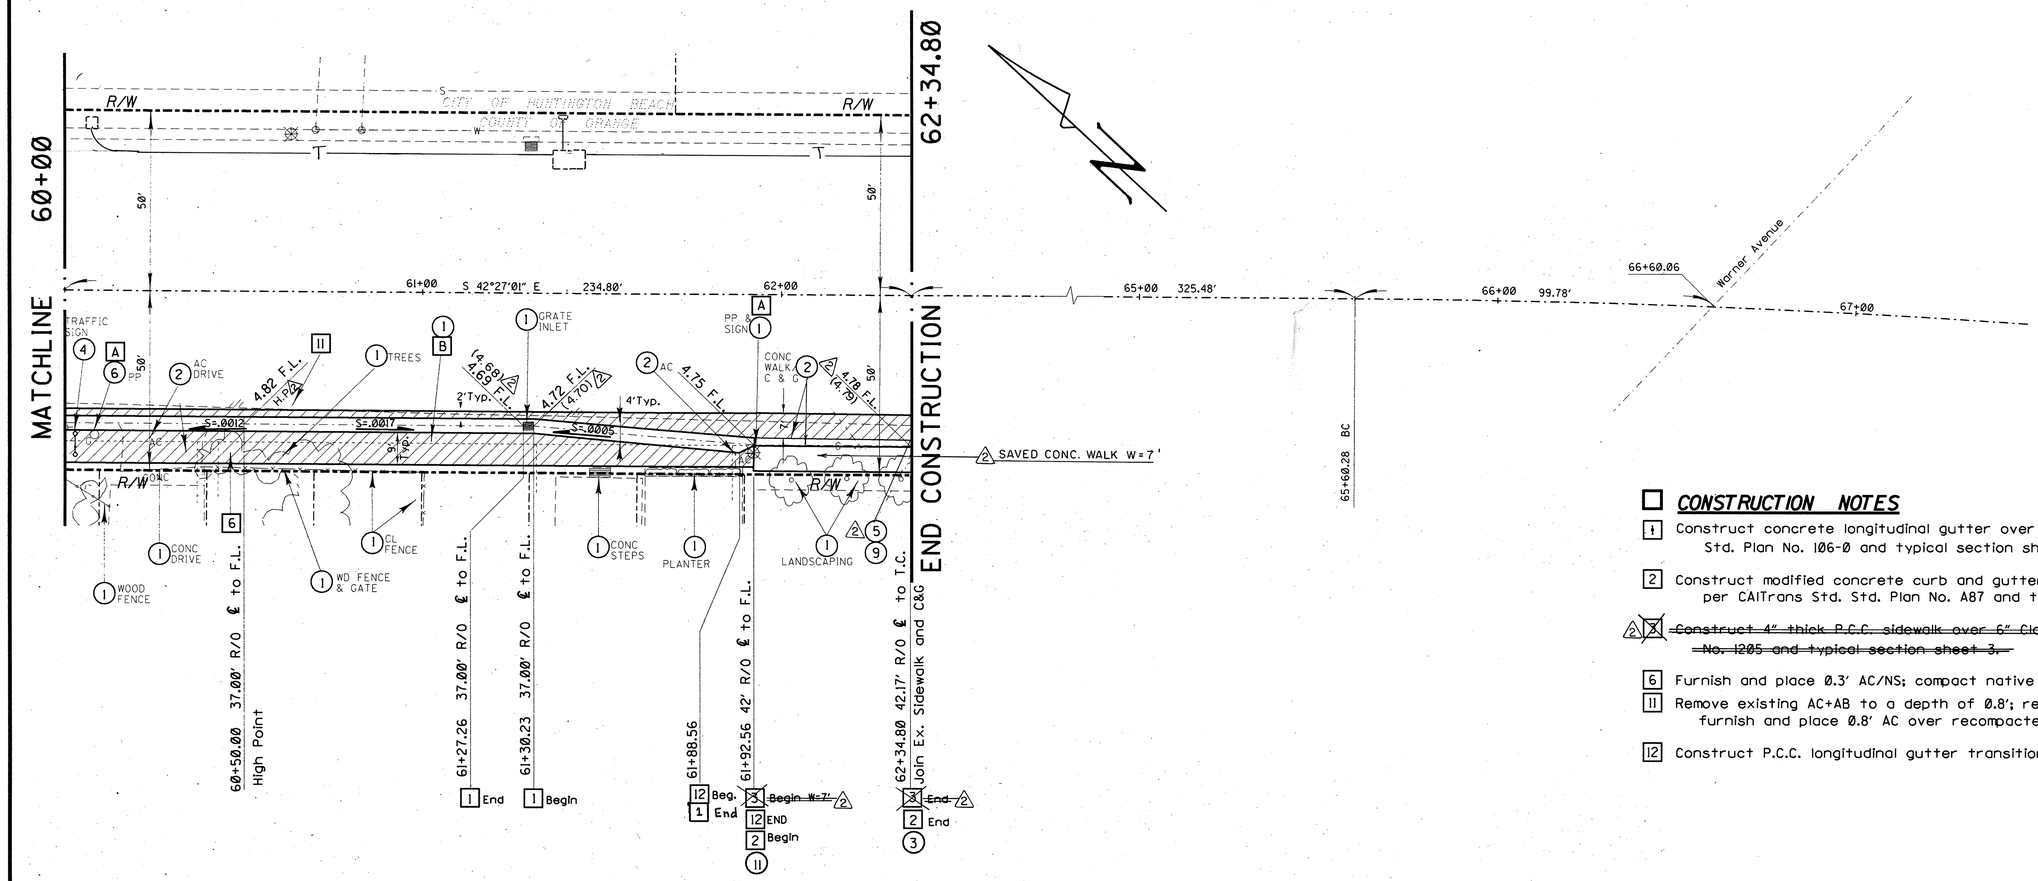

CONSTRUCTION NOTES

1. Construct concrete longitudinal gutter over 6" Class 2 A.B. per APWA Std. Plan No. 106-0 and typical section sheet 3.
2. Construct modified concrete curb and gutter (Type A2-8) over 6" Class 2 A.B. and per CAlTrans Std. Std. Plan No. A87 and typical section sheet 3.
2. ~~Construct 4" thick P.C.C. sidewalk over 6" Class 2 A.B. and per EMA Std. Plan No. 1205 and typical section sheet 3.~~
6. Furnish and place 0.3' AC/NS; compact native soil to 95% RC.
11. Remove existing AC+AB to a depth of 0.8'; recompact AB to 95% R.C. and furnish and place 0.8' AC over recompacted AB or 95% R.C. Native Soil.
12. Construct P.C.C. longitudinal gutter transition per detail sheet 7.

LEGEND

1. Protect in place
2. Remove
3. Join and match exist. flowline
4. Relocate per plan
5. Sawcut
6. To be relocated by others
7. Remove interfering portions
8. Match existing to drain to street
9. Match existing
10. Adjust to grade
11. Adjust height of prop. curbface as required to match elevation of existing sidewalk/access ramp or driveway.
12. Feather A.C. to match T.C.
13. Place concrete to fill gap per sidewalk standards.
14. Adjust to grade by others
15. Match curve of exist. curb return

UTILITIES	OWNER
A Power Poles/Lines	Southern Calif. Edison Co.
B Gas Line	The Gas Company
C Telephone Line	General Telephone
D Cable TV Line	Paragon Cable
E Water Line	City of Huntington Beach
F Sewer Line	City of Huntington Beach

A.C. PLACEMENT LIMITS

RECORD DRAWING

1 ½ 0 1 2
3 inches on original drawing

PLAN
1"=20'

BENCH MARK: IJ 59 83

Set in the So. part of the intersection of Anderson St. and N. Pacific Ave.; 18' S/W'ly. of the centerline of Pacific Ave.; 53' S/E'ly of the centerline of Anderson St.; 0.5' N/W'ly. of the S/E'ly. BCR; set in the top of a conc. post, and level with the top of the curb.

Elev. 8.91 Adj. 1976

MARK	DATE	DESCRIPTION
2	5-02	RECORD DRAWINGS.

REVISIONS

PREPARED UNDER RESPONSIBLE CHARGE OF: REGISTERED PROFESSIONAL ENGINEER
EDWARD KWAN No. 25,639 Civil STATE OF CALIFORNIA
Edward Kwan 5-12/31/97
Edward Kwan RCE 25639 DATE

ORANGE COUNTY ENVIRONMENTAL MANAGEMENT AGENCY

PACIFIC COAST HWY. IMPROVEMENTS

PLAN

STA. 60+00 to STA. 62+34.80

DESIGNED A. BRINE
DRAWN SC CHECKED TM
SCALE AS SHOWN DATE APR 1994 DRAWING NO.
SHEET 12 OF 12