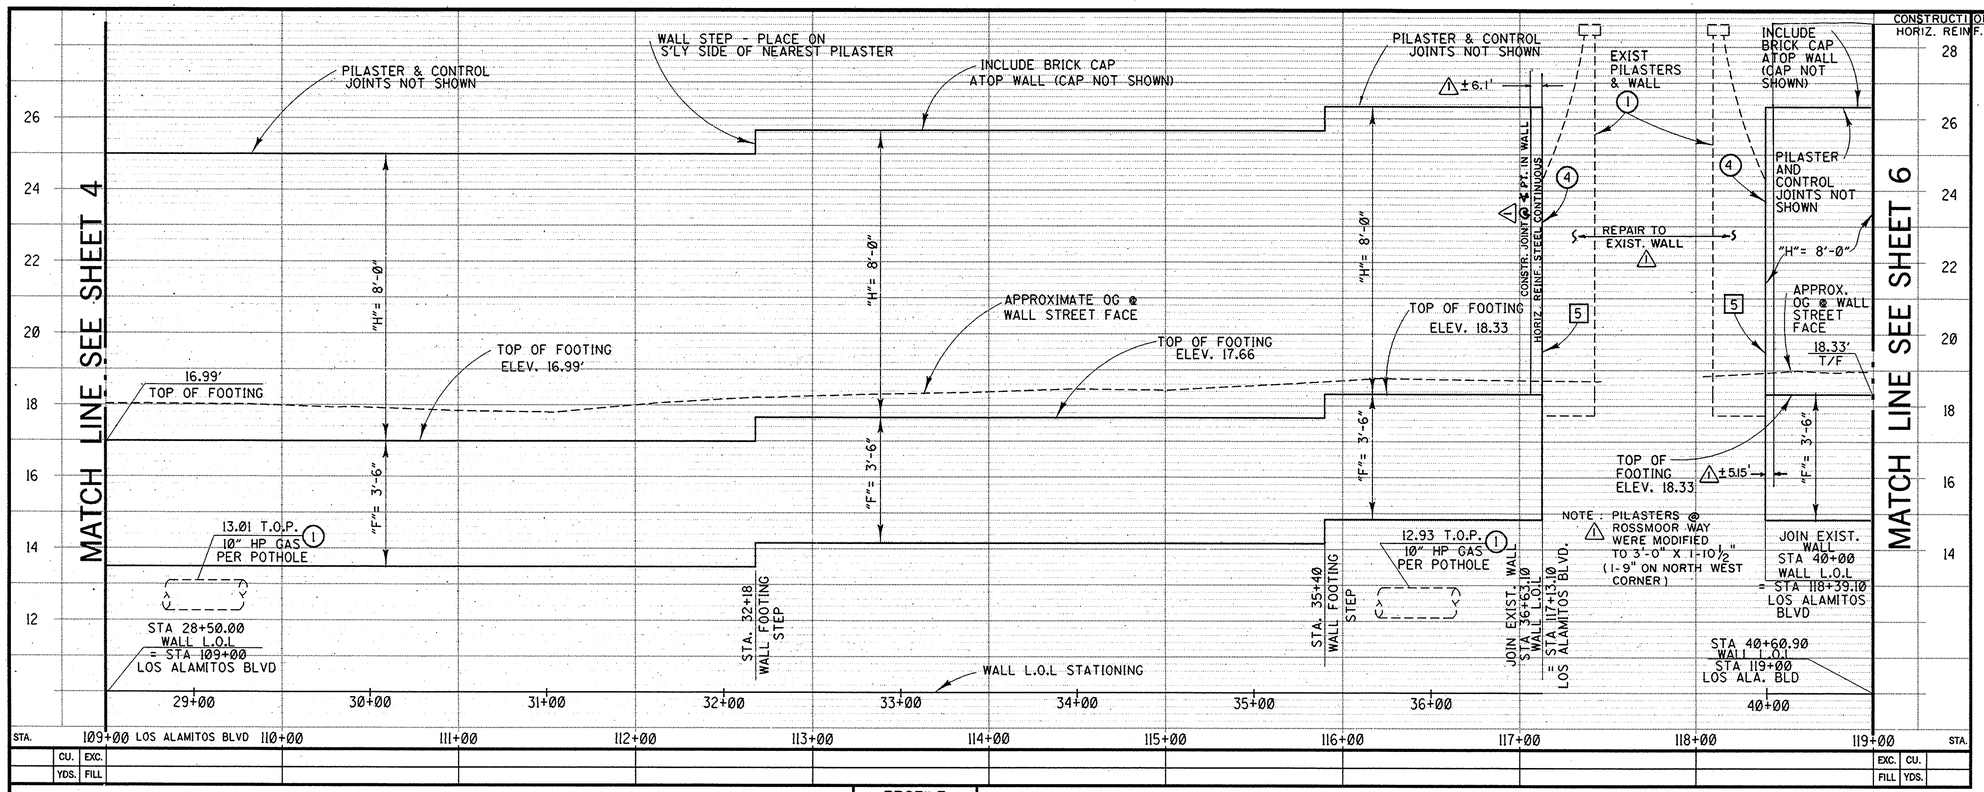

PROFILE
HORIZ. 1"= 40'
VERT. 1"= 2'

CONSTRUCTION NOTES

1. CONSTRUCT CONCRETE MASONRY BLOCK/RED BRICK VENEER WALL PER MODIFIED APWA STD. PLAN 601-0, TYPE 3, AND PLANS, DETAILS AND SPECIAL PROVISIONS.
2. INSTALL TEMPORARY SECURITY FENCE PER PLAN, DETAILS AND SPECIAL PROVISIONS.
3. CONSTRUCT PCC SIDEWALK, WIDTH AND LIMITS PER PLAN & PFRD STANDARD PLAN 1205 AND DETAILS SHEET 9.
5. DRILL AND BOND DOWELS PER DETAILS AND SPECIAL PROVISIONS.

NOTE:

CONTRACTOR SHALL LIMIT HIS WORK ACTIVITIES TO THE GREATEST EXTENT POSSIBLE WITHIN THE RIGHT OF ENTRY AREA DELINEATED BY THE TEMPORARY SECURITY FENCE. CONTRACTOR IS TO REPLACE OR REPAIR ANY RESIDENT IMPROVEMENTS DAMAGED BY HIS OPERATIONS, AT HIS SOLE COST, TO THE SATISFACTION OF THE ENGINEER.

UTILITIES

- A SOUTHERN CALIFORNIA EDISON
- B TIME WARNER COMMUNICATIONS.
- C SOUTHERN CALIFORNIA WATER COMPANY
- D SOUTHERN CALIFORNIA GAS
- E ORANGE COUNTY SANITATION DISTRICT
- F CITY OF LOS ALAMITOS
- H COMCAST CABLEVISION
- I GTE CALIFORNIA

LEGEND

- (1) PROTECT IN PLACE
- (2) REMOVE
- (4) SAWCUT/ JOIN
- (7) REMOVE INTERFERING PORTIONS
- (11) REMOVE AND SALVAGE

NOTE: NOT ALL STREET UTILITIES PLOTTED.

CAUTION: *EXIST 10" HIGH PRESSURE GAS IS LOCATED WITHIN ONE FOOT OF TRENCH FOOTING. CONTRACTOR TO LOCATE LINE PRIOR TO CONSTRUCTION ACTIVITIES.*

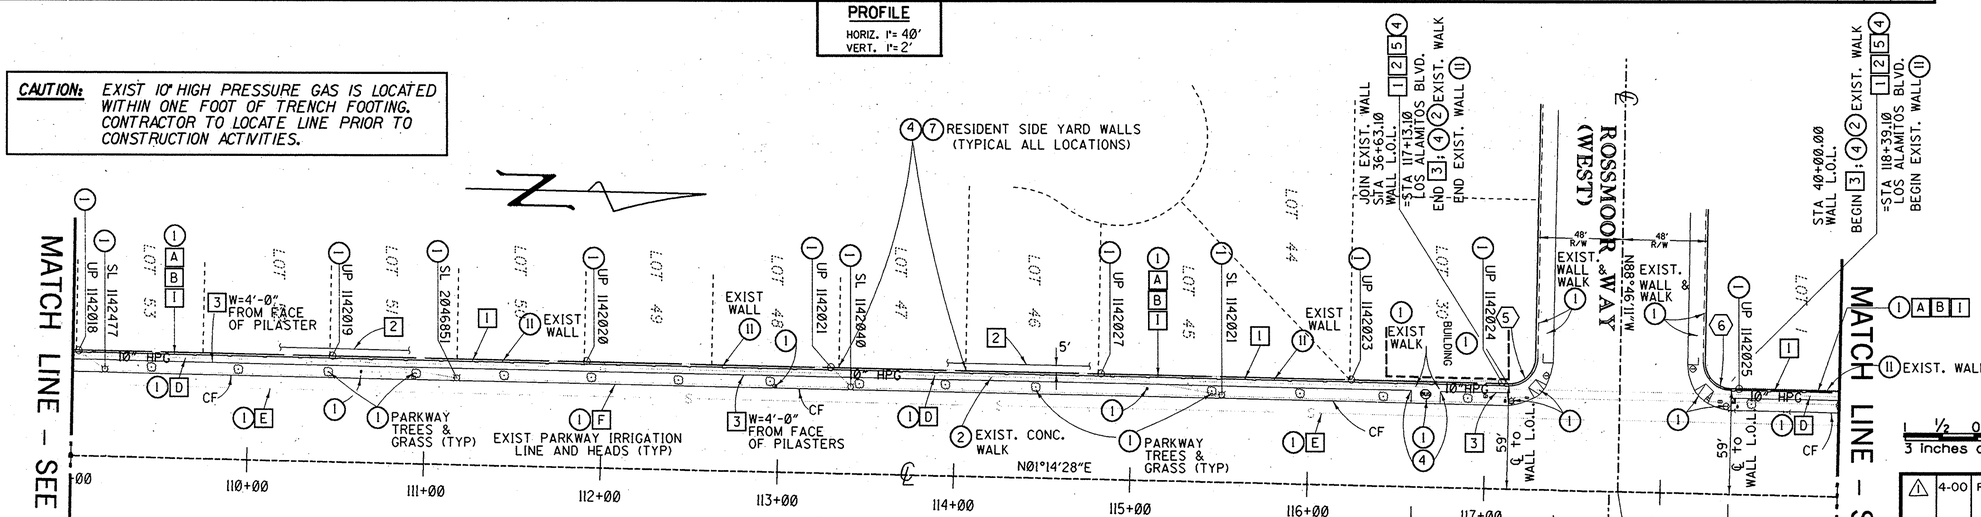

CURVE DATA			
	R	△	L
(5)	15.00'	90°00'00"	23.56'
(6)	15.00'	90°00'00"	23.56'

ABBREVIATION KEY

UP = UTILITY POLE
SL = STREET LIGHT
G = GAS
E = ELECTRIC
CF = CURB FACE
CTV = CABLE TV
SD = STORM DRAIN
S = SEWER
HPG = HIGH PRESSURE GAS

NOTE: EXISTING RESIDENT BACKYARD IMPROVEMENTS NOT SHOWN.

PLAN
1"= 40'

½ 0 1 2
3 inches on original drawing

MARK	DATE	DESCRIPTION
1	4-00	RECORD DRAWINGS

REVISIONS

PREPARED UNDER RESPONSIBLE CHARGE OF:
REGISTERED CIVIL ENGINEER — TEDDORE C. RIGONI — No. C 48526 — Exp. 6-30-00 — STATE OF CALIFORNIA
TED RIGONI — 3/16/98 — DATE

ORANGE COUNTY
PUBLIC FACILITIES & RESOURCES DEPARTMENT

ROSSMOOR SIGNATURE WALL

PLAN AND PROFILE

DESIGNED T. RIGONI
DRAWN A. POPAL
CHECKED E. KWAN
SCALE AS SHOWN
DATE
DRAWING NO. ER02792
SHEET 5 OF 12

File Name: $DGN-FILE-NAME$
Date Plotted: 13-MAR-1998 13:40