Access Compliance Report - Public Rights-of-Way
(Corridor: Sidewalk & Intersection Items)

Corridor ID: KEMPTON_LN_001

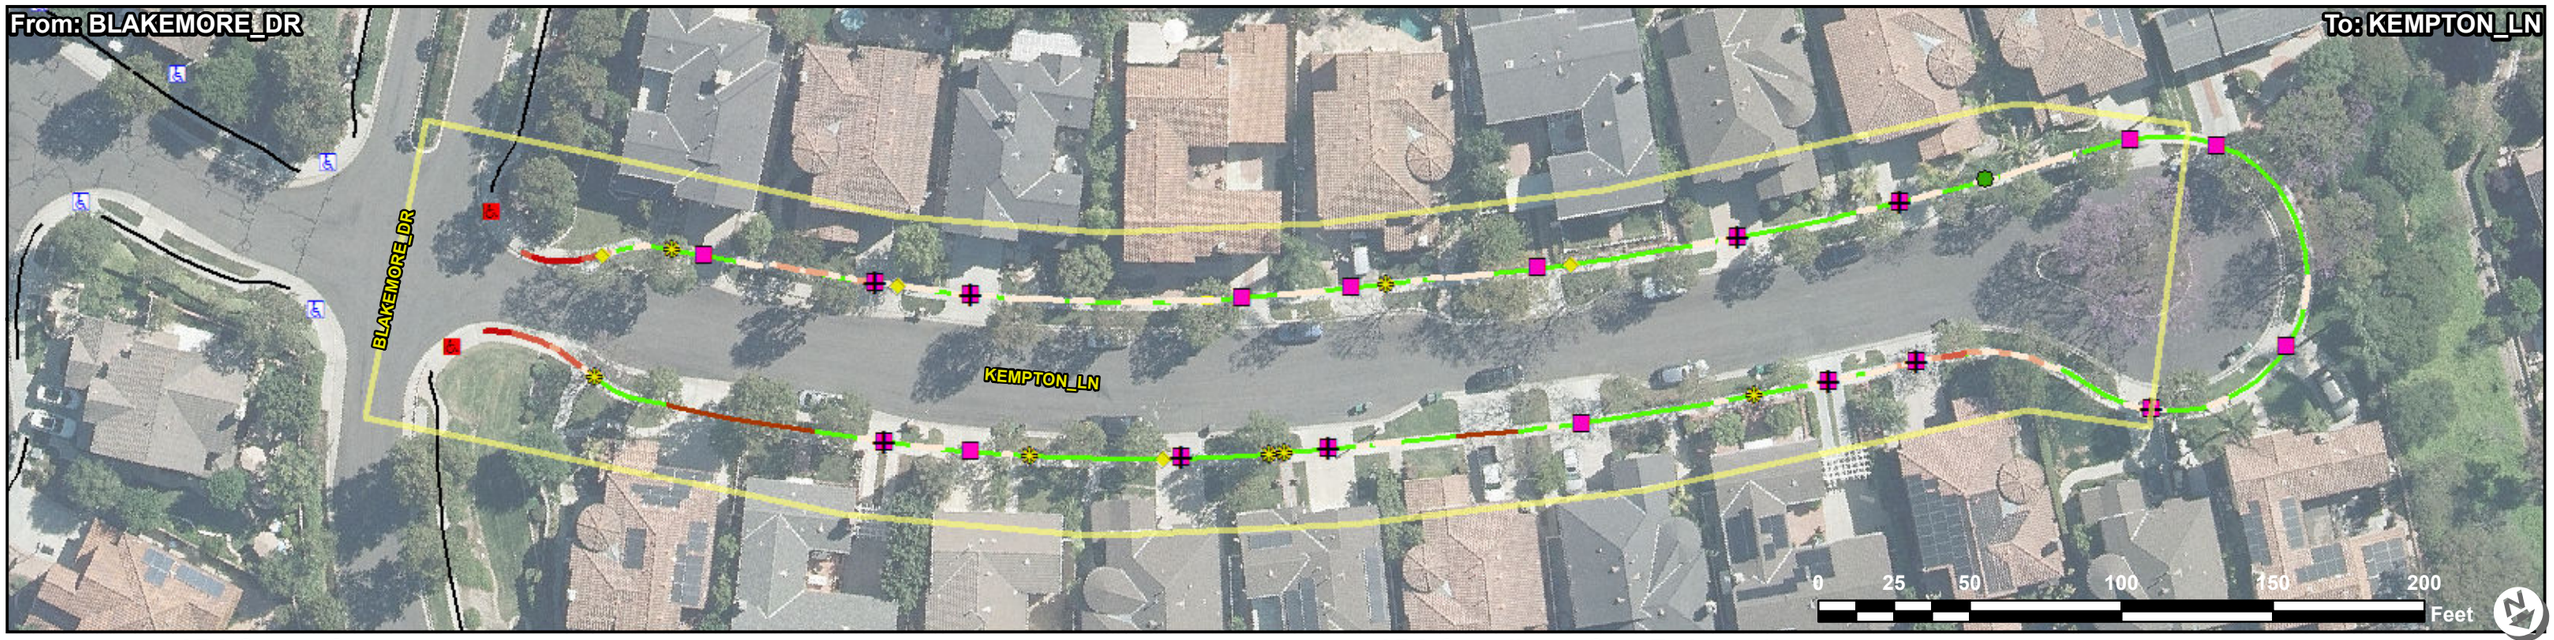

ADA Survey Summary

Item	Description	Quantity	Inventory Symbology
1	Vertical Displacement <= 1"	11	EA
2	Vertical Displacement > 1"	0	EA
3	Uneven Vertical Displacement	0	EA
4	Horizontal Opening > 0.5"	1	EA
5	Poor Surface Condition	1	SY
6	Utility Obstruction	0	EA
7	Power Pole Obstruction	0	EA
8	Traffic Signal Obstruction	0	EA
9	Sign Obstruction	0	EA
10	Low Vegetative Obstruction	0	EA
11	Overhead Vegetative Obstruction	1	EA
12	Other Obstruction*	0	EA
13	Miscellaneous Obstruction	0	EA
14	Temp/Private Obstruction	0	EA
15	Commercial Driveway	0	LF
16	Residential Driveway	284	LF
17	Total Sidewalk Length Assessed	1184	LF
18	Average Sidewalk Width	48	IN
19	Curb Ramps In Corridor	2	EA
20	Island Curb Cuts In Corridor	0	EA
21	Signal Push Buttons In Corridor	0	EA
22	Accessible Parking Spaces In Corridor	0	EA
23	Missing Sidewalk/Gaps in Connectivity	0	LF
24	Buried/Narrow Sidewalk	0	LF
25	Sidewalk Not Surveyed	70	LF
26	No Sidewalk Observed	0	LF
27	Corridor Severity Score	50.93	

Running Slope
(Aligned, Not Costed)
- 5.1 – 8.3%
- 8.4 – 10.0%
- 10.1 – 12.5%
- 12.5%+

Collection in Adjacent Corridors
- Curb Ramps
- Island Curb Cuts
- Signal Push Buttons
- Sidewalk Collection

Google Street View Link

http://www.google.com/maps/@?api=1&map_action=pano&viewpoint=33.56925339,-117.63253655

ADA Compliance Cost Estimate **

Item	Description	Quantity	Unit	Unit Price	Item Cost
1	Vertical Displacement <= 1"	7	EA	$150.00	$ 1050.00
2	Vertical Displacement > 1"	0	EA	$2125.00	$ 0.00
3	Uneven Vertical Displacement	0	EA	$2125.00	$ 0.00
4	Horizontal Opening > 0.5"	0	EA	$1062.00	$ 0.00
5	Poor Surface Condition	0	SY	$255.50	$ 0.00
6	Utility Obstruction	0	EA	$5000.00	$ 0.00
7	Power Pole Obstruction	0	EA	$20000.00	$ 0.00
8	Traffic Signal Obstruction	0	EA	$5000.00	$ 0.00
9	Sign Obstruction	0	EA	$2000.00	$ 0.00
10	Low Vegetative Obstruction	0	EA	$200.00	$ 0.00
11	Overhead Vegetative Obstruction	1	EA	$400.00	$ 400.00
12	Other Obstruction*	0	EA	$2000.00	$ 0.00
13	Miscellaneous Obstruction	0	EA	$2000.00	$ 0.00
14	Commercial Driveway	0	LF	$118.00	$ 0.00
15	Residential Driveway	152	LF	$118.00	$ 17974.00
16	Running Slope Violation	0	SY	$255.50	$ 0.00
17	Cross Slope Violation	157	SY	$255.50	$ 40286.00
18	Running and Cross Slope violations	0	SY	$255.50	$ 0.00
19	Non-Compliant Curb Ramps and Total Cost*	2	EA	VARIES	$ 8000.00
20	Non-Compliant Island Curb Cuts and Total Cost*	0	EA	VARIES	$ 0.00
21	Non-Compliant Signal Push Buttons Cuts and Total Cost*	0	EA	VARIES	$ 0.00
22	Non-Compliant Accessible Parking Spaces and Total Cost*	0	EA	VARIES	$ 0.00
23	Missing Sidewalk/Gap in Connectivity	0	SY	$150.00	$ 0.00
24	Buried/Narrow Sidewalk	0	SY	$255.50	$ 0.00
				Total:	$ $67,711.00

Compliance Symbology
- Compliant Curb Ramp
- Non-Compliant Curb Ramp
- Compliant Island Curb Cut
- Non-Compliant Island Curb Cut
- Compliant Signal
- Non-Compliant Signal

Cross Slope
- 2.01 - 3.0%
- 3.01 - 4.0%
- 4.01 - 5.0%
- 5.01%+

Running Slope
(Deviated, Costed)
- 5.1 – 8.3%
- 8.4 – 10.0%
- 10.1 – 12.5%
- 12.5%+

*Note: Some items combined for display. See Unit Cost Table for specific unit costs for each type of obstruction, curb ramp, island curb cut. Missing sidewalk/gaps in connectivity reported together in compliance report and are separate in the GIS layers."

**Note: ADA pedestrian issues have been identified and quantified in the ADA Survey Summary. There are instances where multiple issues can be resolved with a single corrective measure. The ADA Compliance Cost Estimate reflects the best estimation of quantities and cost to resolve all identified ADA issues.